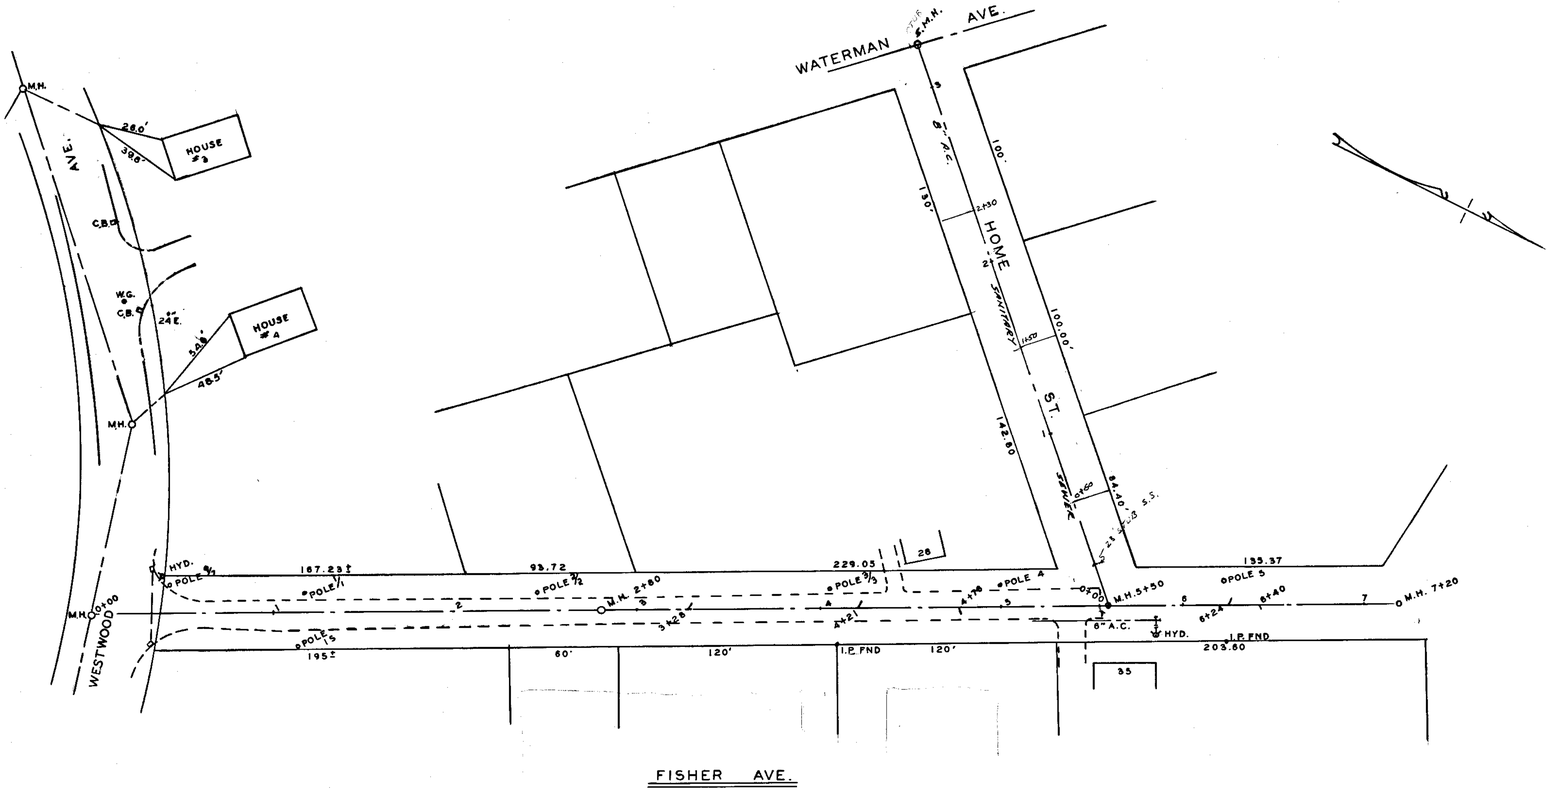

PLAN & PROFILE
OF
SANITARY SEWER
FISHER AVE. & HOME ST.
EAST LONGMEADOW MASS.
SCALE: 1" = 40' HOR. 1" = 4' VERT. JUNE 1969
A.A. MELIEN ENG'R.

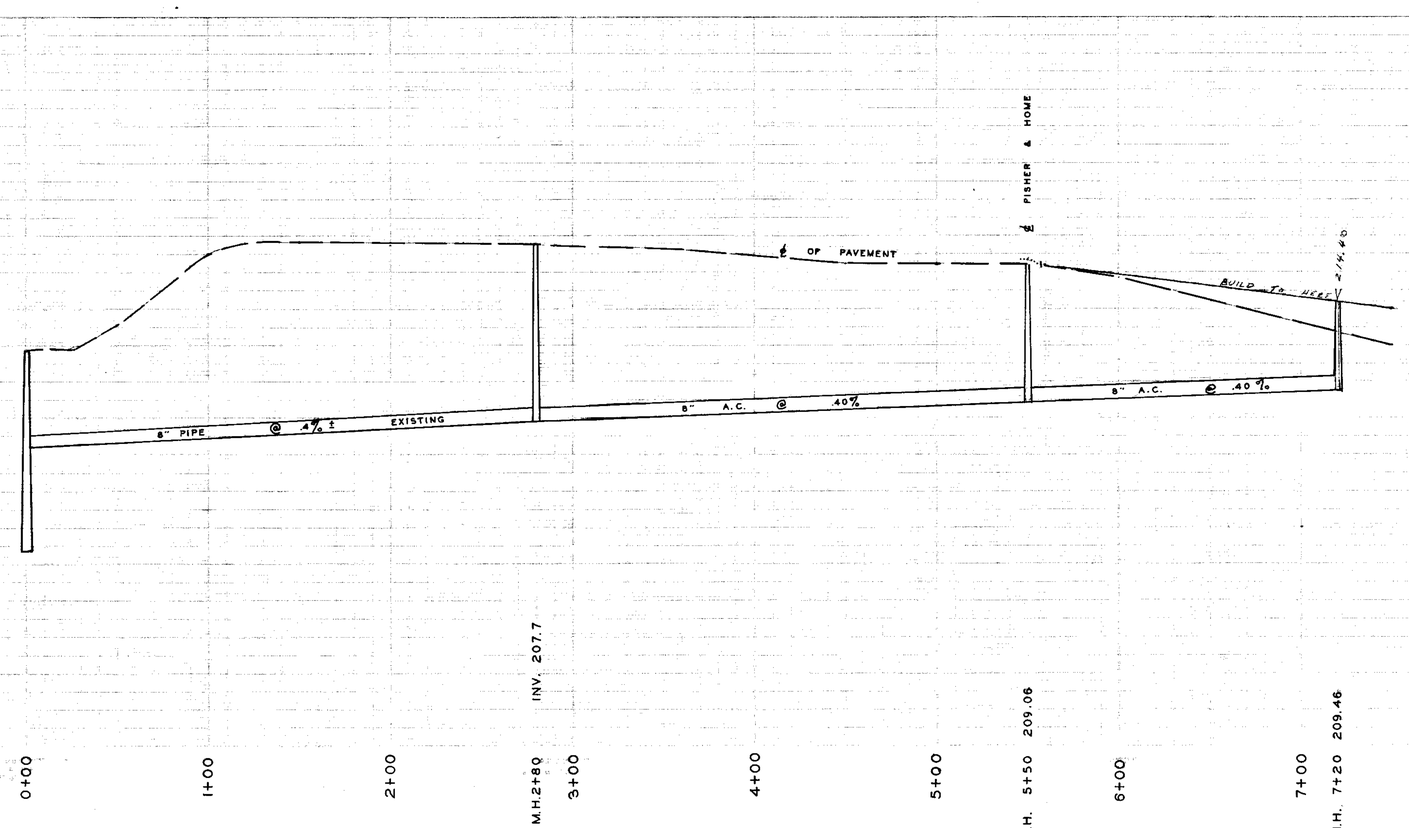

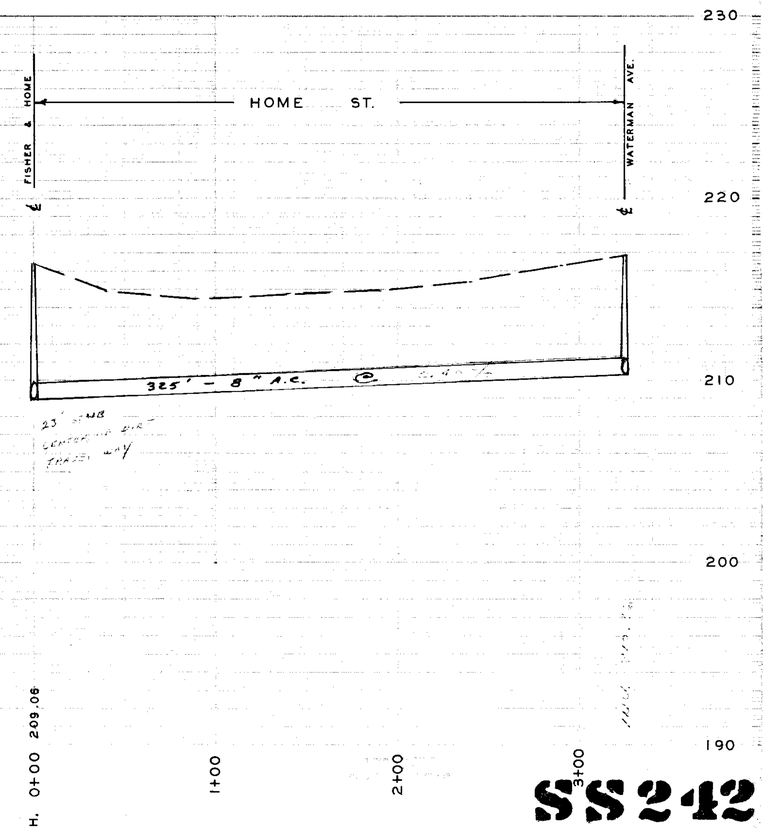

SS 242