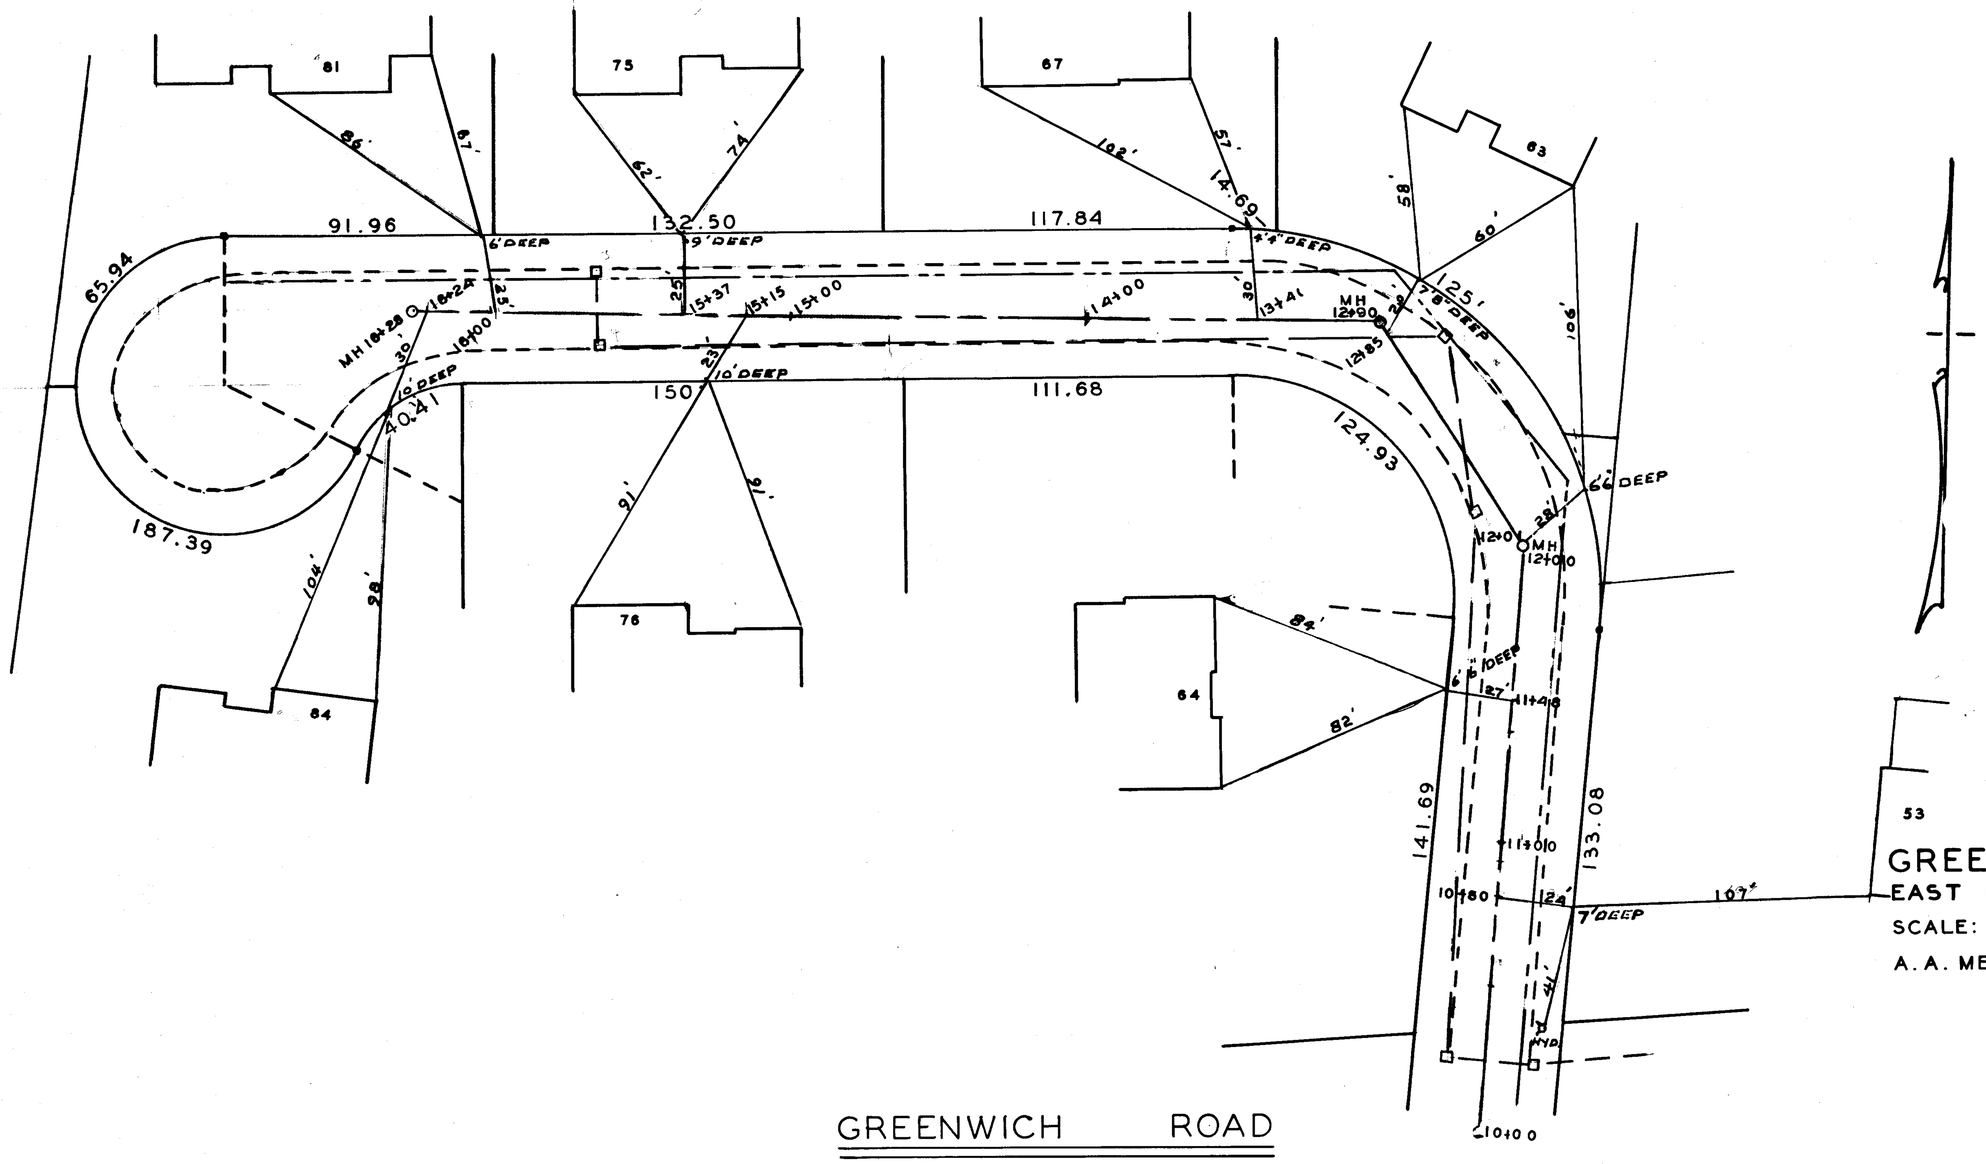

53 PLAN & PROFILE OF

GREENWICH ROAD

EAST LONGMEADOW MASS.

SCALE: 1" = 40' HOR.
1" = 4' VERT.

1969

A. A. MELIEN ENG'R.

GREENWICH ROAD

SHEET 2 OF 2

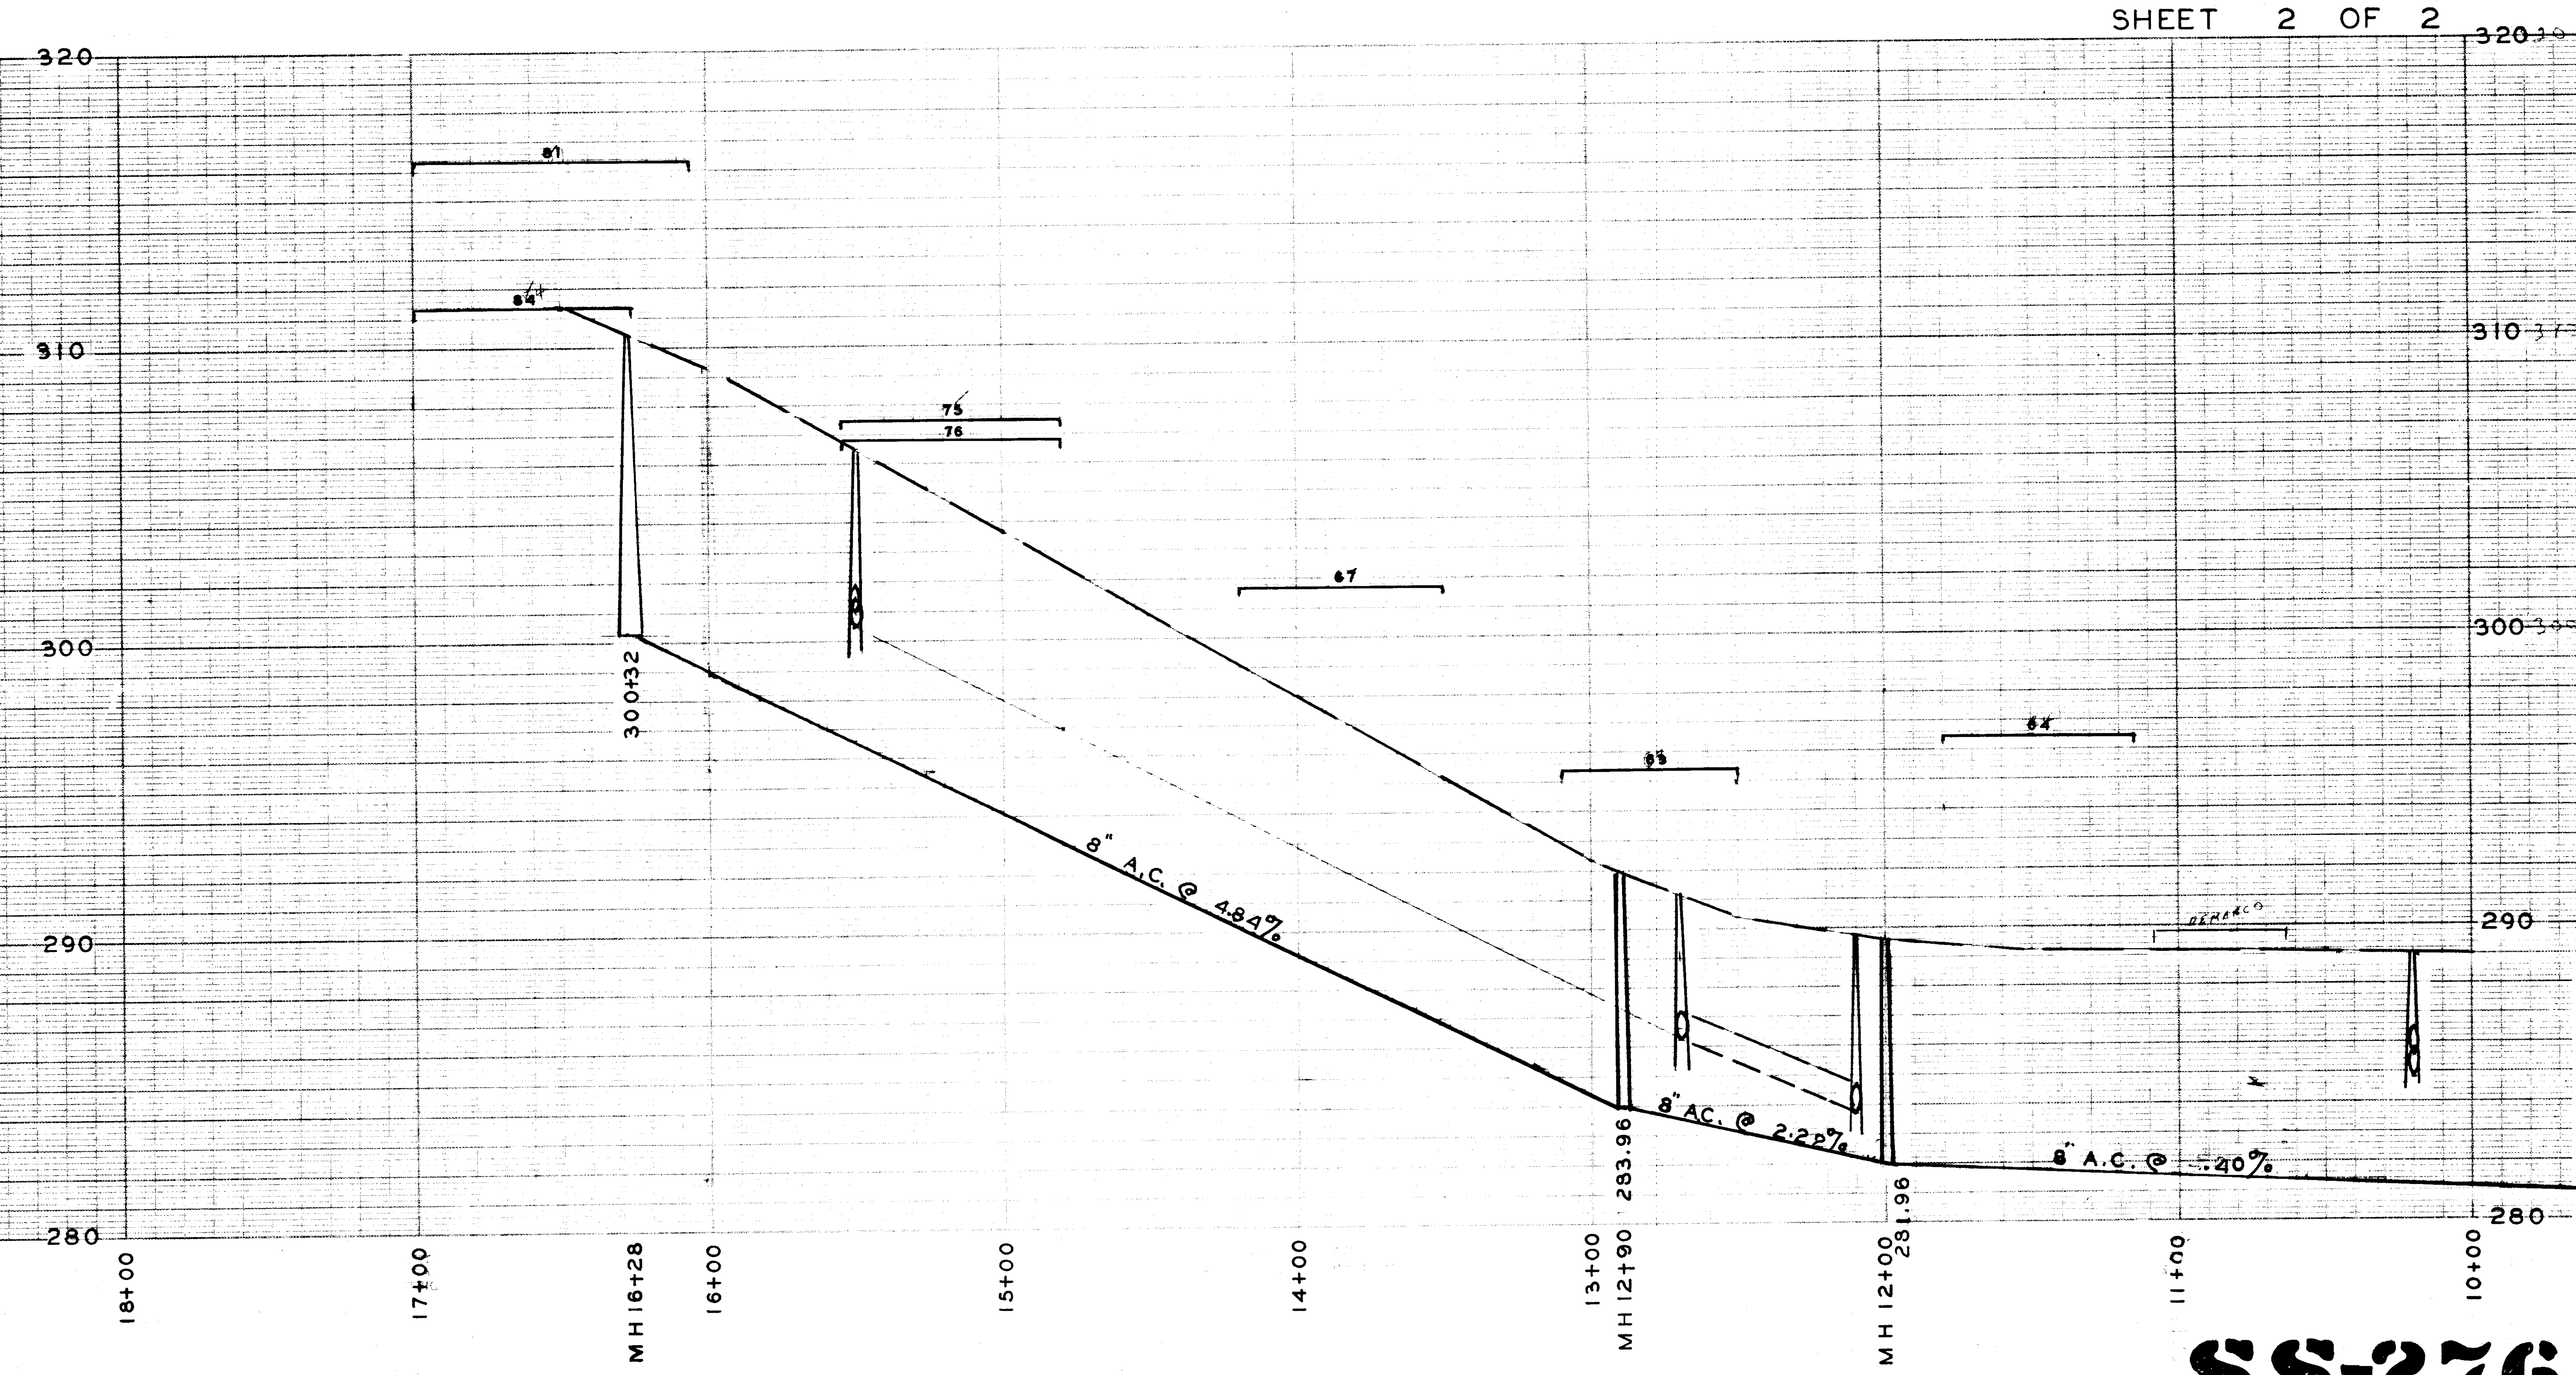

SS-276