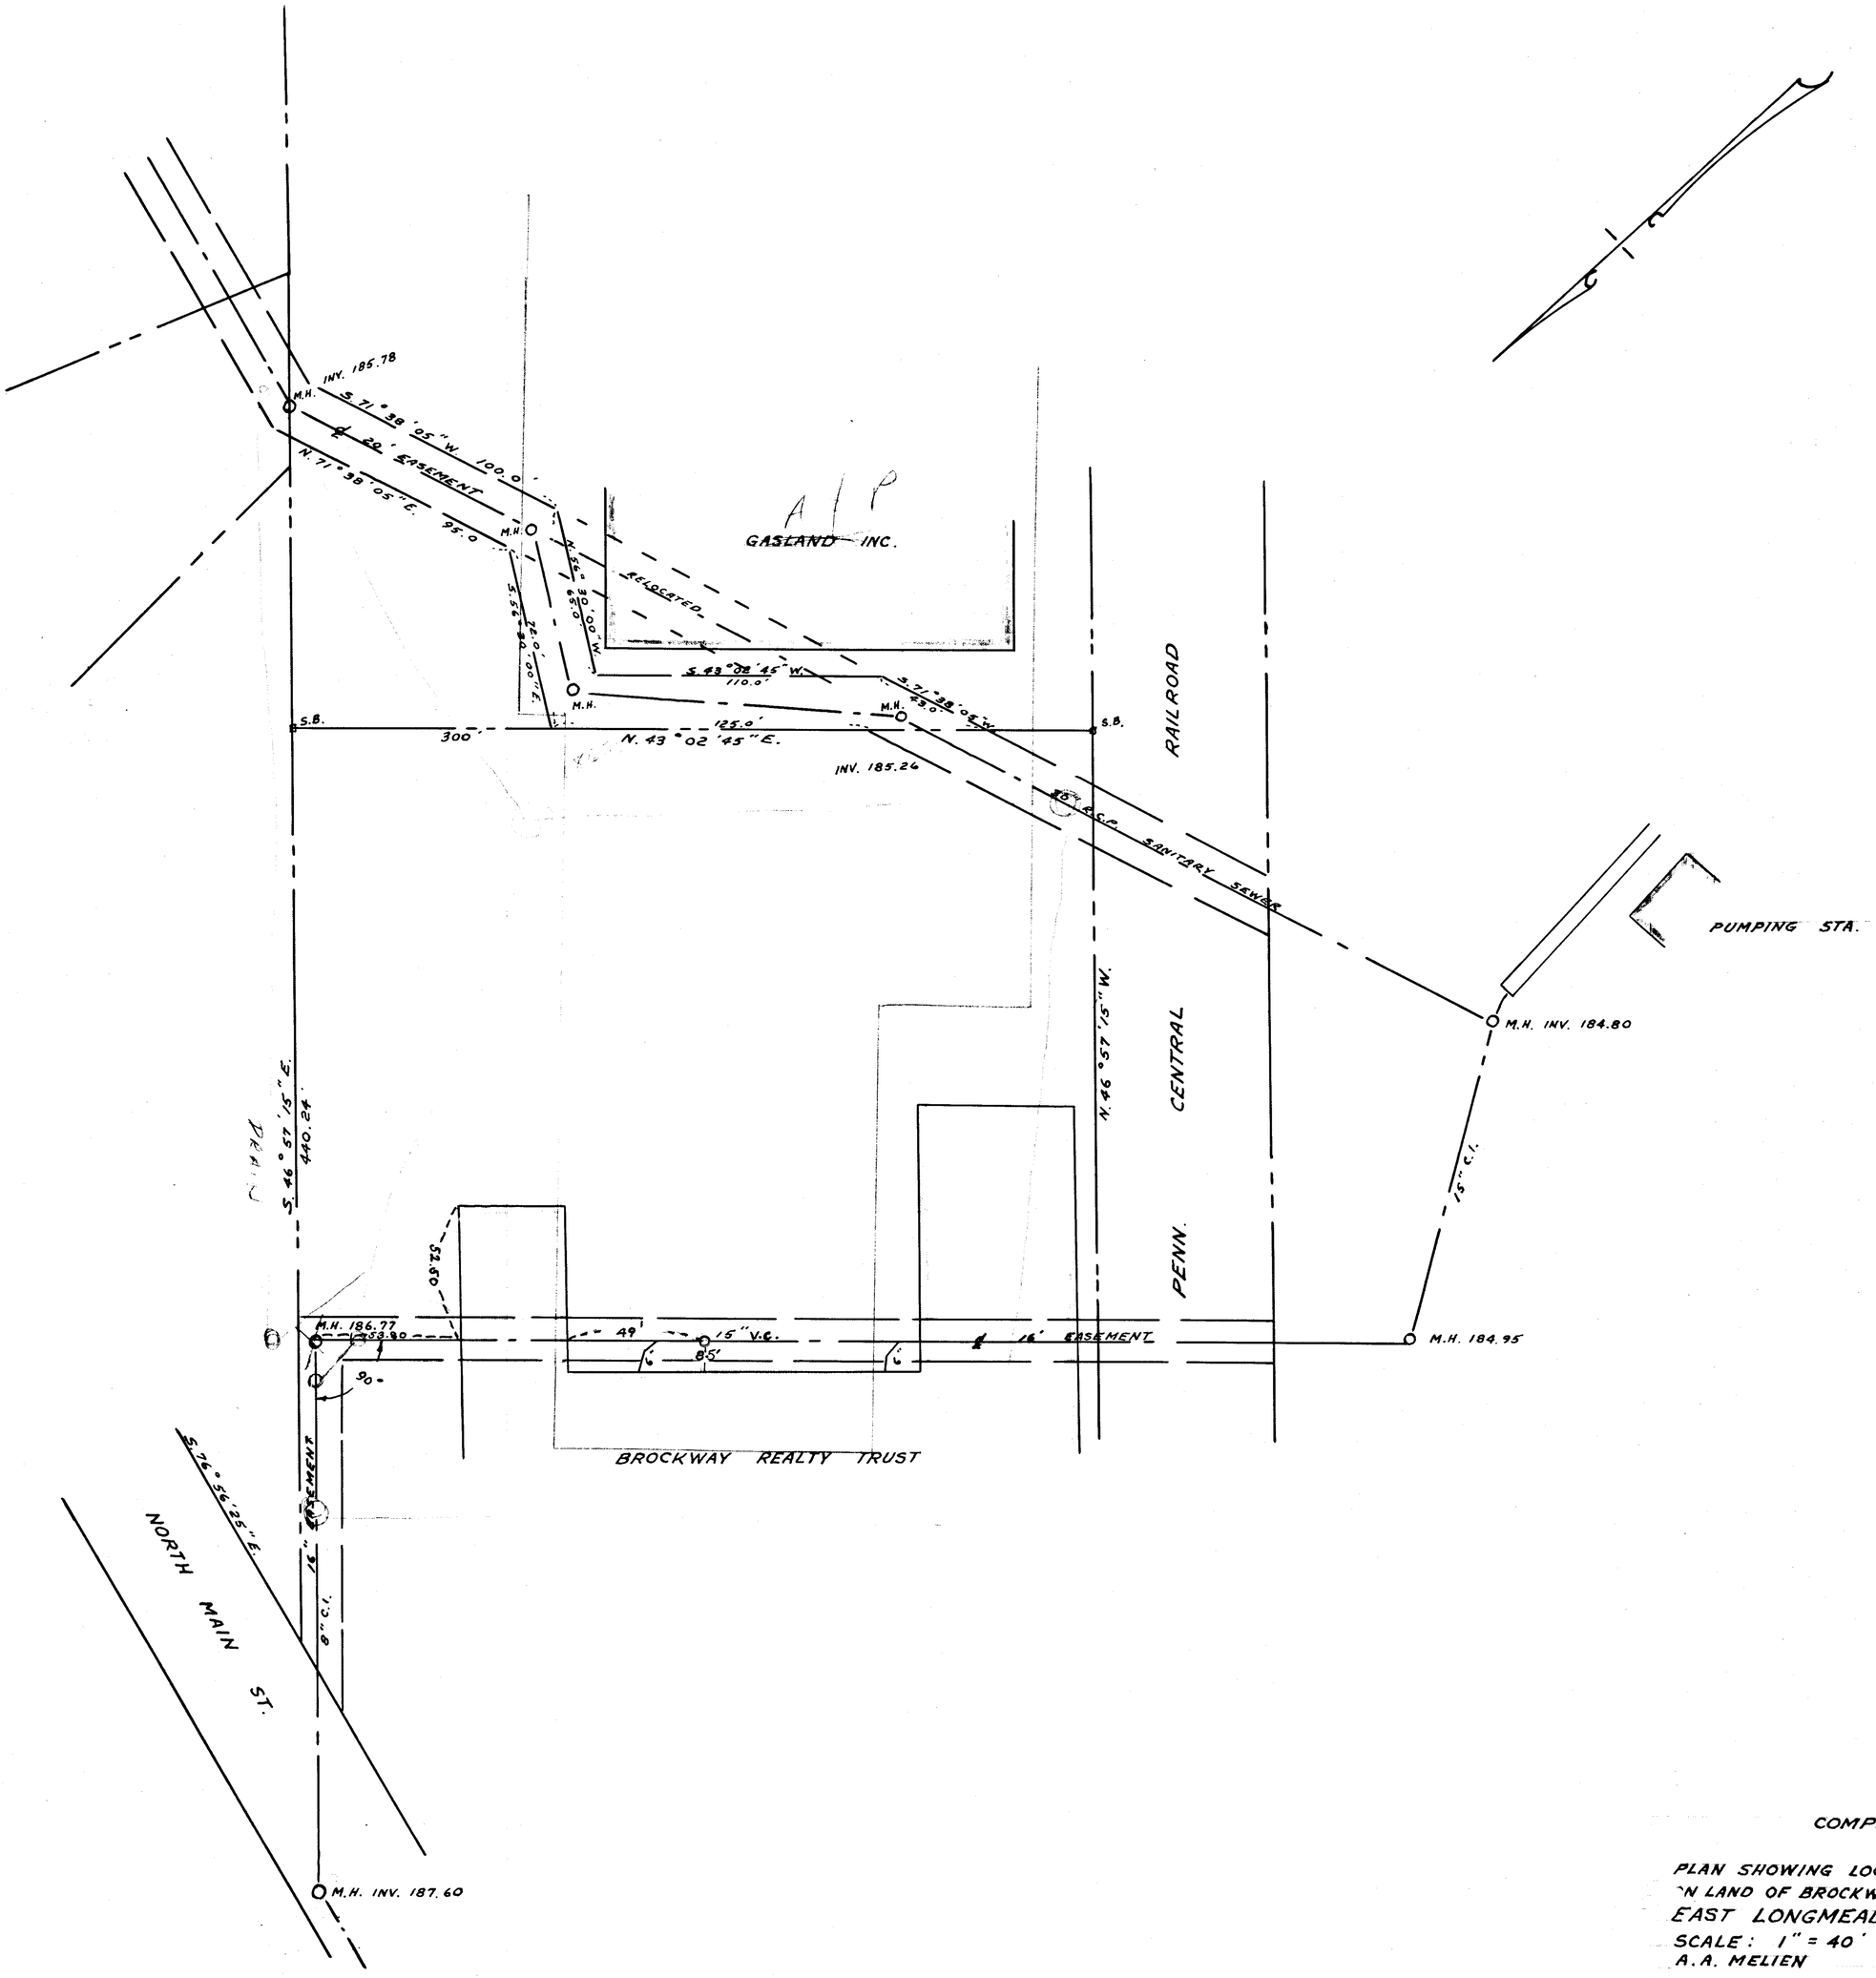

COMPILED DATA

PLAN SHOWING LOCATION OF SEWER EASEMENTS
ON LAND OF BROCKWAY REALTY TRUST & GASLAND INC
EAST LONGMEADOW MASS.
SCALE: 1" = 40' JULY 1973
A.A. MELIEN TOWN ENG'R.

SS 295