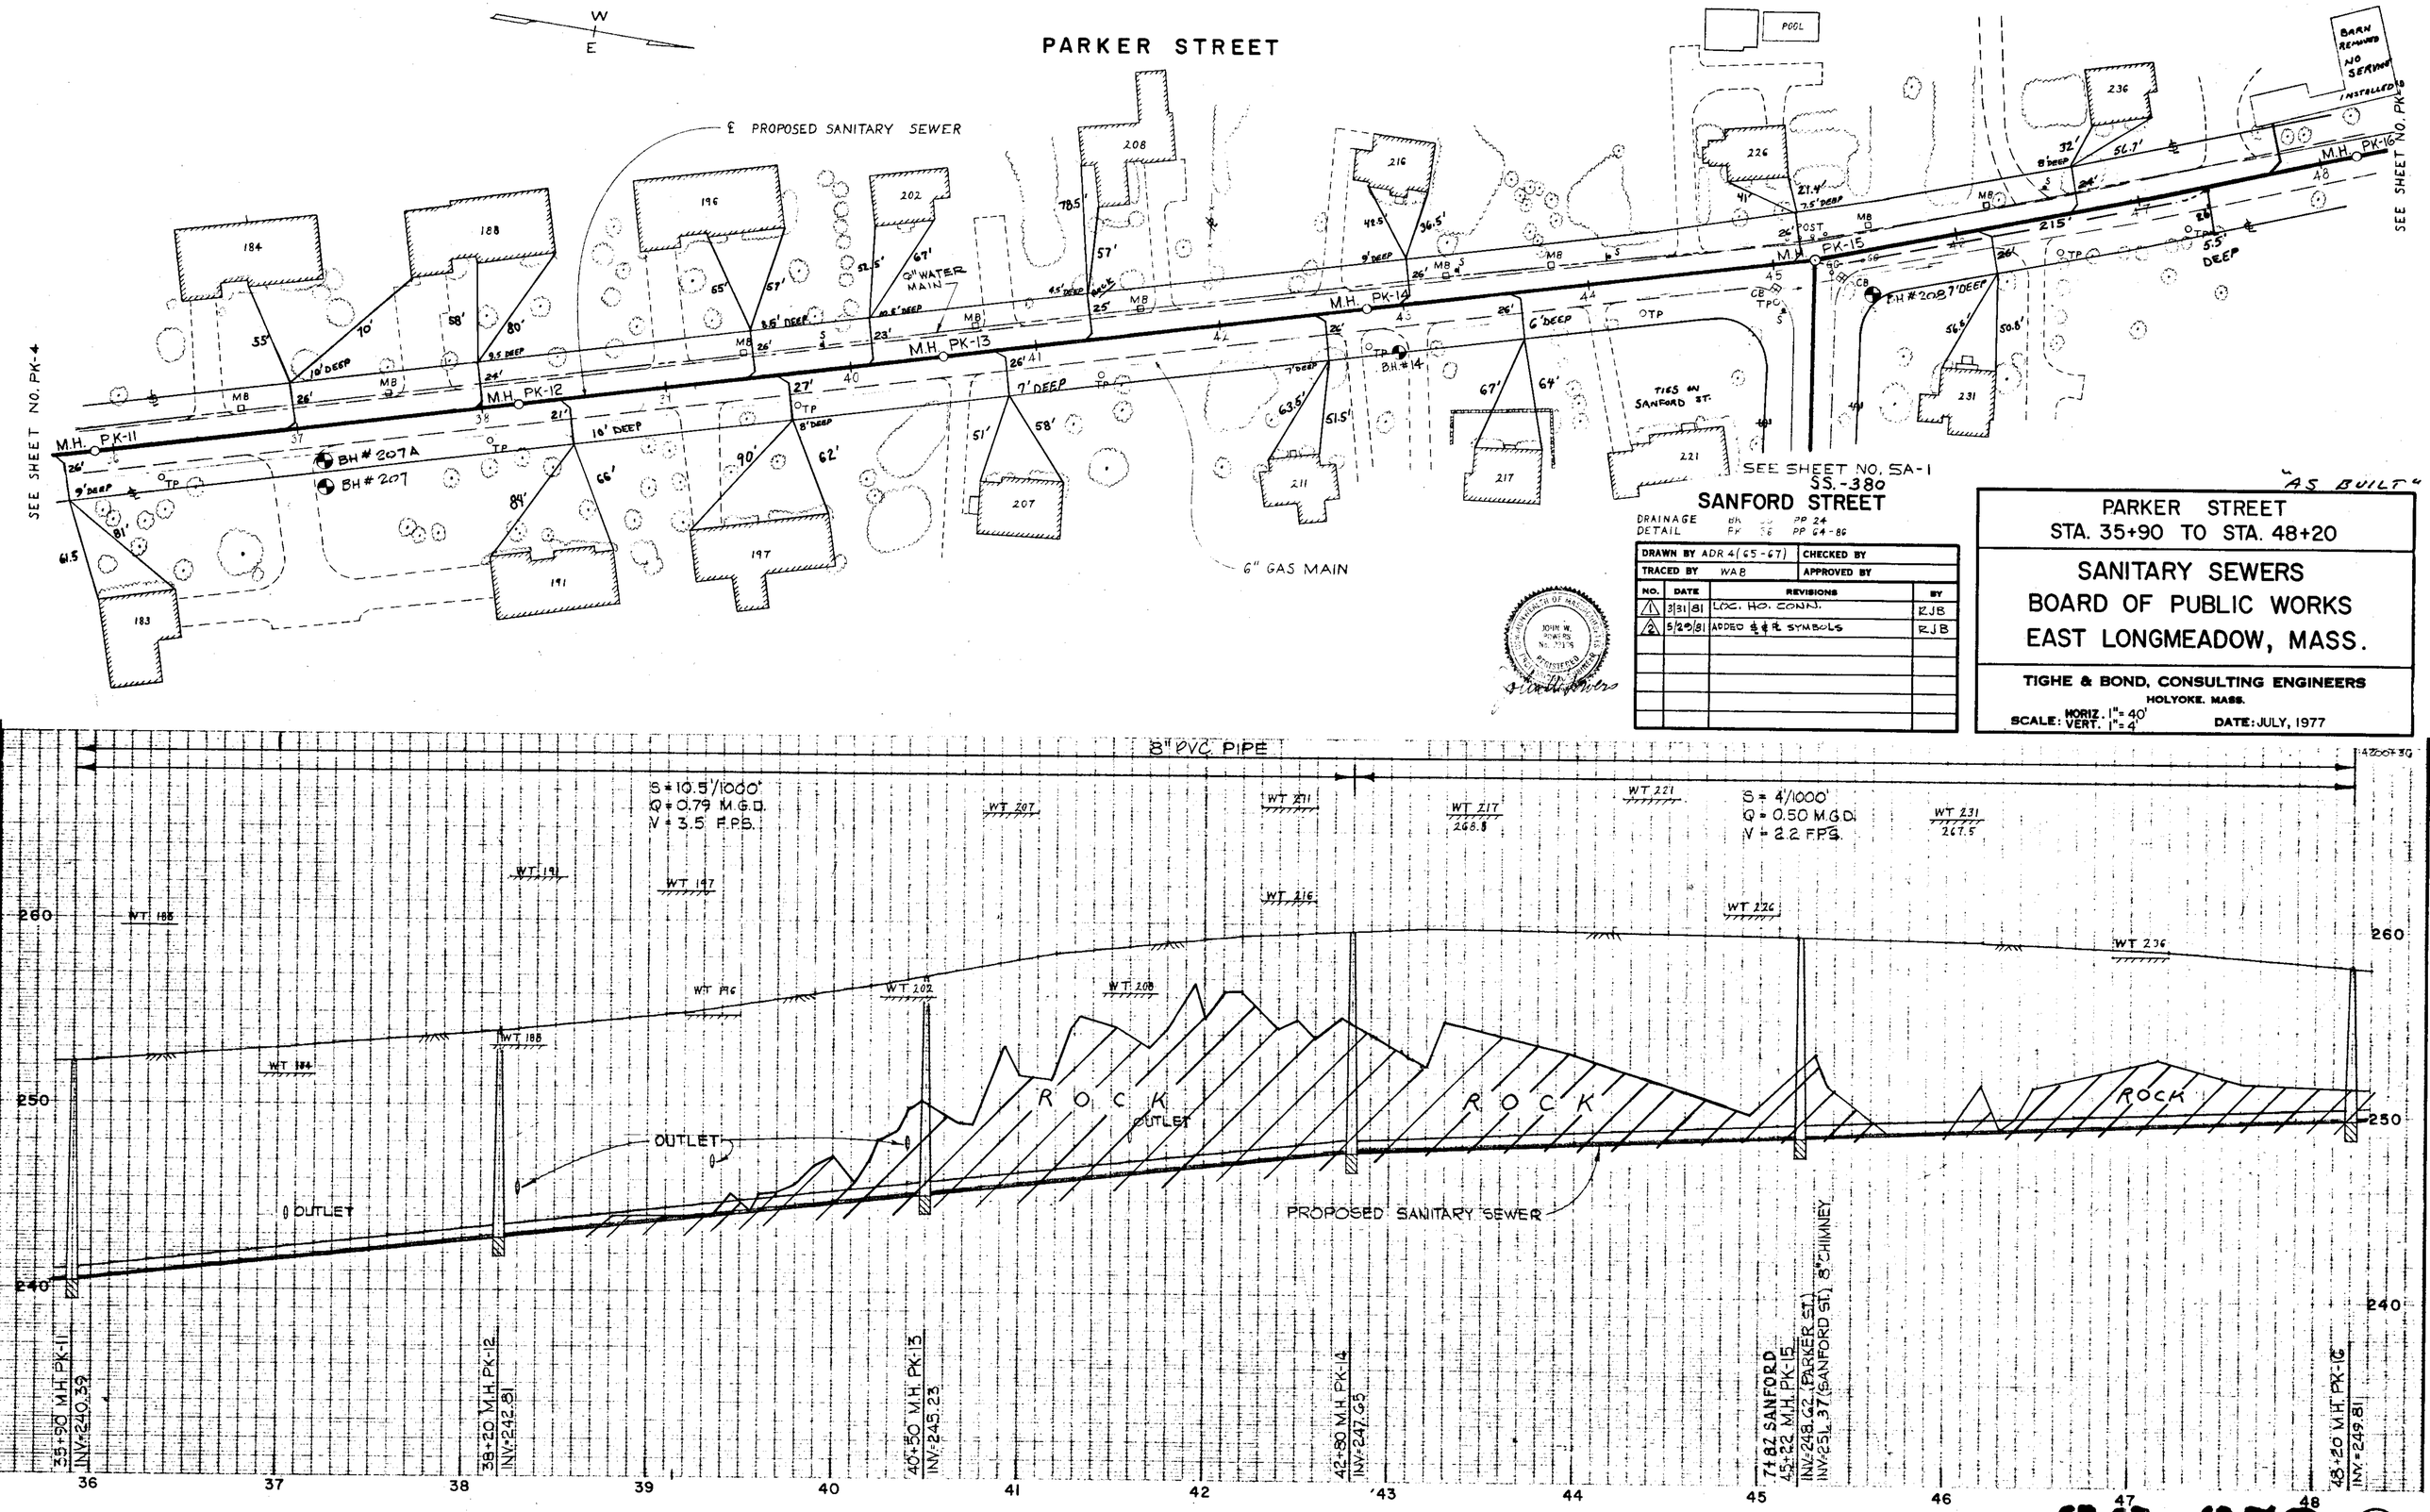

DRAWN BY ADR 4 (65-67)	CHECKED BY
TRACED BY WAB	APPROVED BY

NO.	DATE	REVISIONS	BY
1	3/31/81	LOC. HO. CONN.	RJB
2	5/29/81	ADDED ℄ & R SYMBOLS	RJB

"AS BUILT"

PARKER STREET
STA. 35+90 TO STA. 48+20

SANITARY SEWERS
BOARD OF PUBLIC WORKS
EAST LONGMEADOW, MASS.

TIGHE & BOND, CONSULTING ENGINEERS
HOLYOKE, MASS.

SCALE: HORIZ. 1" = 40' VERT. 1" = 4'

DATE: JULY, 1977

SS-379 PK5