



SEE SHEET NO. PK-5

SEE SHEET NO. PK-7

 

DRAINAGE DETAIL BK 35 PP 24 BK 36 PP 64-86

DRAWN BY ADG A/52-63/54-85		CHECKED BY	
TRACED BY WAB		APPROVED BY	
NO.	DATE	REVISIONS	BY
1	3/31/81	LOC. H.O. CONN.	RJB
2	5/29/81	ADDED & SYMBOL	RJB

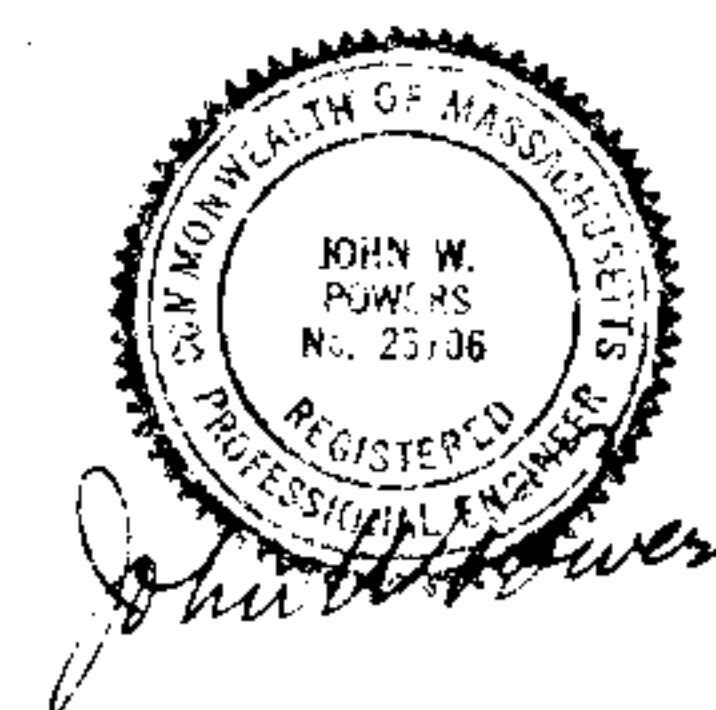

AS BUILT

PARKER STREET
STA. 48+20 TO STA. 58+55

SANITARY SEWERS
BOARD OF PUBLIC WORKS
EAST LONGMEADOW, MASS.

TIGHE & BOND, CONSULTING ENGINEERS
HOLYOKE, MASS.

SCALE: HORIZ. 1"=40'
VERT. 1"=4'

DATE: JULY, 1977

