


SEE SHEET NO. KL-1

SEE SHEET NO. PK-5

KENNETH LUNDEN DRIVE

SANFORD STREET

PARKER STREET

 


PROPOSED SANITARY SEWER
(N.I.T.C.)

2" GAS MAIN

DRAINAGE BK 36 PP 92-94
DETAIL BK 36 PP 88

DRAWN BY ADR 4 (CA-GG)		CHECKED BY	
TRACED BY WAS		APPROVED BY	
NO.	DATE	REVISIONS	BY
1	3/31/81	LOC. NO. 5000N & LOC. M.H. SA-5 SHOWN LIMITS OF CONTR. 5	RJB
2	5/20/81	ADDED 2" & 3" SYMBOLS	RJB

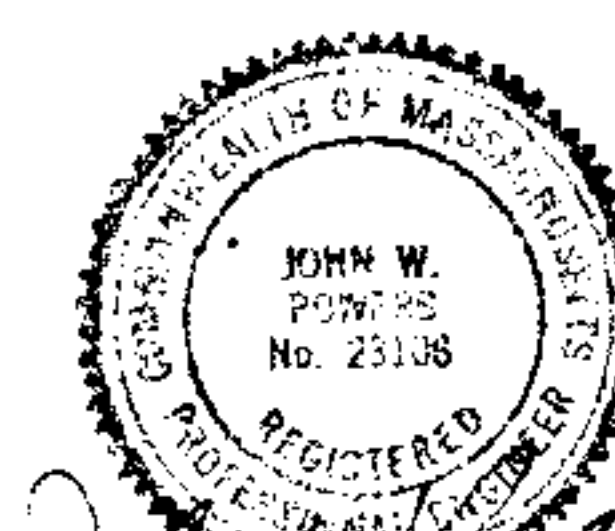


SANFORD STREET
STA. 1+10 TO STA. 2+20; STA. 3+00 TO STA. 7+82

SANITARY SEWERS
BOARD OF PUBLIC WORKS
EAST LONGMEADOW, MASS.

TIGHE & BOND, CONSULTING ENGINEERS
HOLYOKE, MASS.

SCALE: HORIZ. 1" = 40'
VERT. 1" = 4'

DATE: JULY, 1977

 

SS-38(SA)