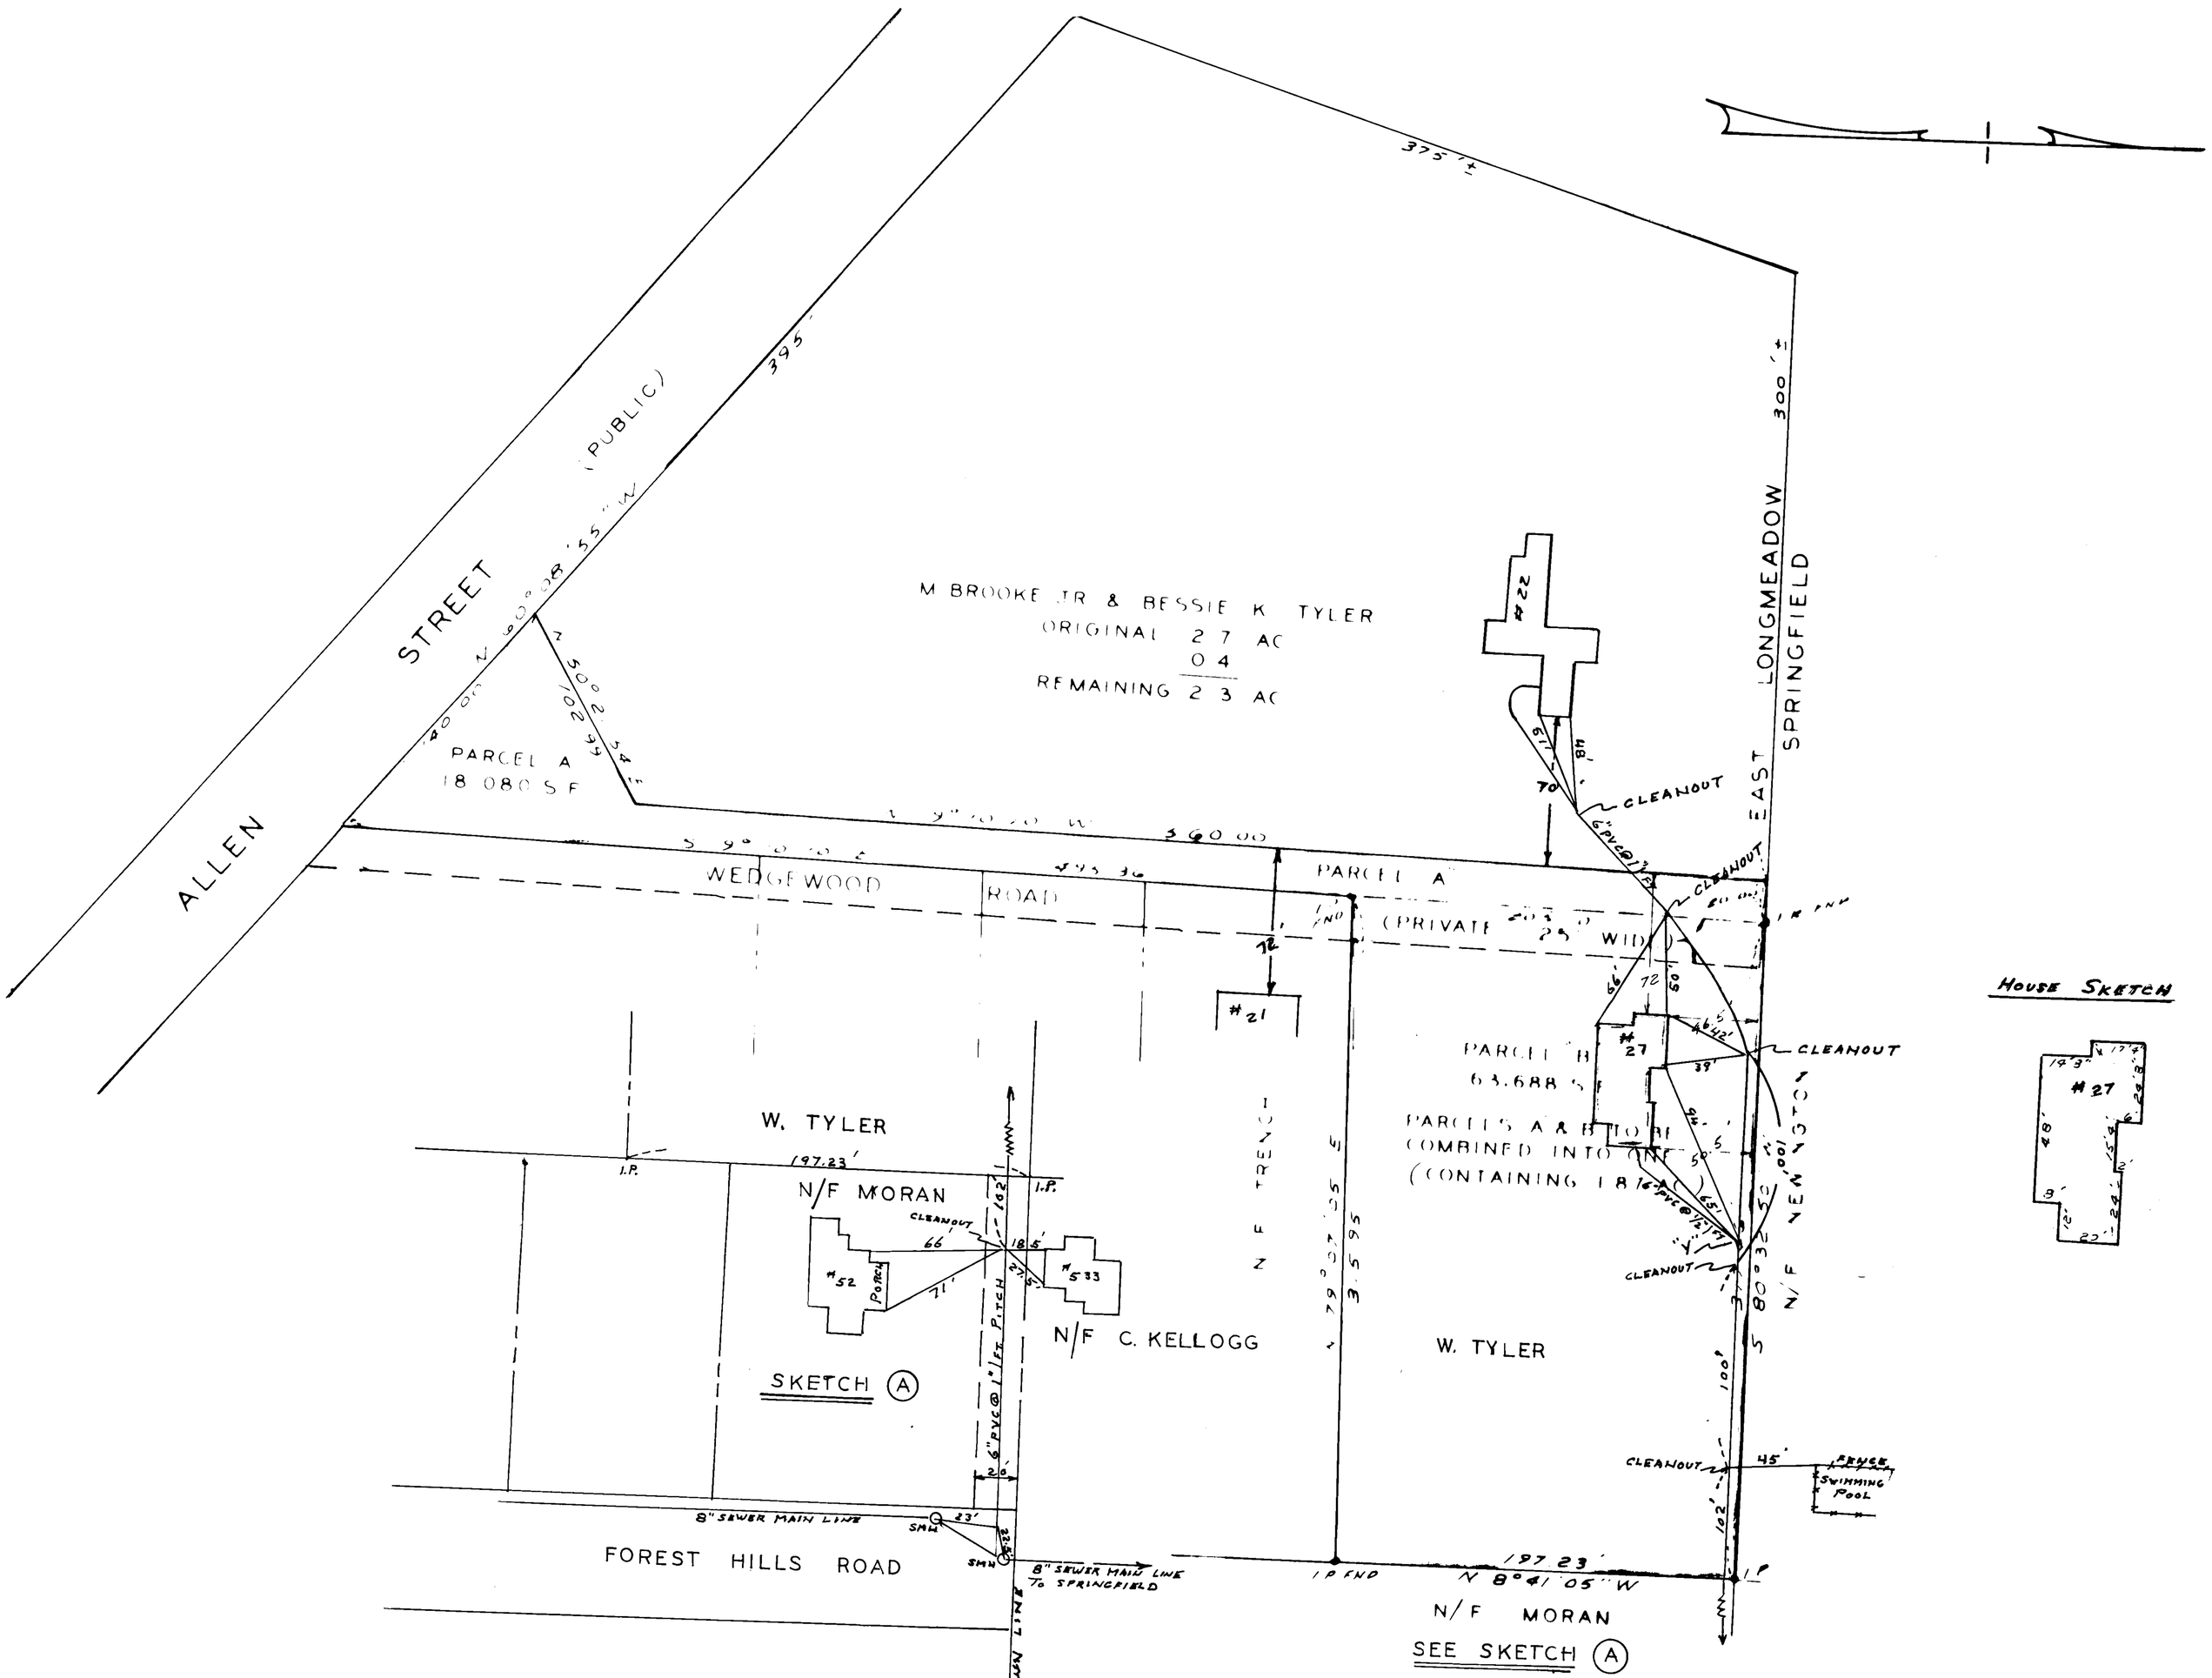

PLAN OF LAND IN
EAST LONGMEADOW, MASS.
SCALE 1" = 60' MAY 19, 1984

GRAPHIC SCALE: 0' 60' 120'

PREPARED IN CONFORMANCE WITH THE RULES AND REGULATIONS OF THE REGISTRY OF DEEDS

DATE 5-22-84 Alfred A. Meliere
REGISTERED LAND SURVEYOR

APPROVED UNDER THE SUBDIVISION CONTROL LAW NOT REQUIRED

DATE May 22, 1984
BY MAJORITY Thomas E. Wilson

Alfred A. Meliere Jr. R.L.S.

SS-385