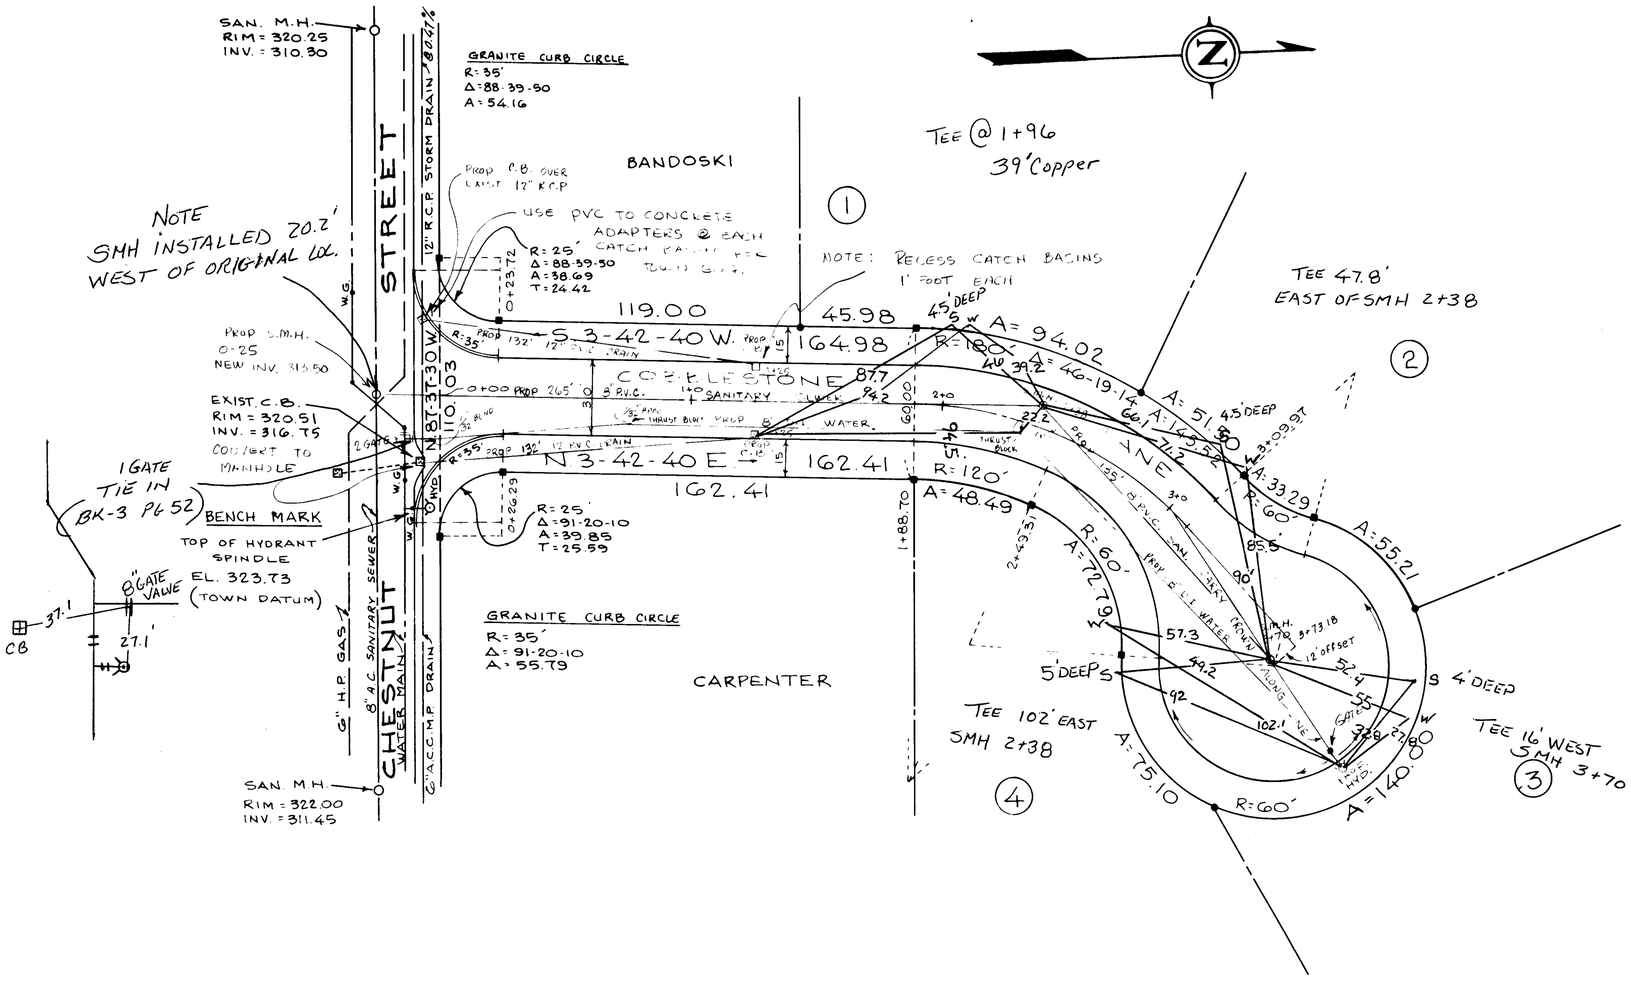

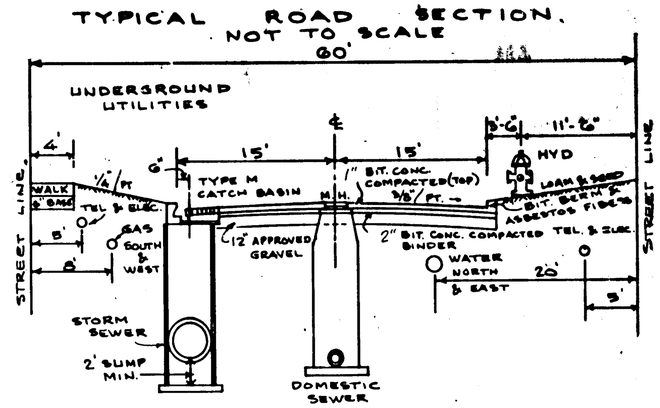

NOTE:
TEL. TERMINAL LOCATION SAME AS UTILITY POLES

NOTE:
GRAVEL BASE TO BE STABILIZED WITH CALCIUM CHLORIDE AND COMPACTED WITH ROLLER WEIGHING NOT LESS THAN 8 TONS, AND OTHERWISE AS SPECIFIED IN DEPT. OF PUBLIC WORKS RULES & REGULATIONS

APPROVED BY THE EAST LONGMEADOW PLANNING BOARD

DATE March 12, 1985 Thomas J. Wilson
CHAIRMAN

NOTE:
ALL MATERIALS AND CONSTRUCTION METHODS TO COMPLY WITH THE STANDARDS OF THE BOARD OF PUBLIC WORKS OF EAST LONGMEADOW

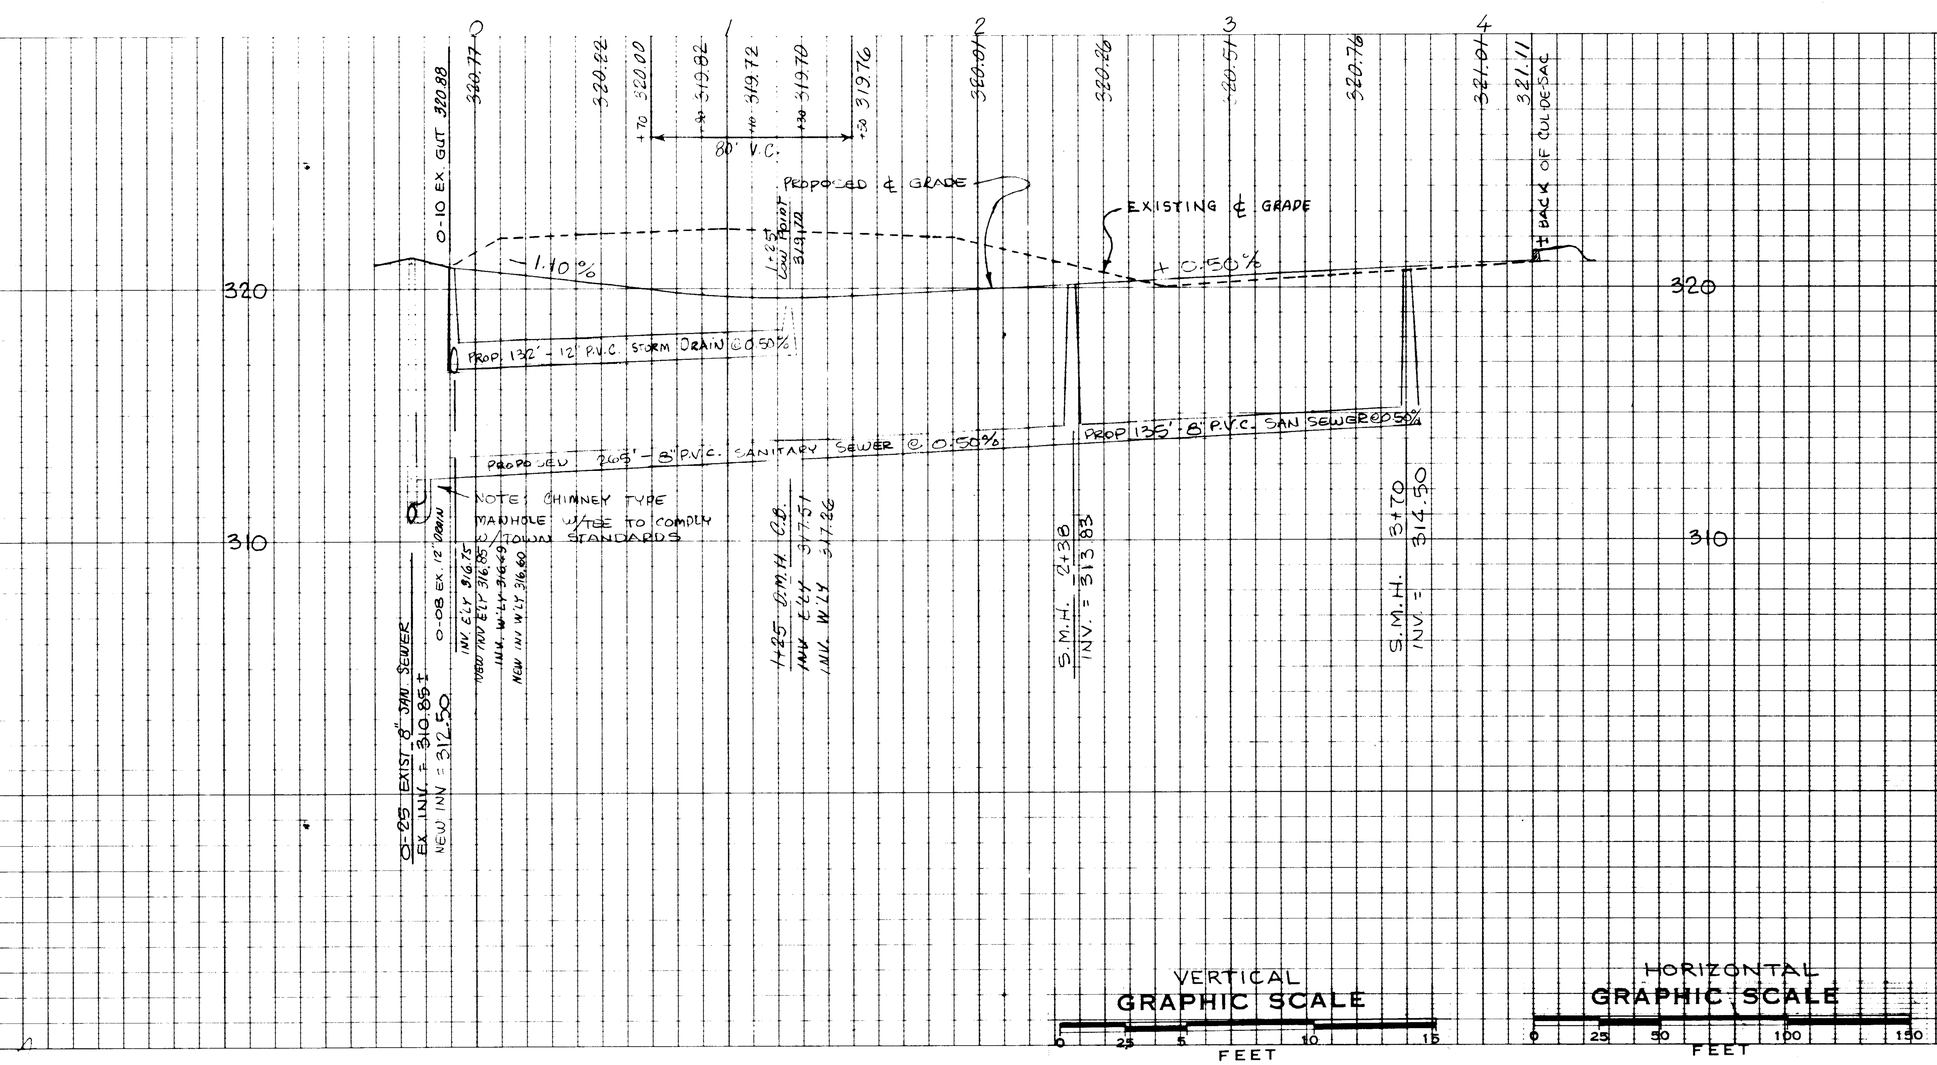

TOWN OF EAST LONGMEADOW
RECEIVED
PLANNING BOARD

PLAN & PROFILE

COBBLESTONE LANE
EAST LONGMEADOW, MA.

FOR

EDWARD SPEIGHT

SHEET 3 of 3 REVISED 11/27/84

SCALE: VERT. 4 FT/IN HOR. 40 FT/IN DATE OCT. 1984

SMITH ASSOCIATES
ENGINEERING INC.
ENGINEERS — SURVEYORS
602 WHITE ST., SPRINGFIELD, MASS. 01108

S.S. 396