PROFILE - EXISTING & PROPOSED CULVERT
SCALE: HORZ. 1" = 40'
VERT. 1" = 4'

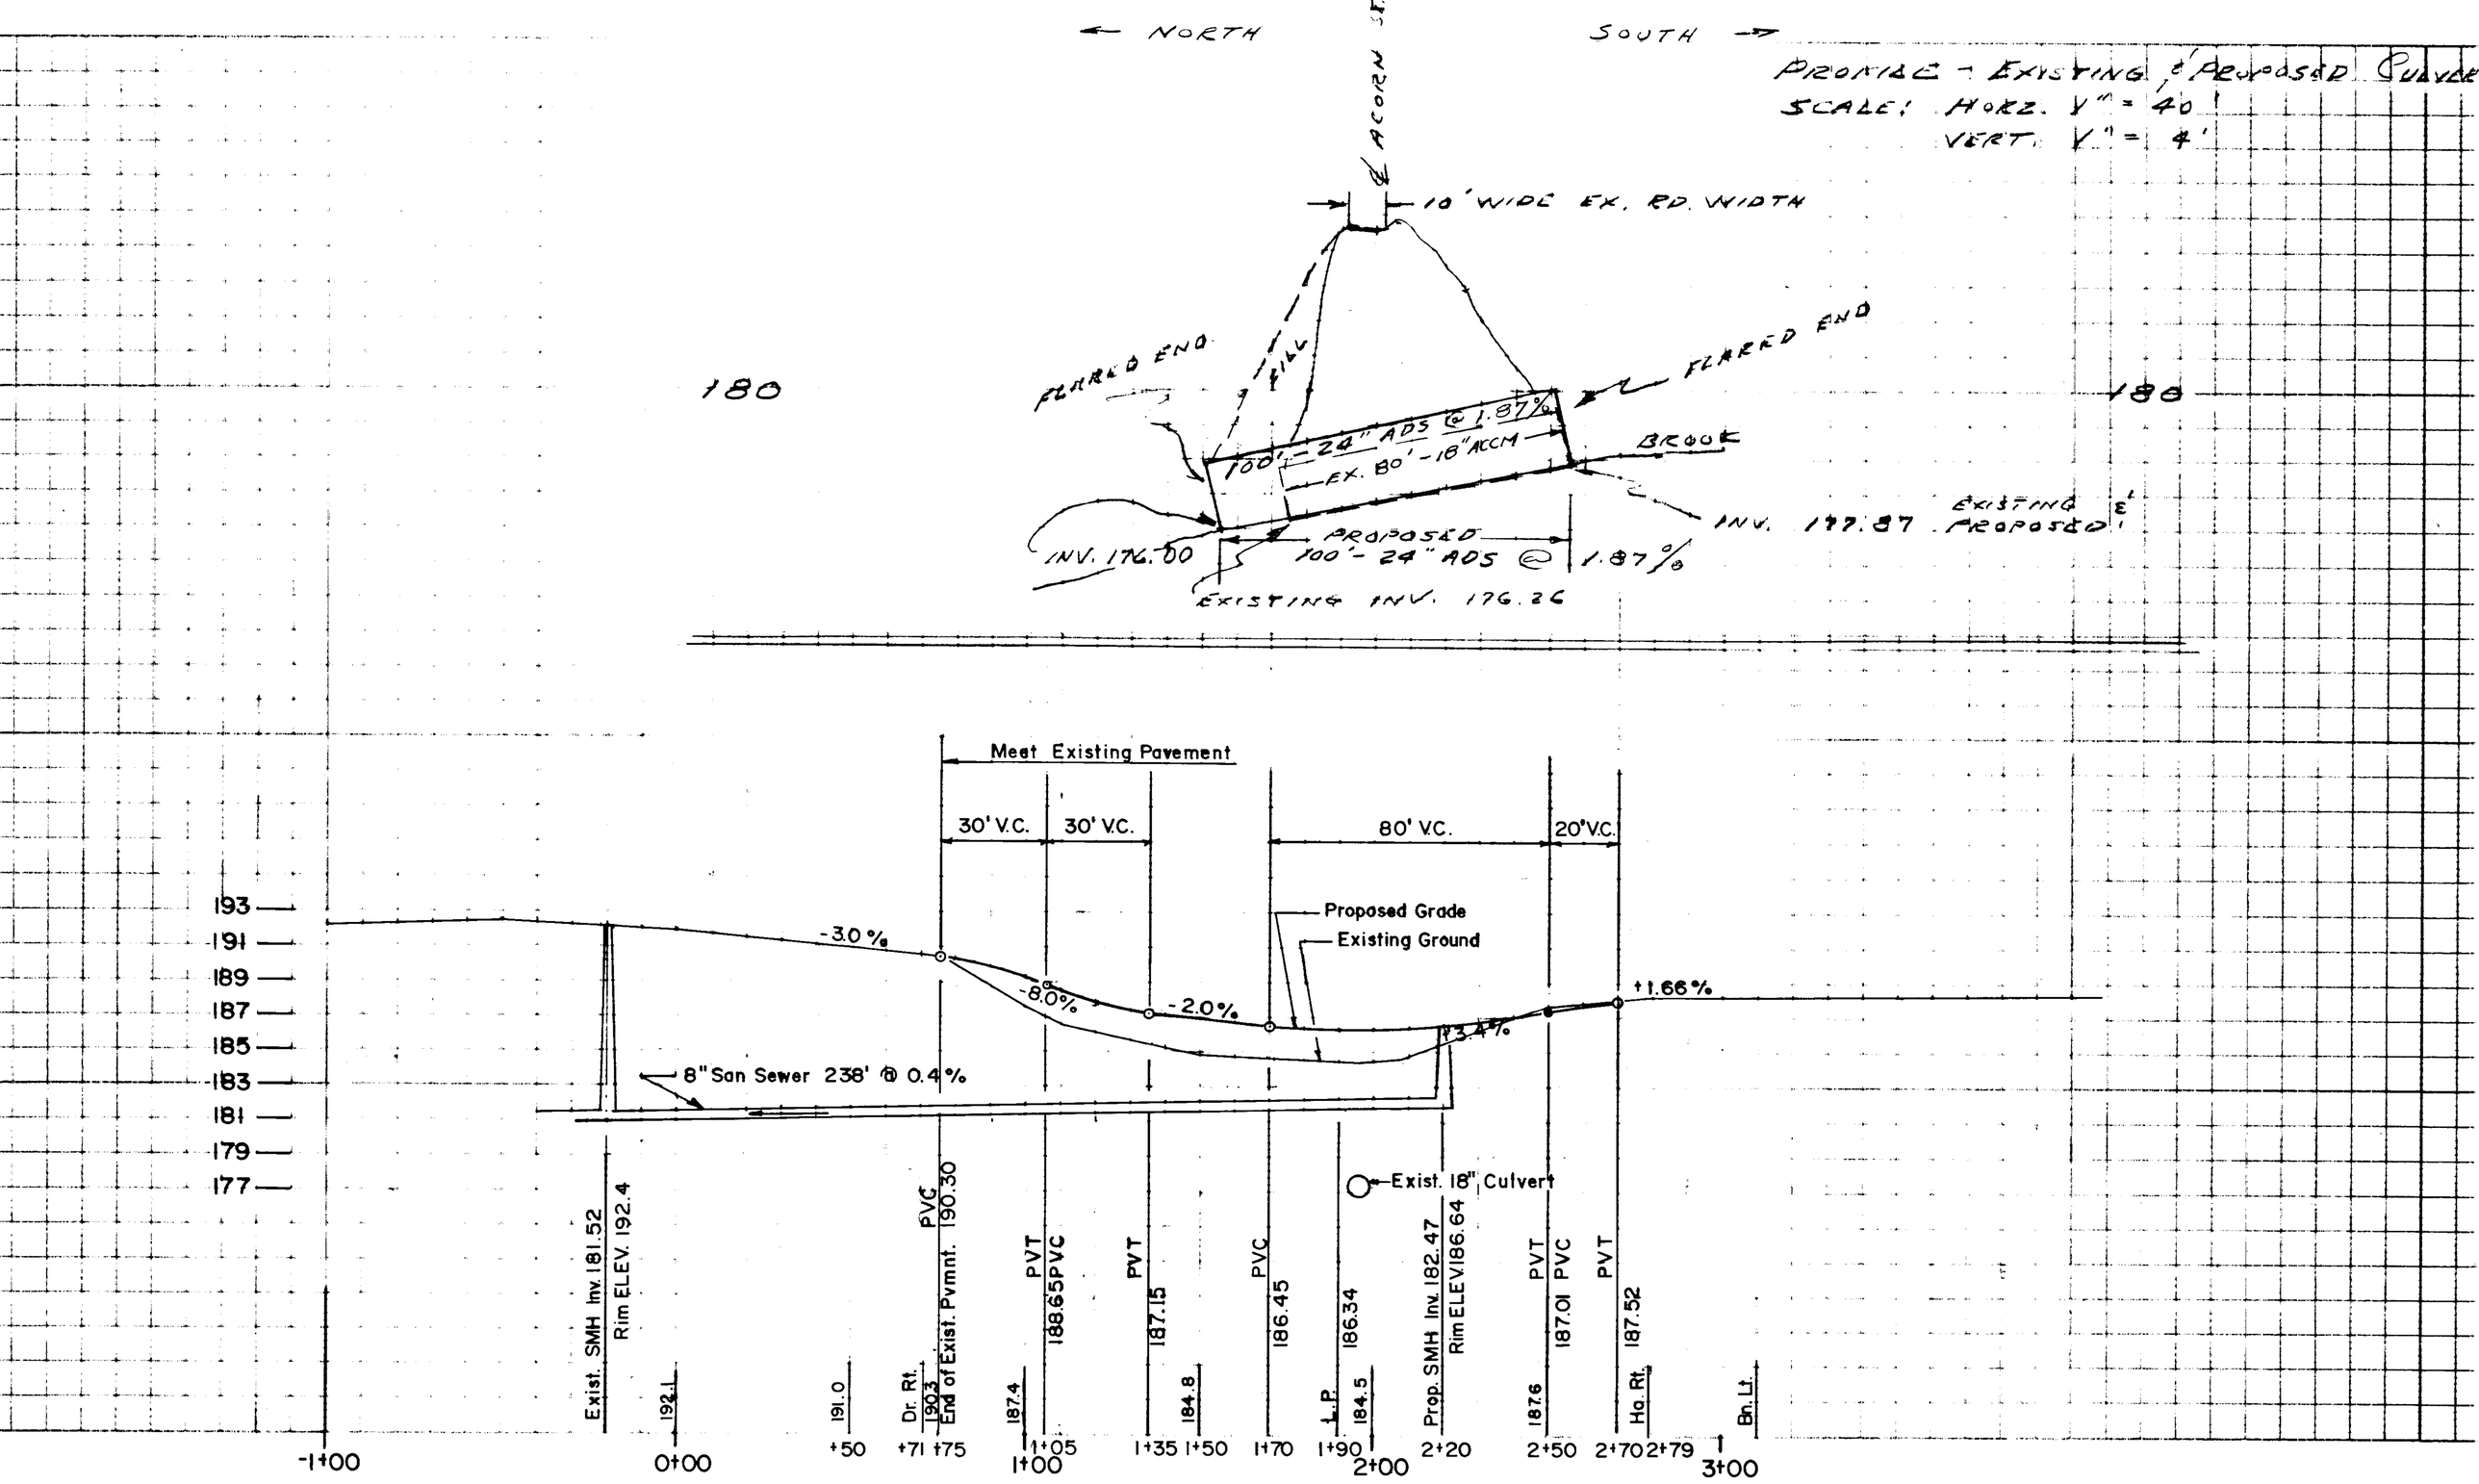

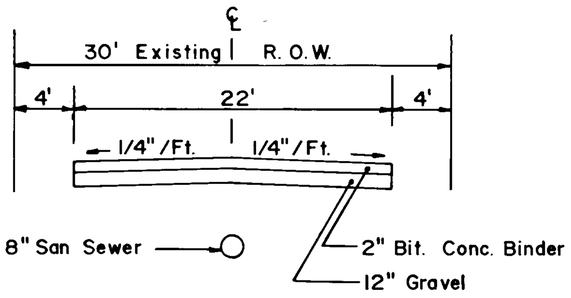

TYPICAL SECTION
ACORN STREET
NOT TO SCALE

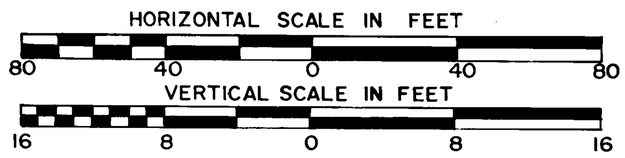

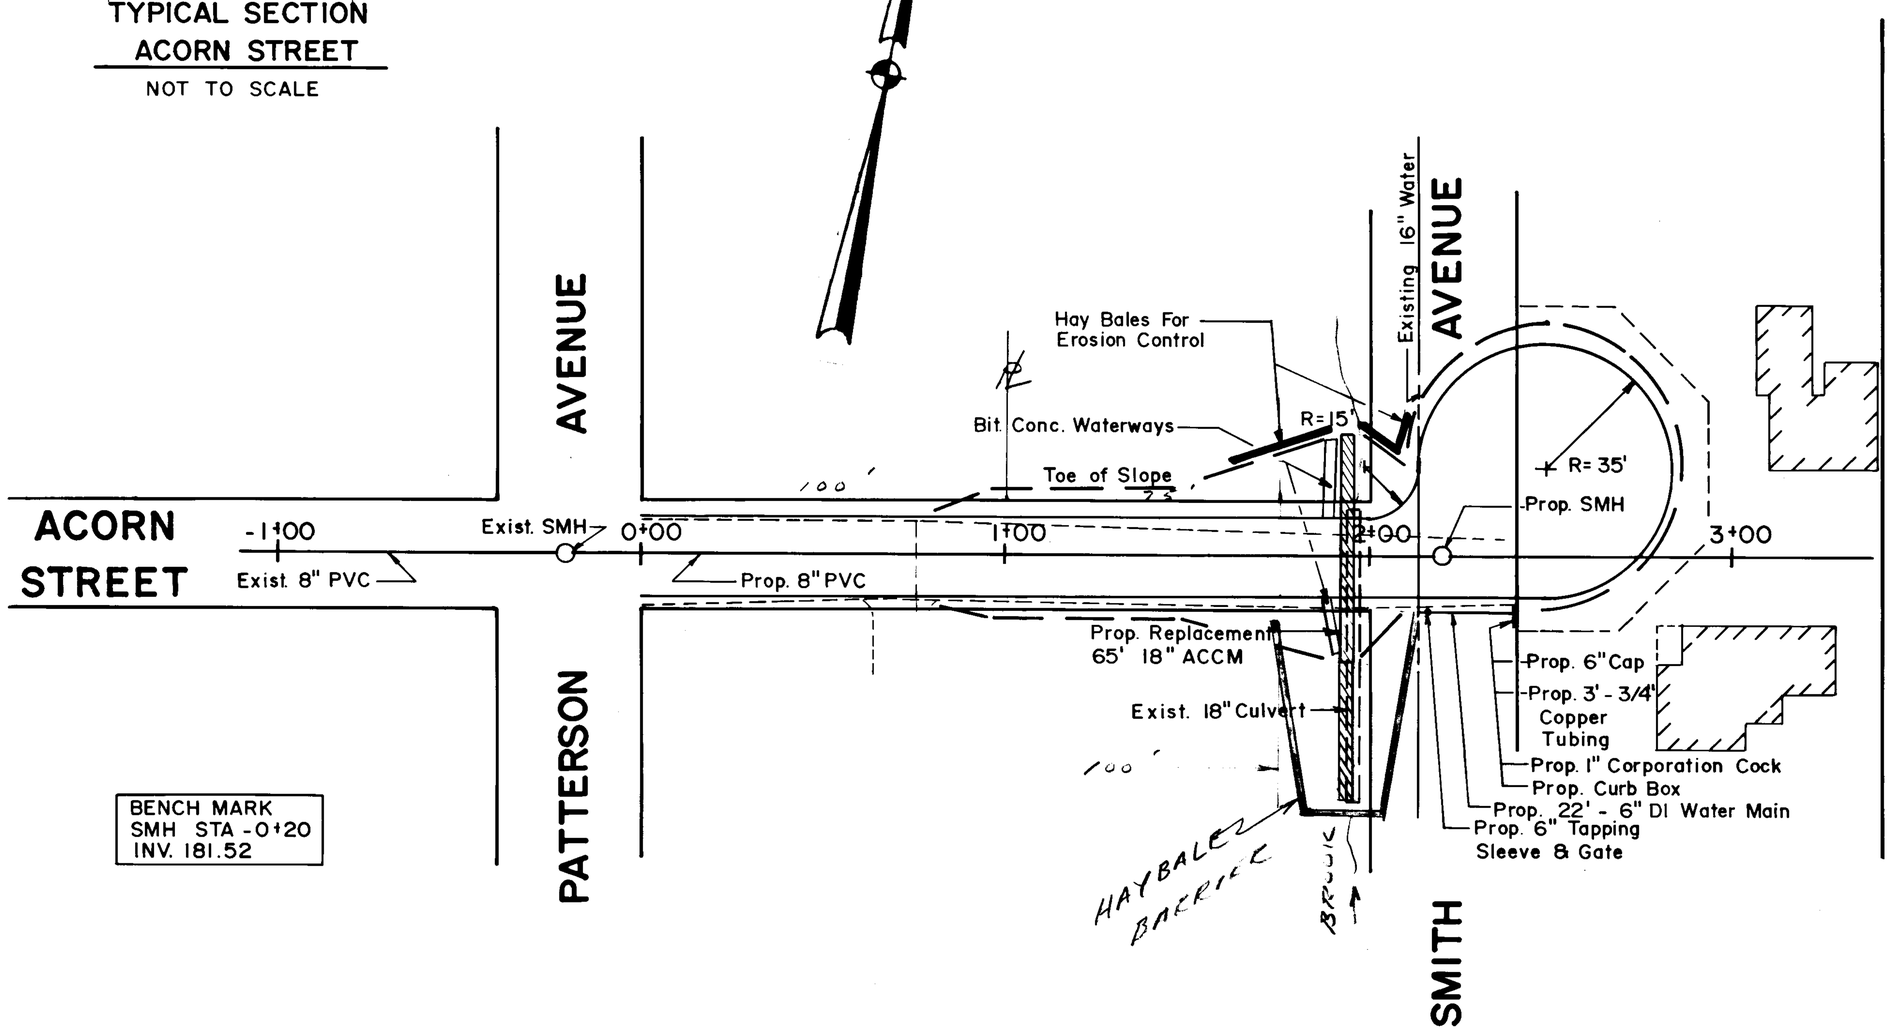

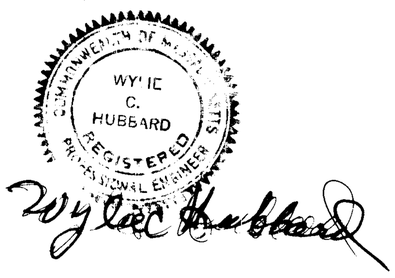

PLAN AND PROFILE
ACORN STREET
FROM PATTERSON AVE.
TO SMITH AVE.

EAST LONGMEADOW, MA.

LUCHS & BECKERMAN
CIVIL ENGINEERS - PLANNERS - LAND SURVEYORS
GLASTONBURY, CONN.

87 - 010

SCALE 1" = 40' | DATE 4 - 24 - 87

SS 417