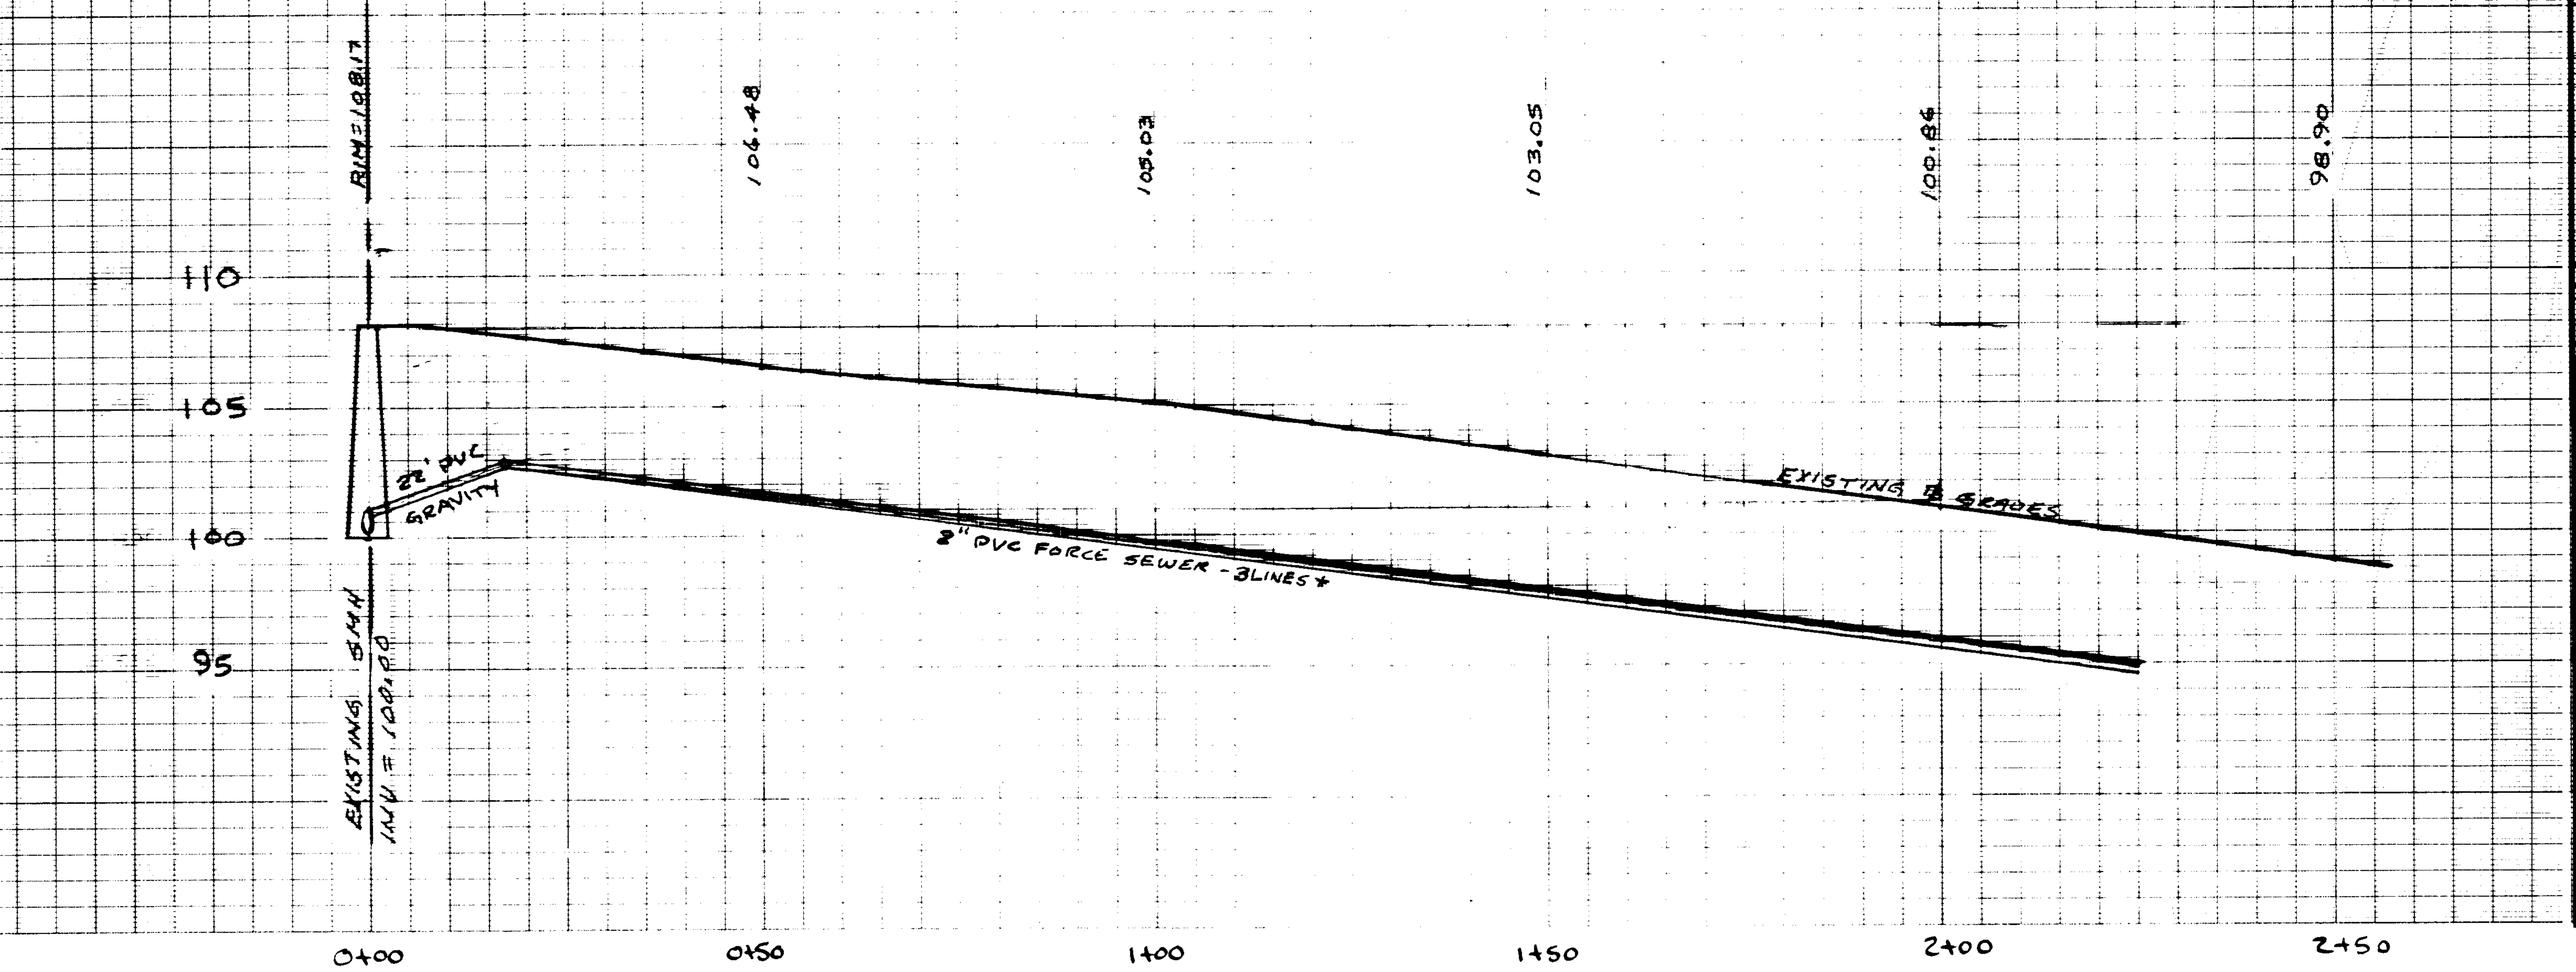

3 LINES - 2" PVC
S'LY LINE - HOUSE #18
CENTER LINE - LOT #2 - FUTURE
N'LY LINE - LOT #1

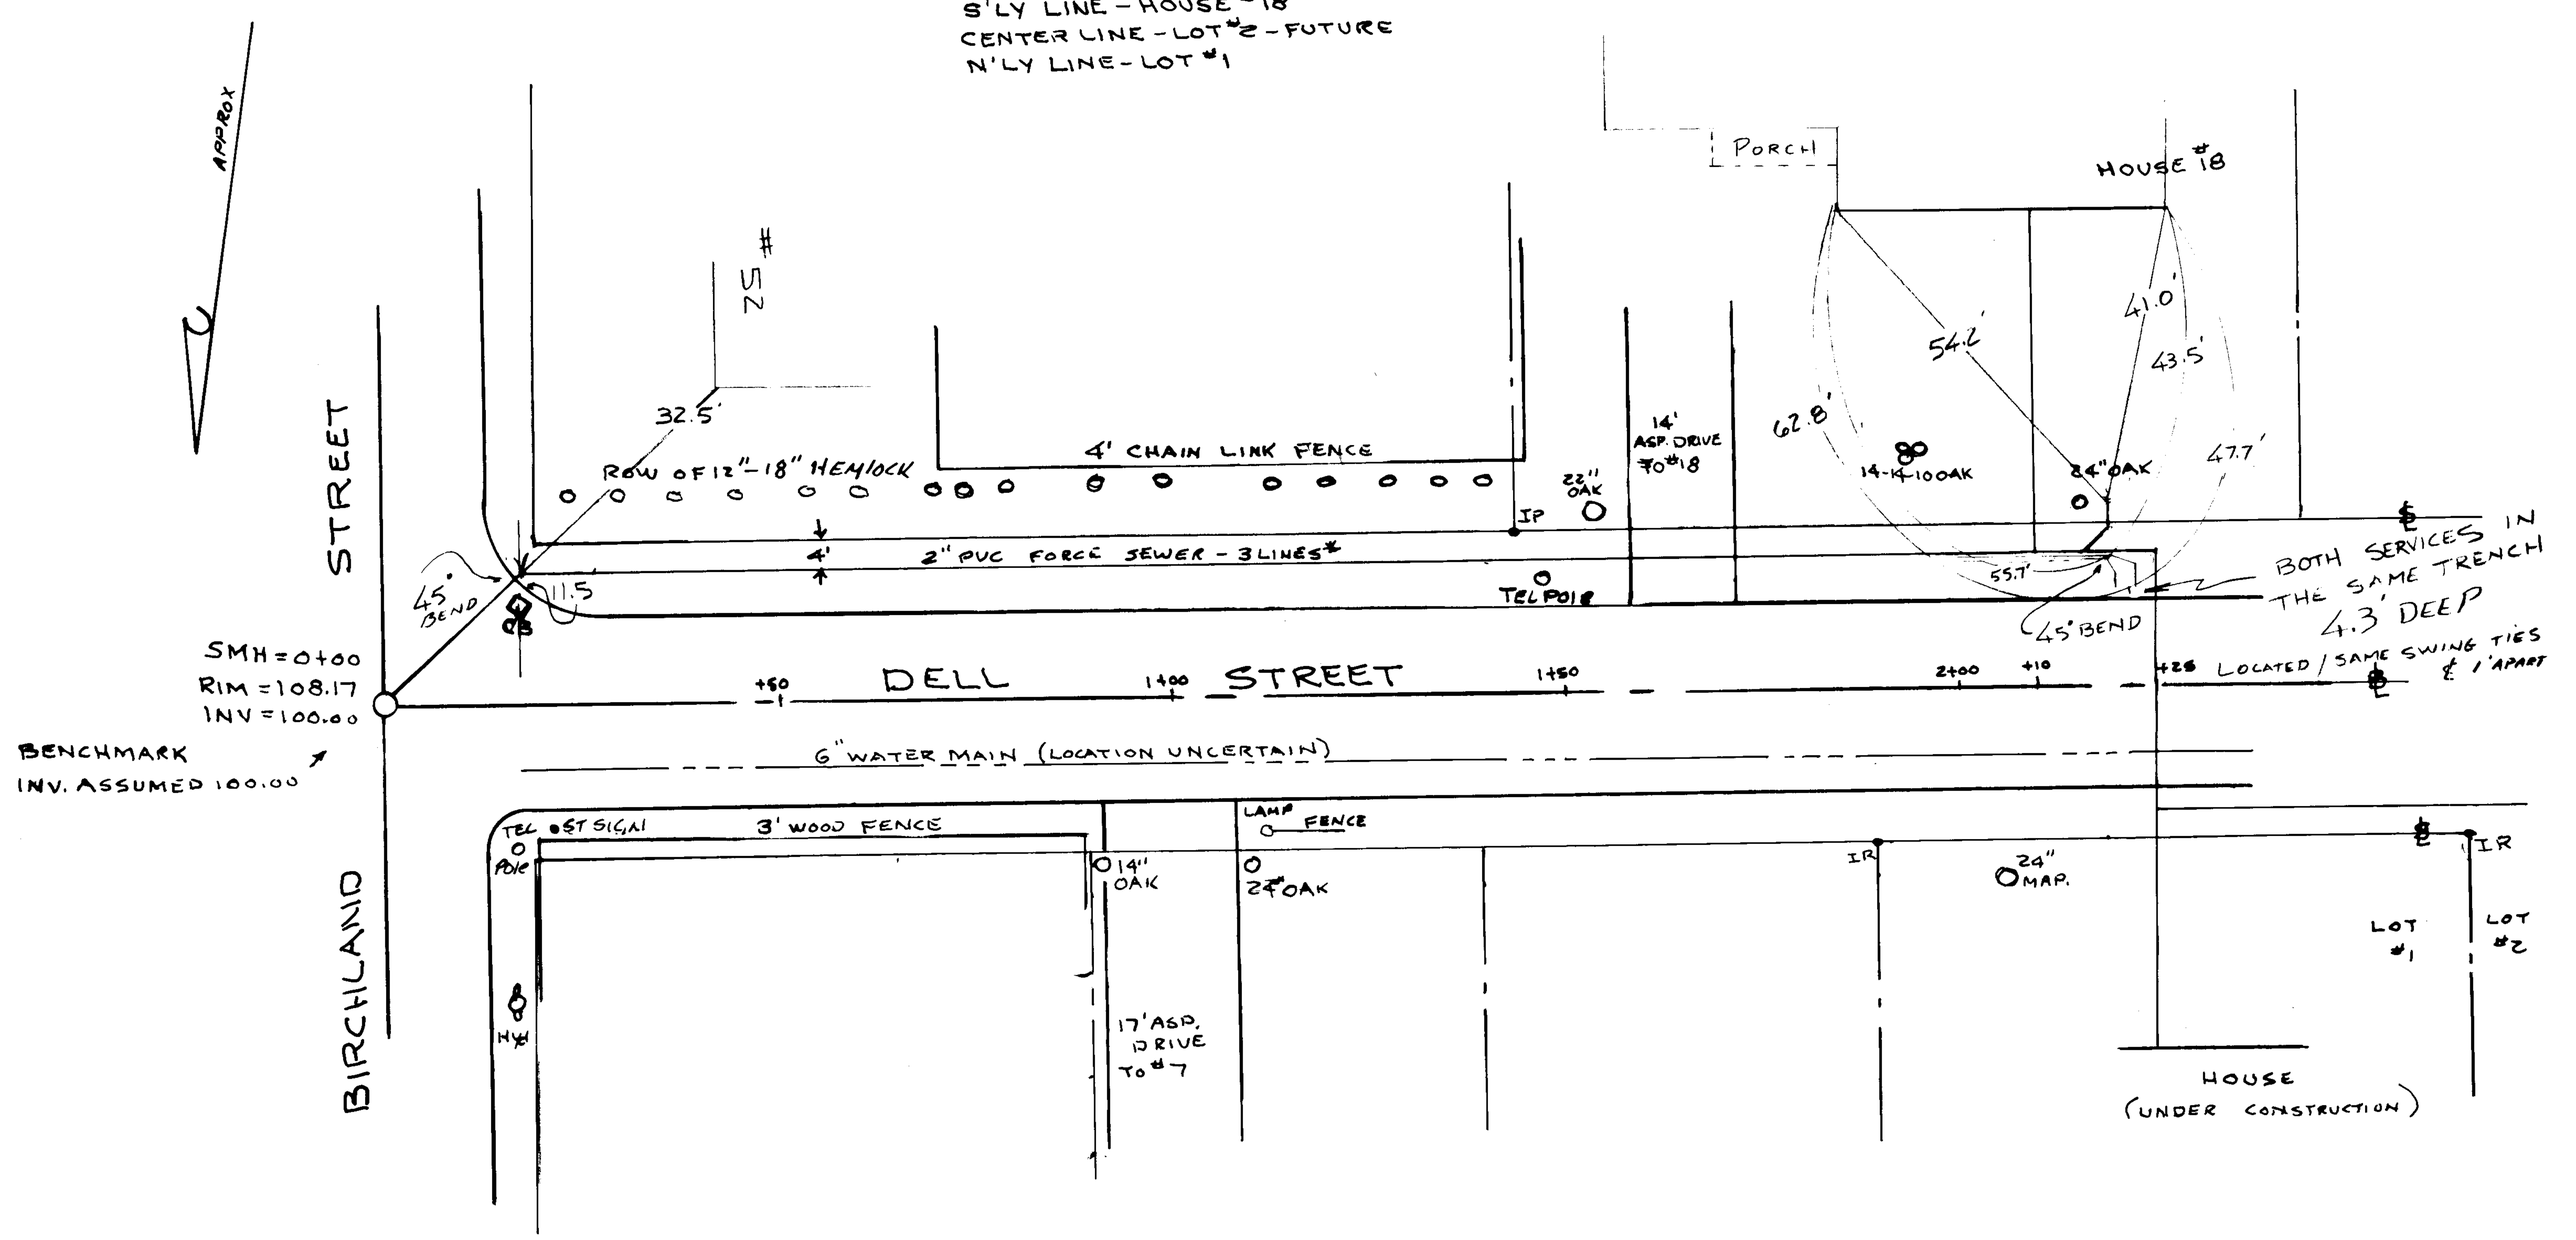

I CERTIFY THAT THIS PLAN HAS BEEN PREPARED IN CONFORMITY WITH THE RULES AND REGULATIONS OF THE REGISTERS OF DEEDS OF THE COMMONWEALTH OF MASSACHUSETTS.

MAINTAIN 5' COVER OVER 2" PVC AT ALL TIMES.
ANY ASP. TO BE REPLACED TO TOWN STANDARDS.
ALL MATERIALS AND METHODS TO ADHERE TO TOWN OF EAST LONGMEADOW SPECIFICATIONS.

PROPOSED FORCE SEWER	
DELL STREET	
HOR 1" = 20' VERT 1" = 6'	DEC. 1989

SS 420