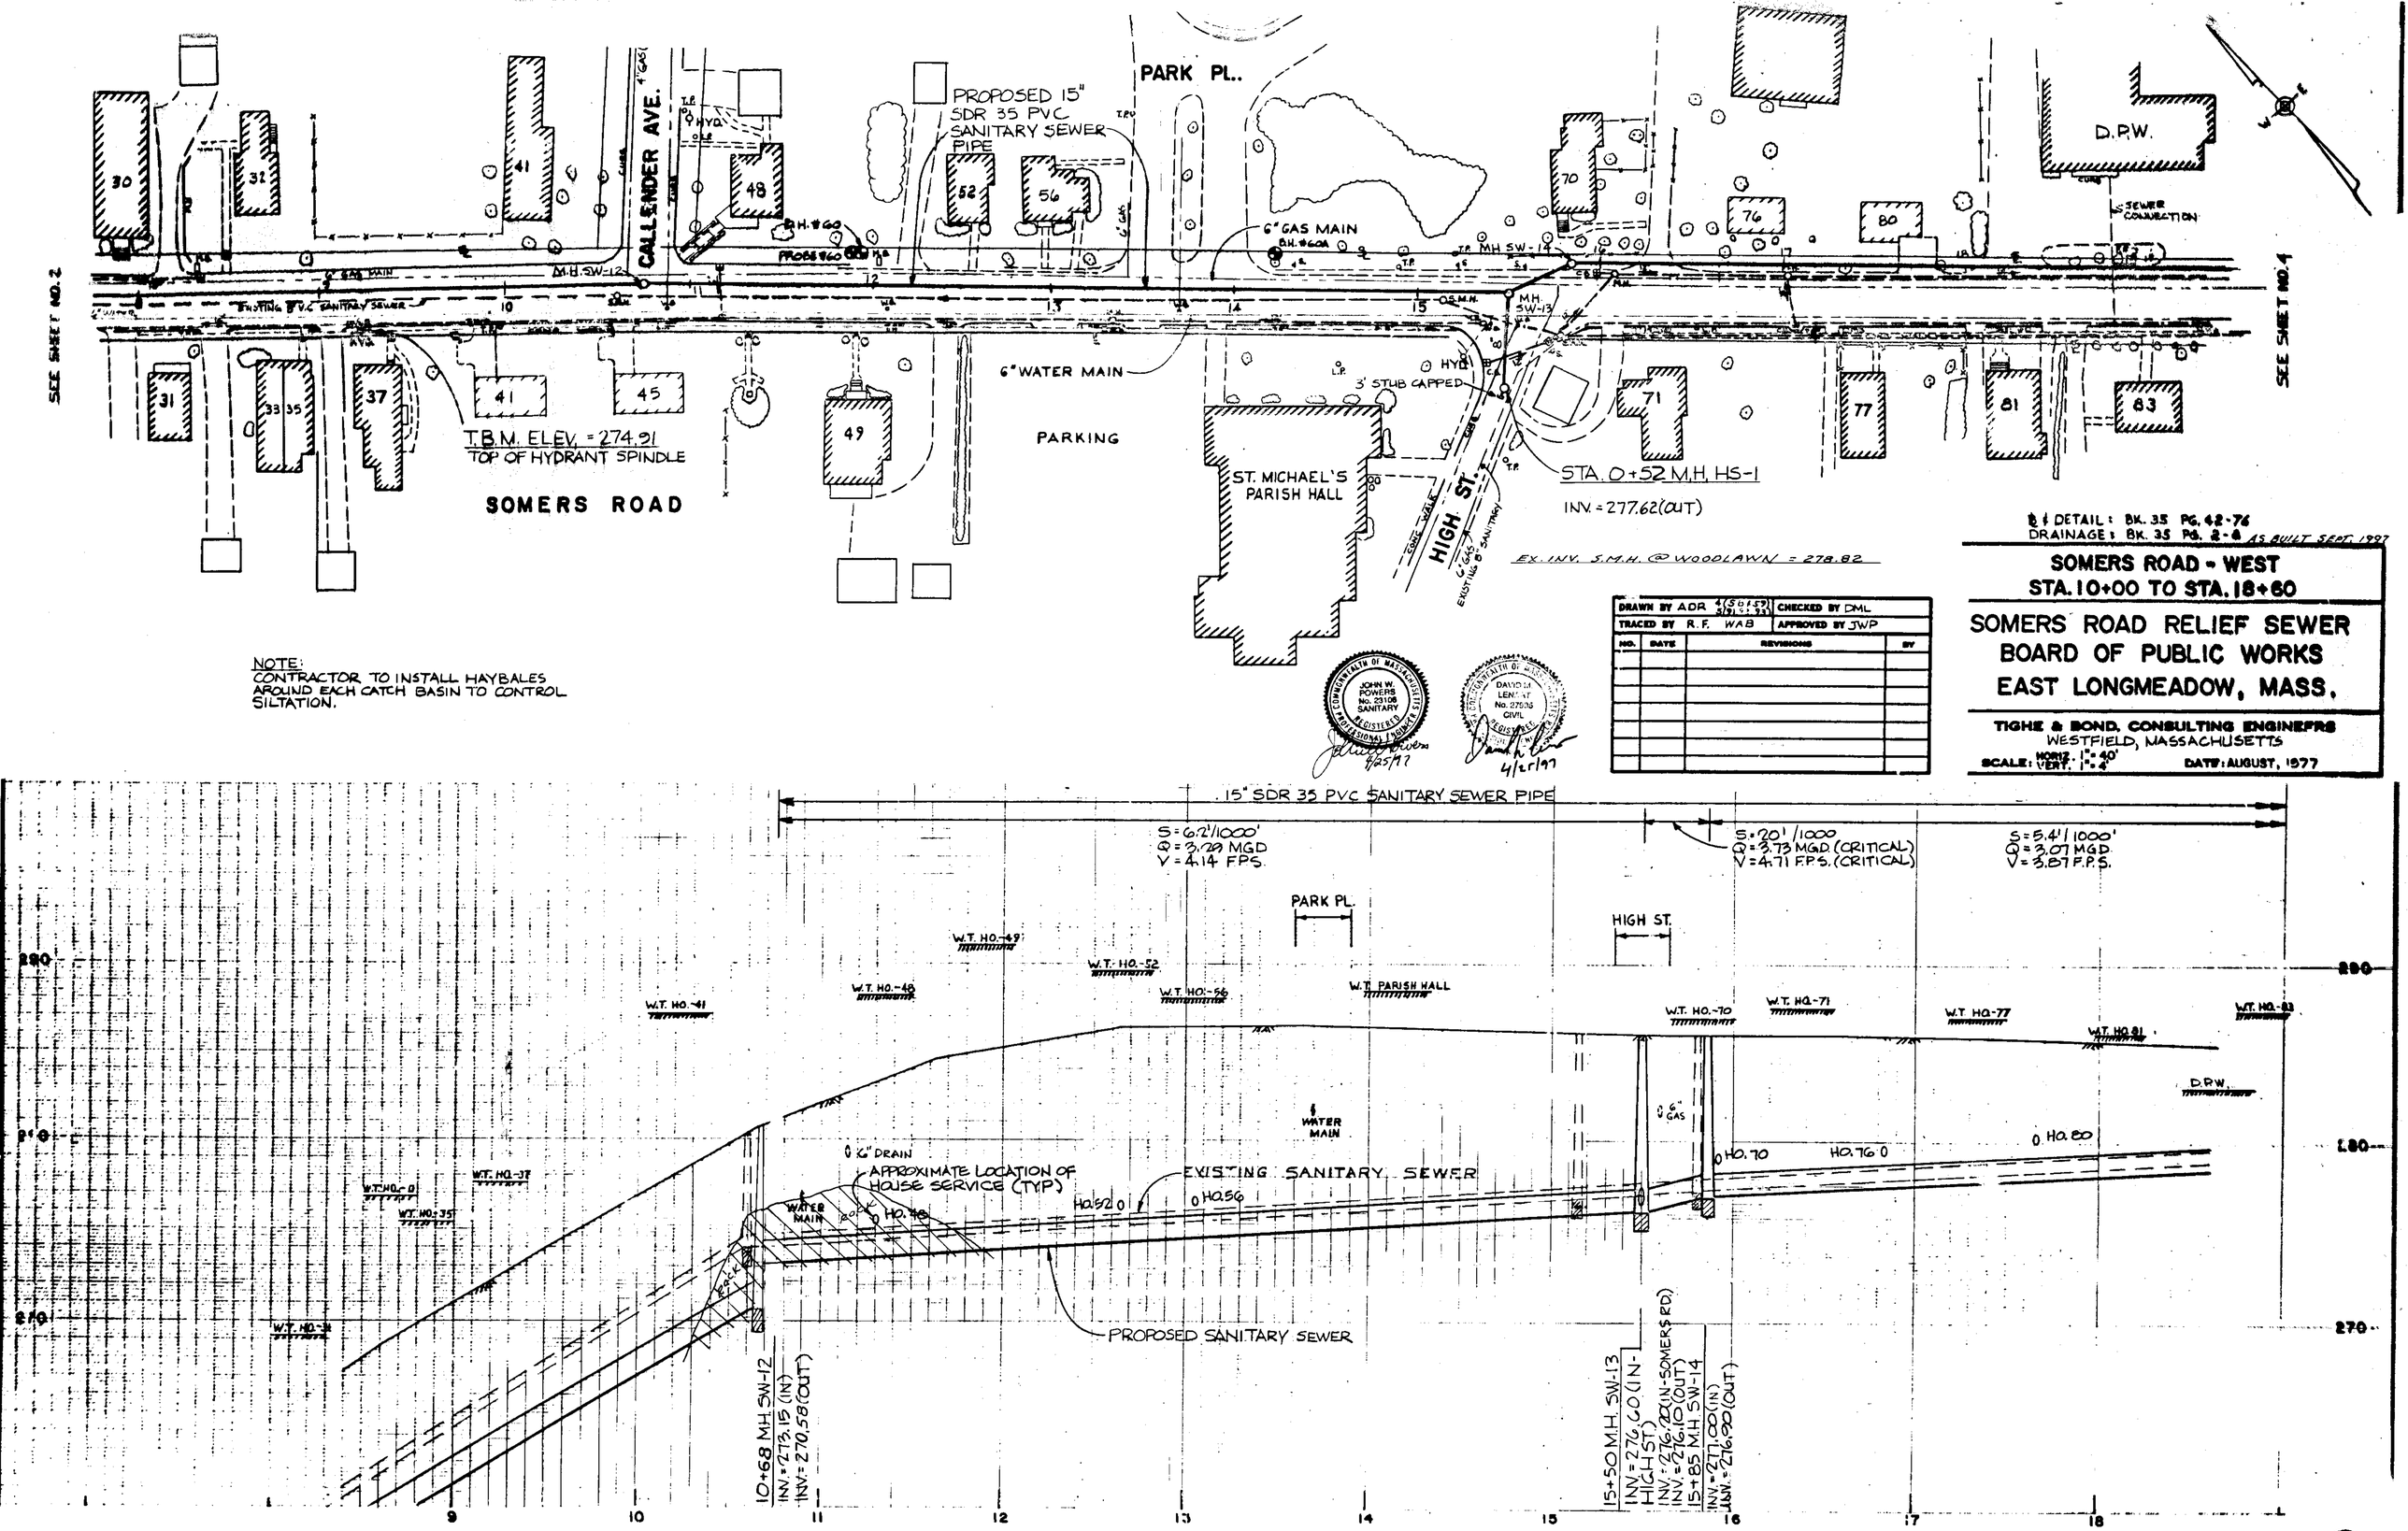

B & DETAIL: BK. 35 PG. 42-76
DRAINAGE: BK. 35 PG. 2-8 AS BUILT SEPT. 1997

DRAWN BY ADR	CHECKED BY DML
TRACED BY R.F. WAB	APPROVED BY JWP

NO.	DATE	REVISIONS	BY

SOMERS ROAD - WEST
STA. 10+00 TO STA. 18+60

SOMERS ROAD RELIEF SEWER
BOARD OF PUBLIC WORKS
EAST LONGMEADOW, MASS.

TIGHE & BOND, CONSULTING ENGINEERS
WESTFIELD, MASSACHUSETTS
SCALE: HORIZ. 1" = 40' VERT. 1" = 4'
DATE: AUGUST, 1977

SS-455