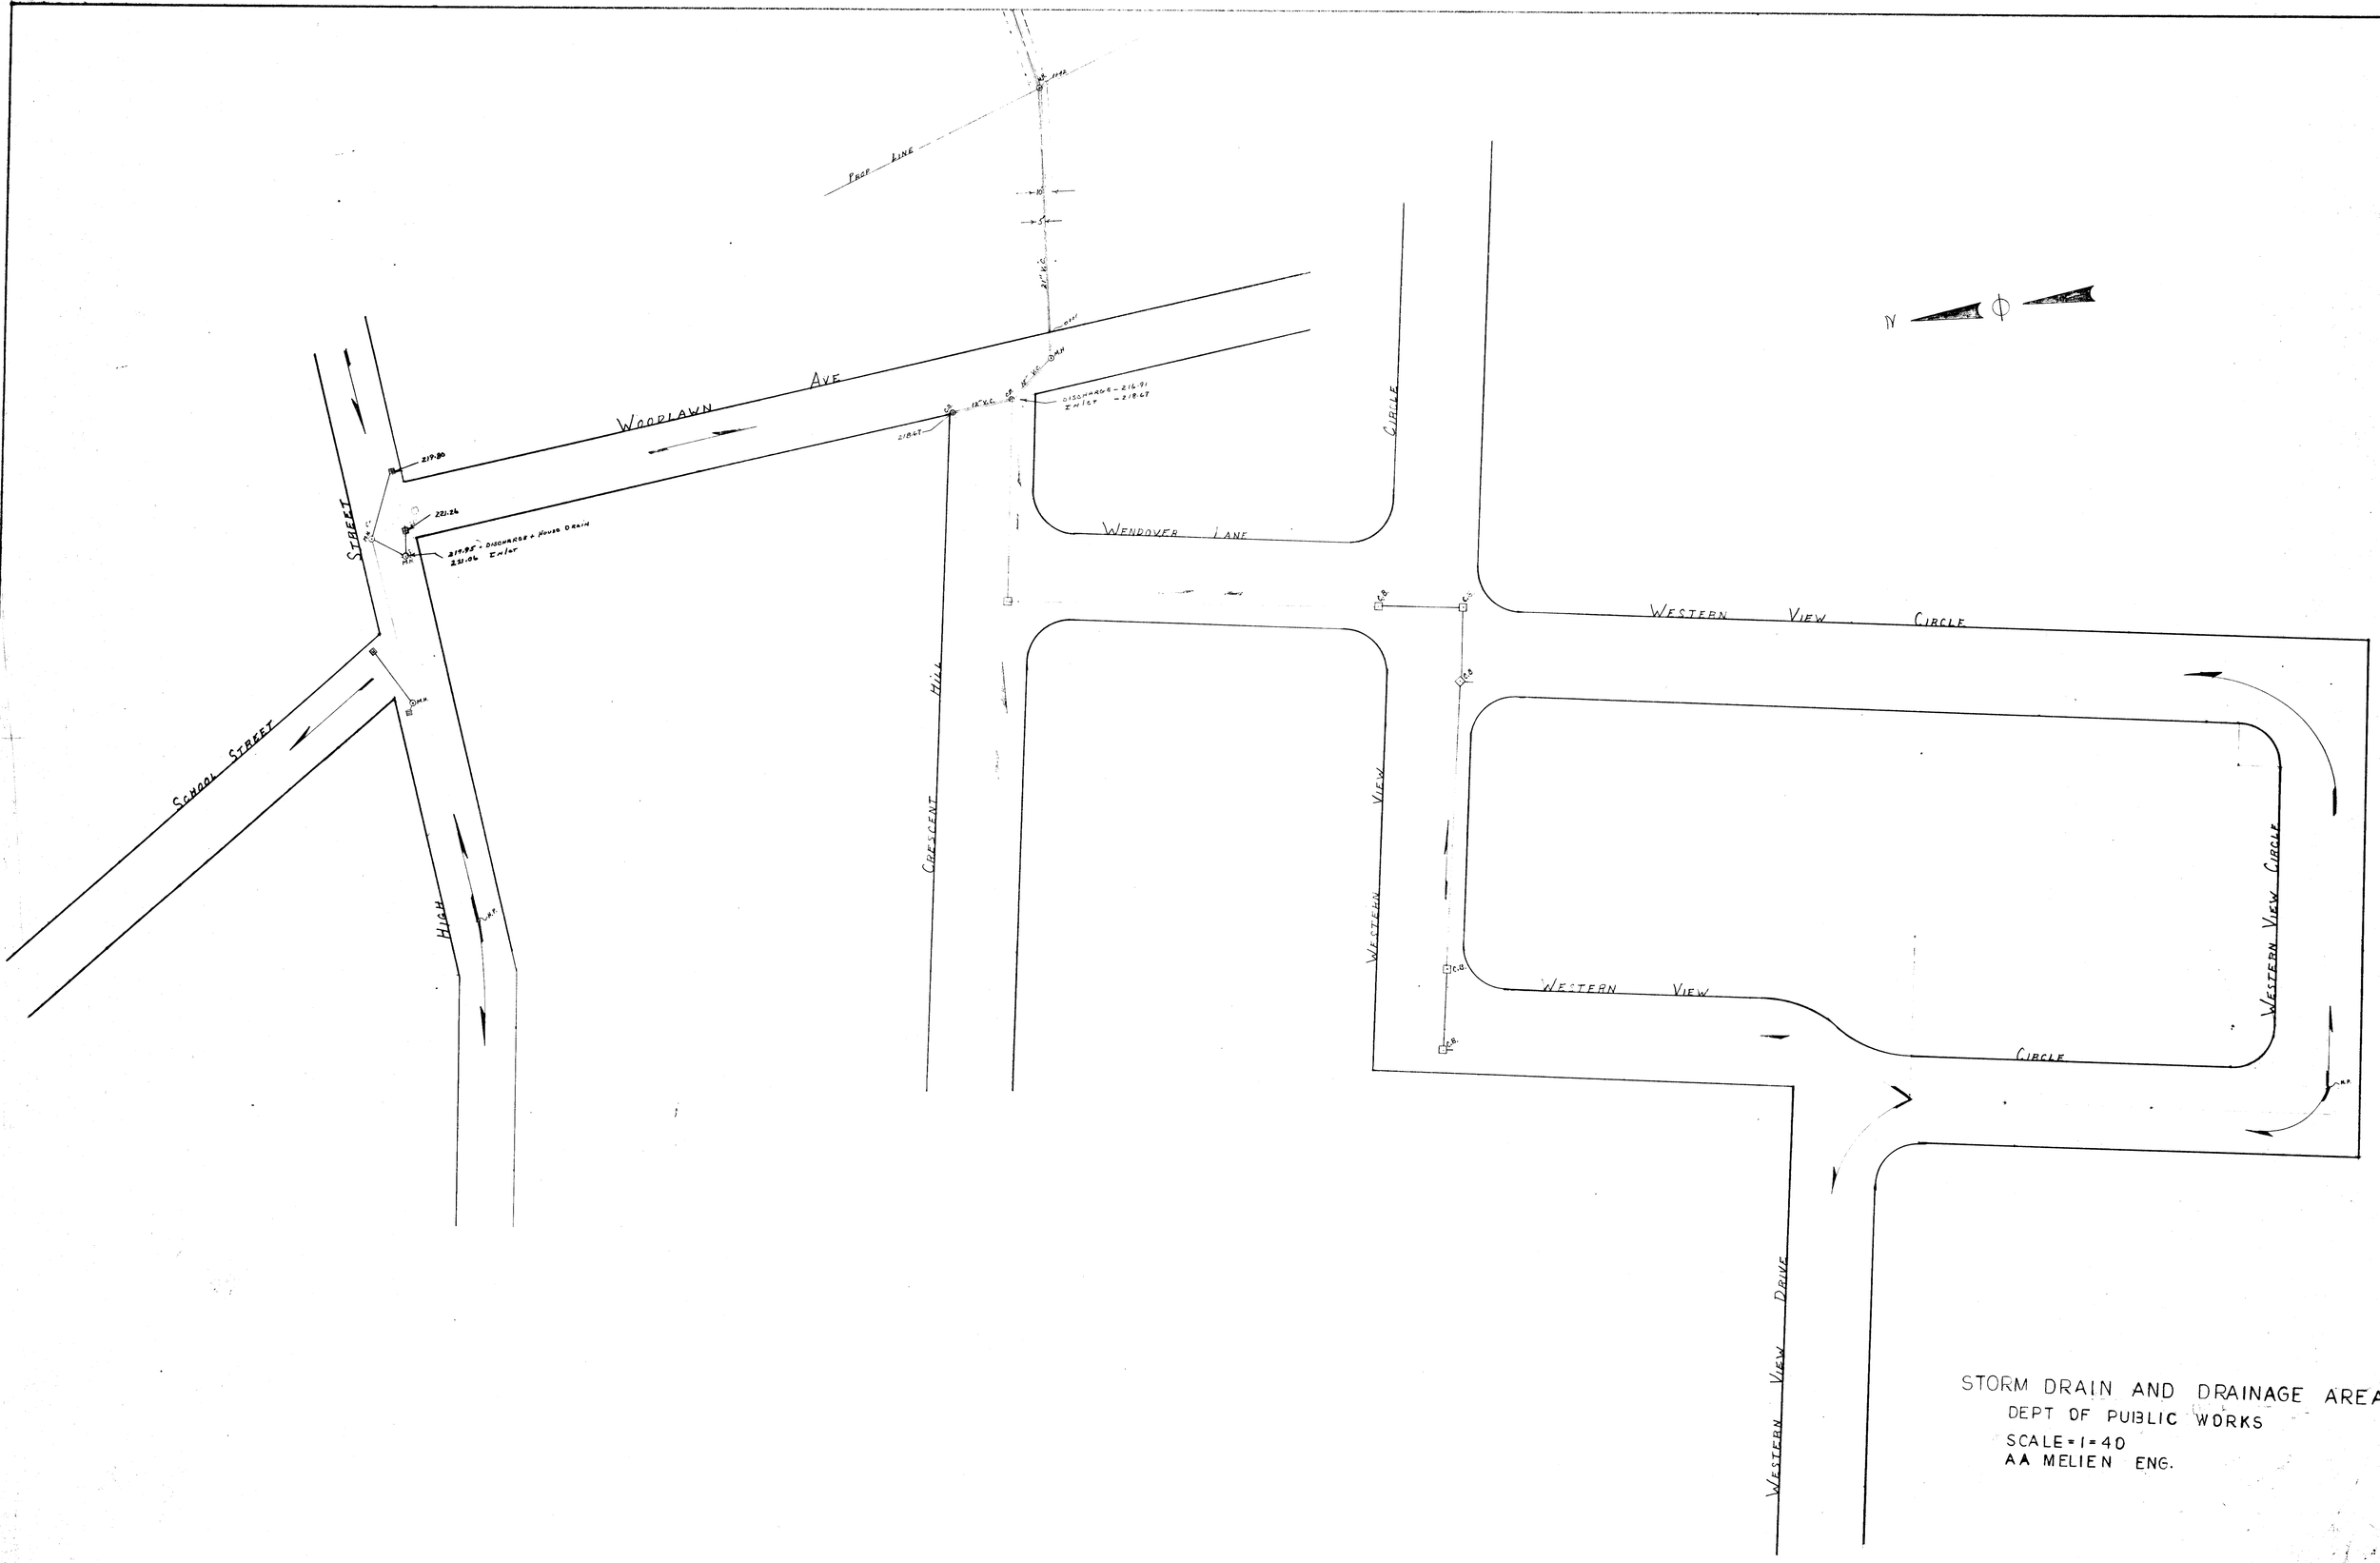
PROP LINE
WOODLAWN AVE
STREET
SCHOOL STREET
HIGH
HILL
CRESCENT
WENDOVER LANE
CIRCLE
WESTERN VIEW CIRCLE
WESTERN VIEW
WESTERN VIEW DRIVE
WESTERN VIEW CIRCLE
CIRCLE
N
219.80
221.24
219.95 - DISCHARGE x HOUSE DRAIN
221.06 - INLET
218.67
DISCHARGE - 216.91
INLET - 218.67
STORM DRAIN AND DRAINAGE AREA
DEPT OF PUIBLIC WORKS
SCALE = 1 = 40
AA MELIEN ENG.

SD #6