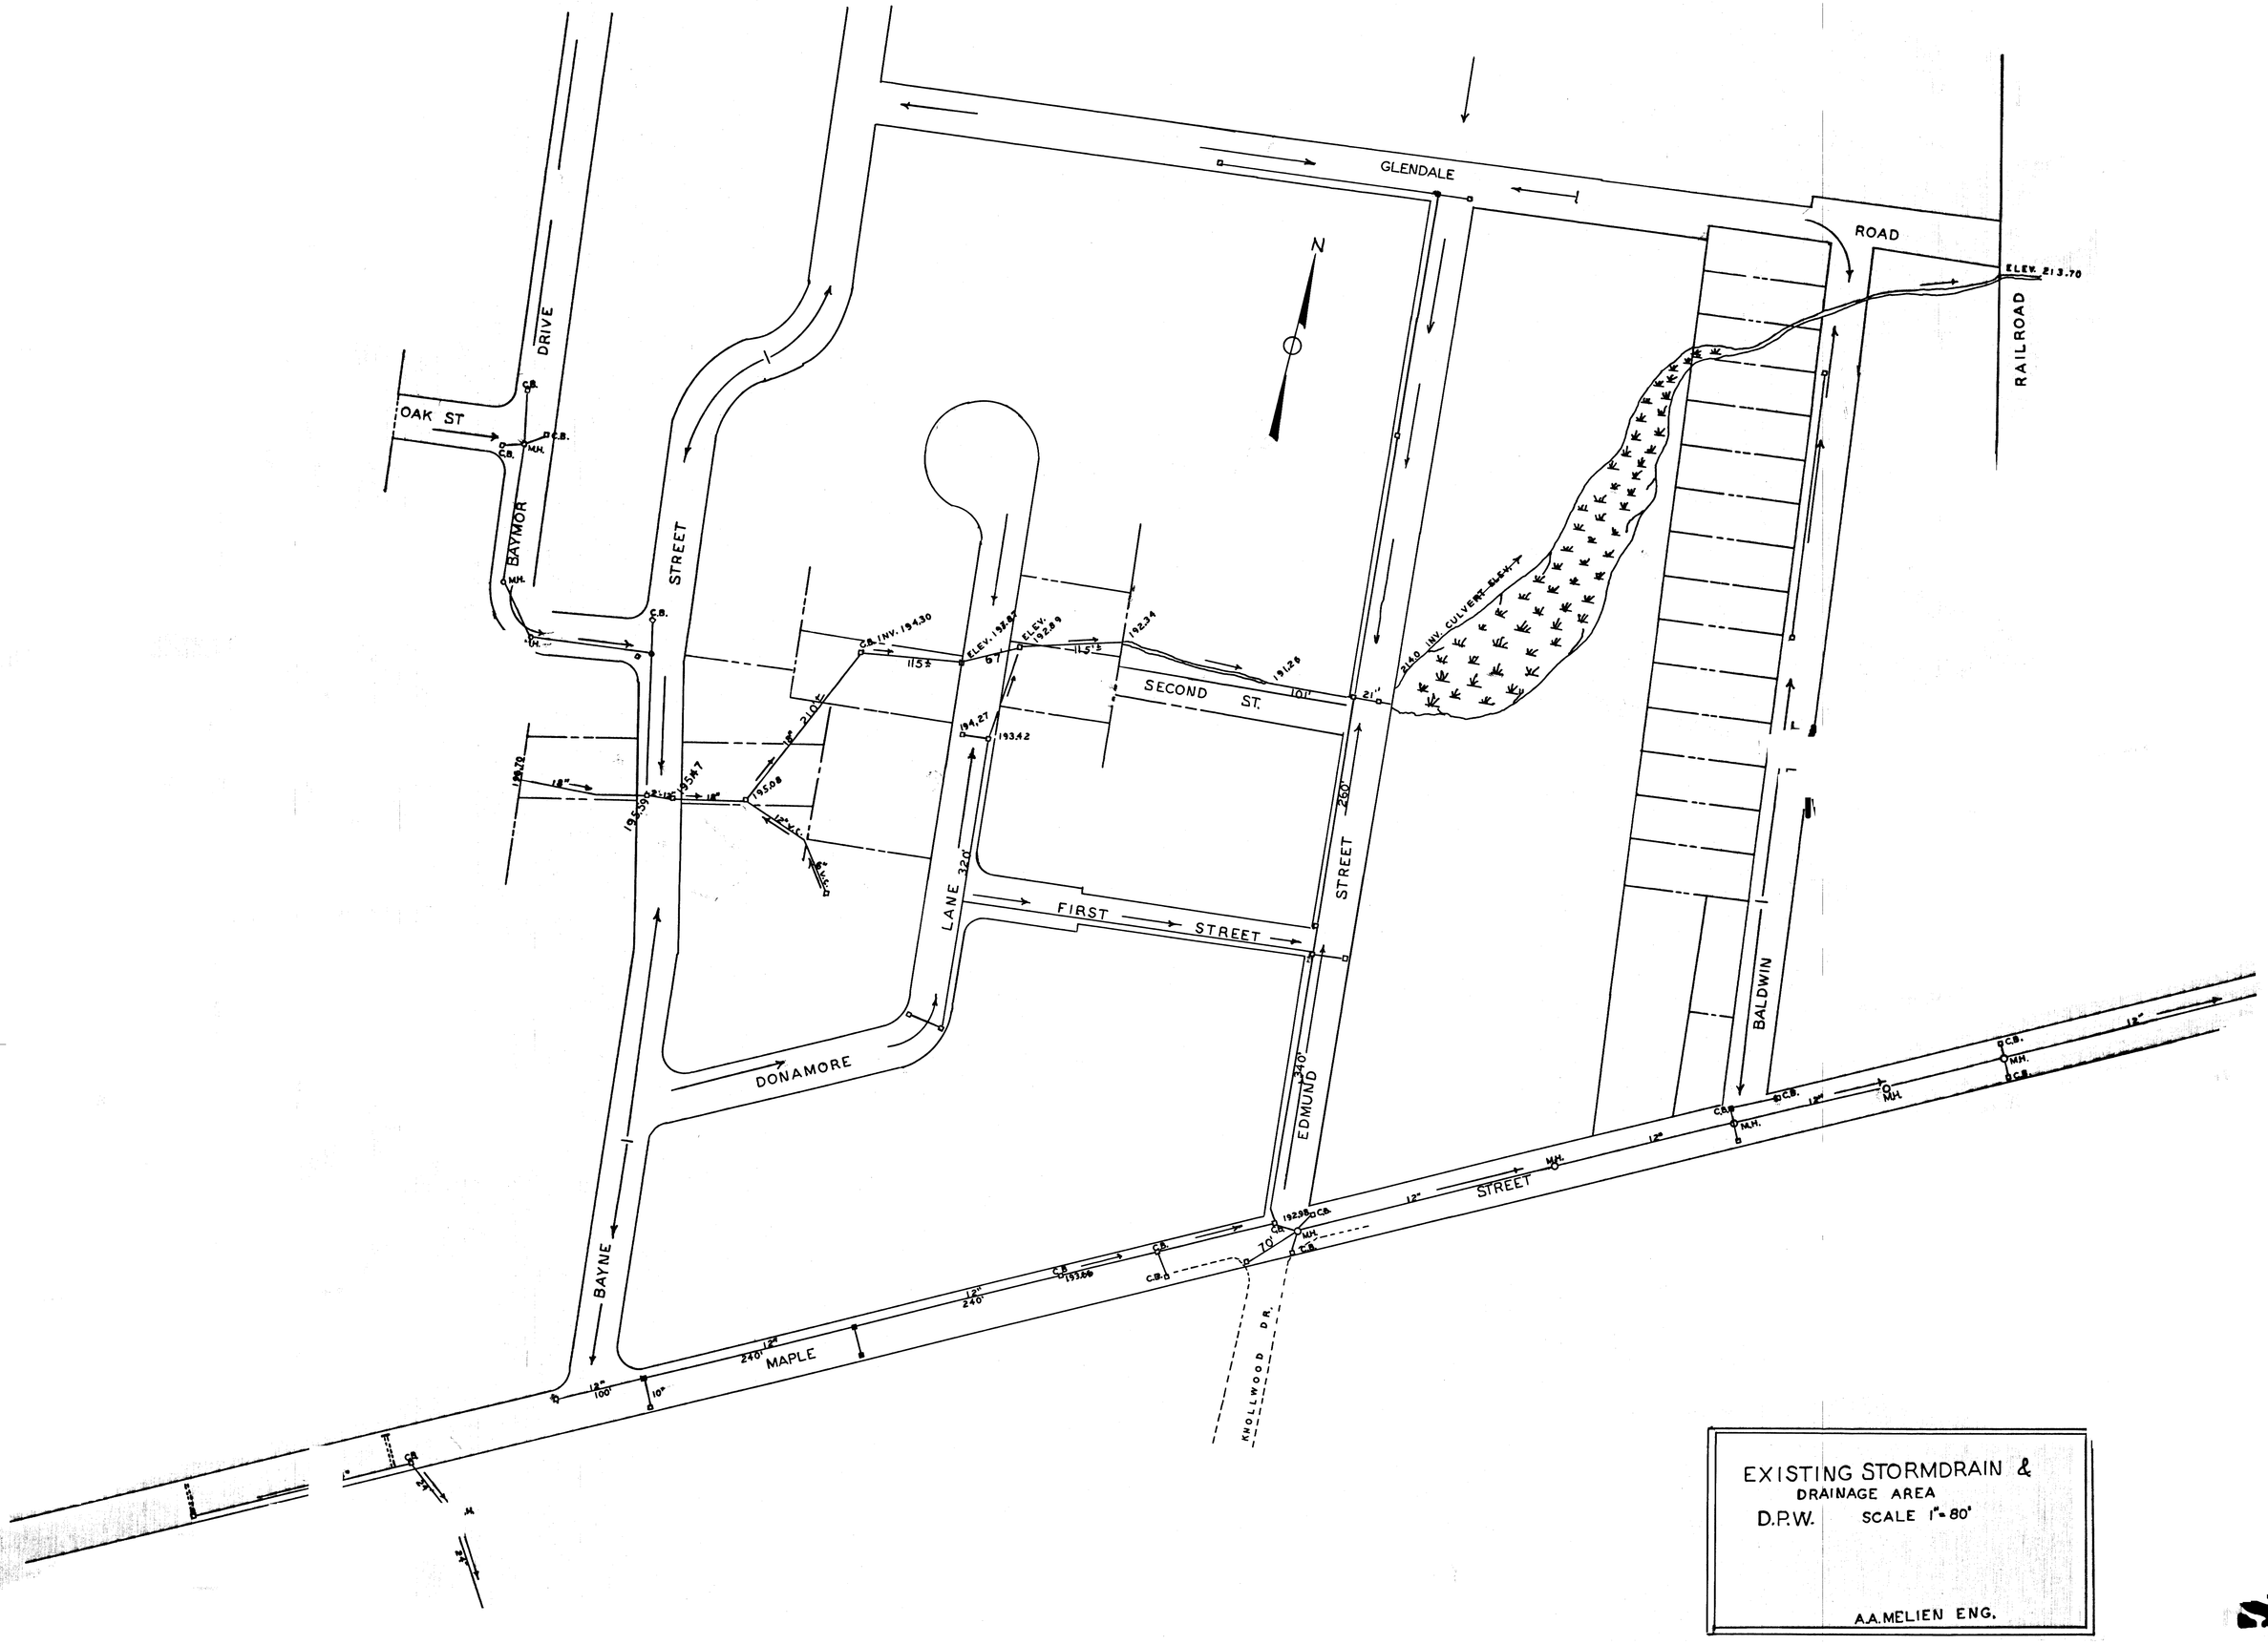

EXISTING STORMDRAIN &
DRAINAGE AREA
D.P.W. SCALE 1" = 80'

A.A. MELIEN ENG.

SD-7