



CURVE DATA
CURVE R = 4287.66'
CURVE Δ = 5°-52'-30"
CURVE L ARC = 439.65'
CURVE C CH = 439.45'

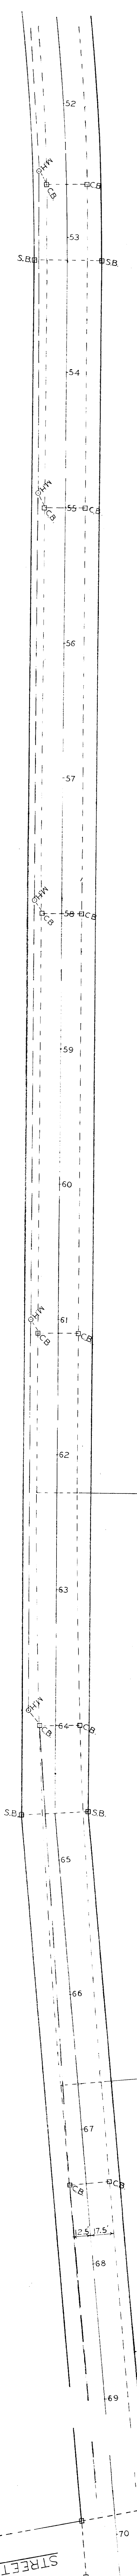

SCALE: 1" = 40' HORIZ.
1" = 4' VERT.

RENCH: STA. 65+66-26.3 RT - VERT SPIKE IN ROUT 20M - ELEV 226.64

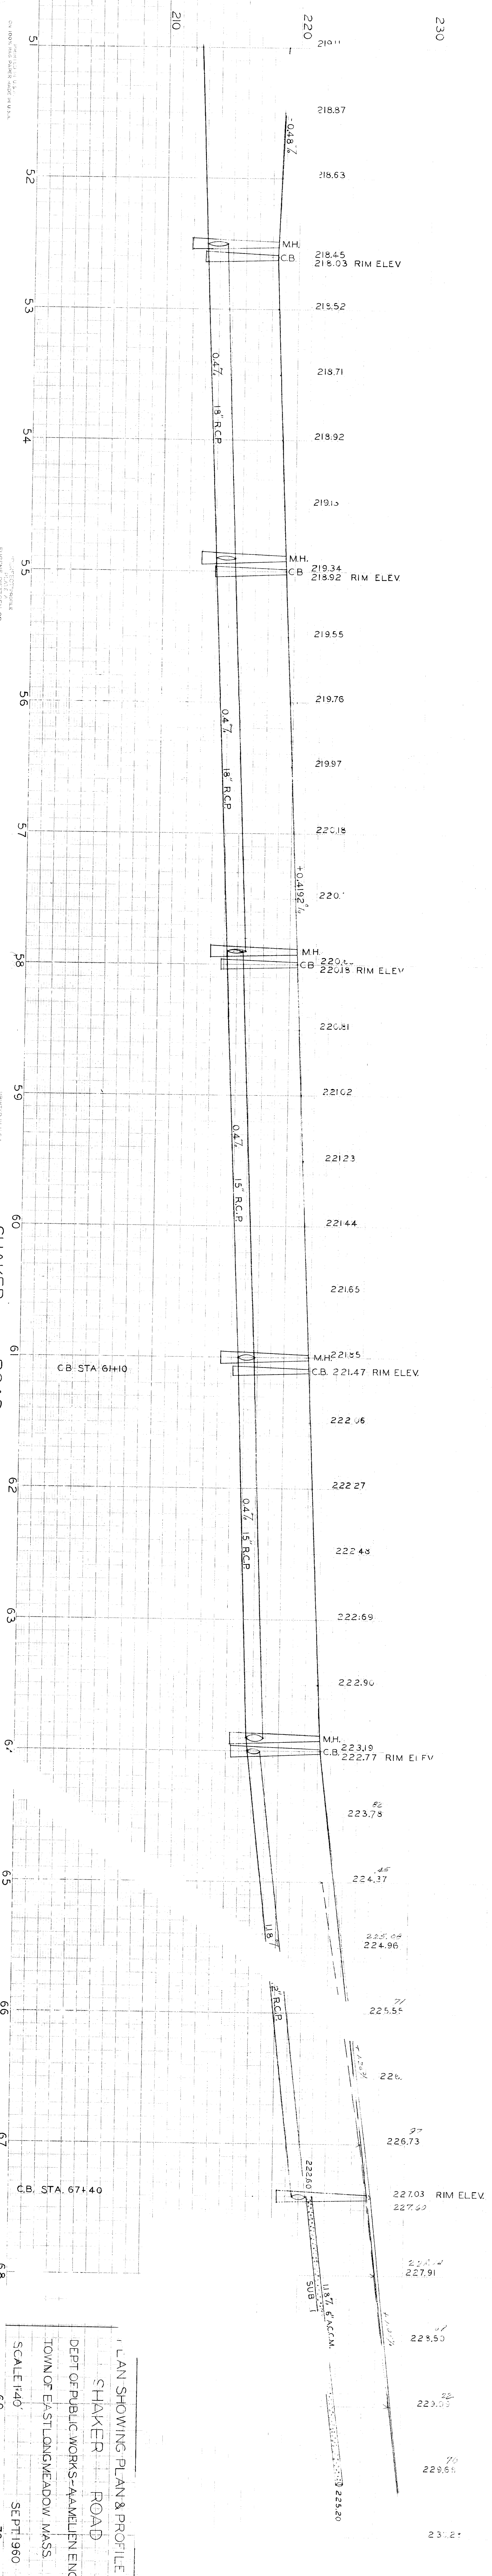

PLAN SHOWING PLAN & PROFILE
SHAKER ROAD
DEPT OF PUBLIC WORKS - AAMLEN ENG.
TOWN OF EAST LONGMEADOW, MASS.
SCALE 1" = 40'
SEPT 1960