


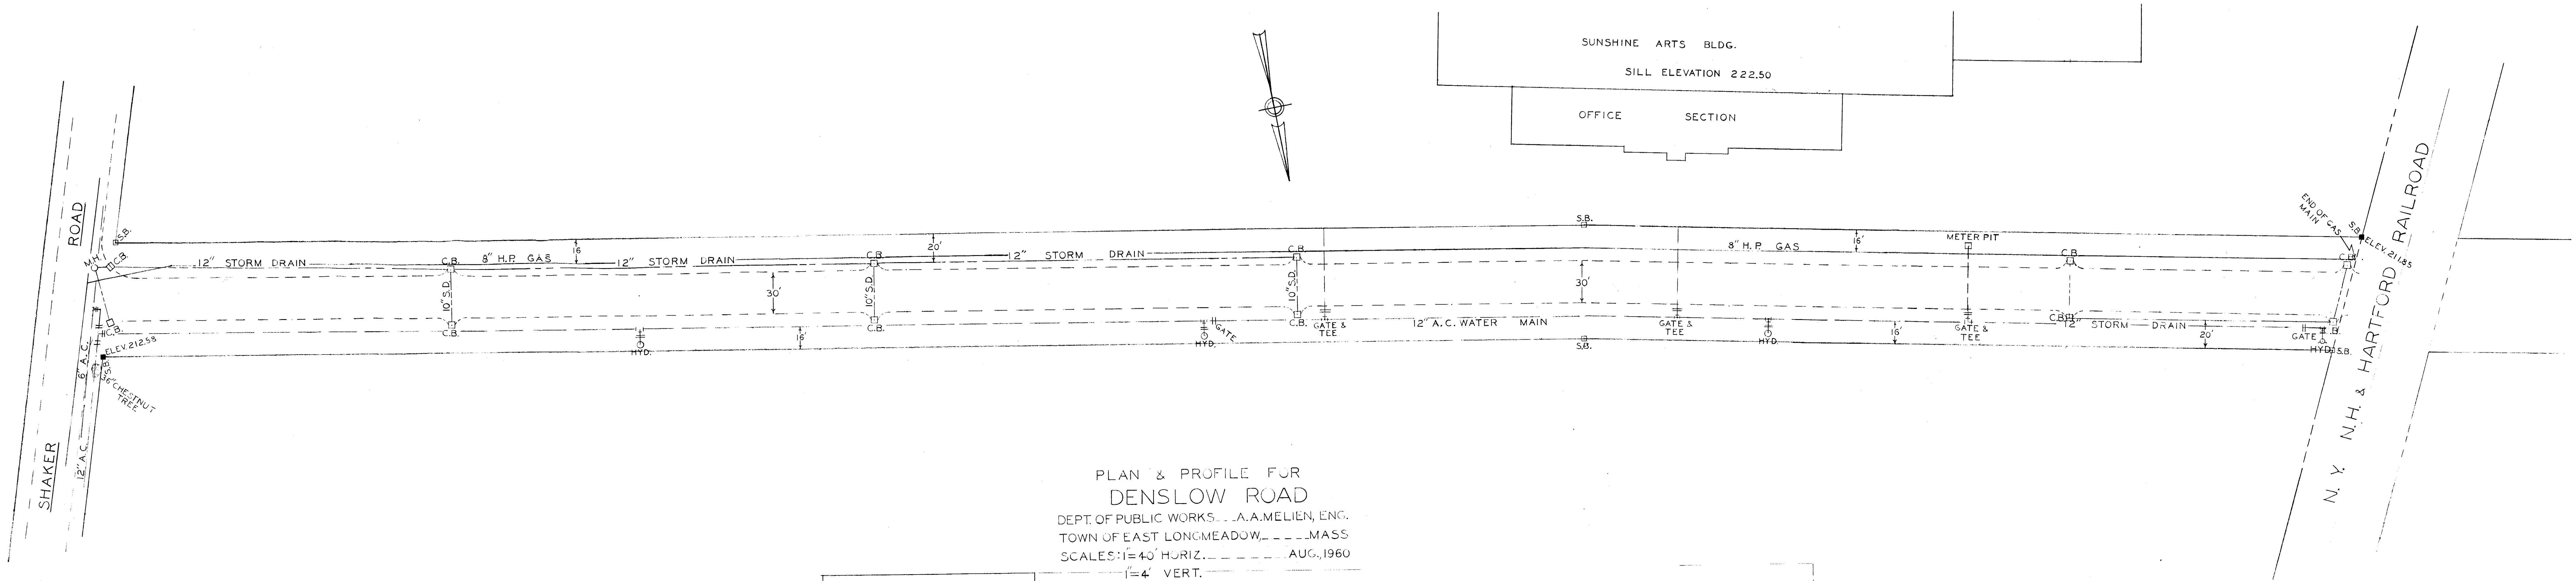

BENCH: R.R. SPIKE (HORIZ) IN 36 CHESTNUT TR. I.W. COR. DENSLOW RD & SHAKER RD - ELEV. 213.41

PHASE ①
MILTON BRADLEY CO.

