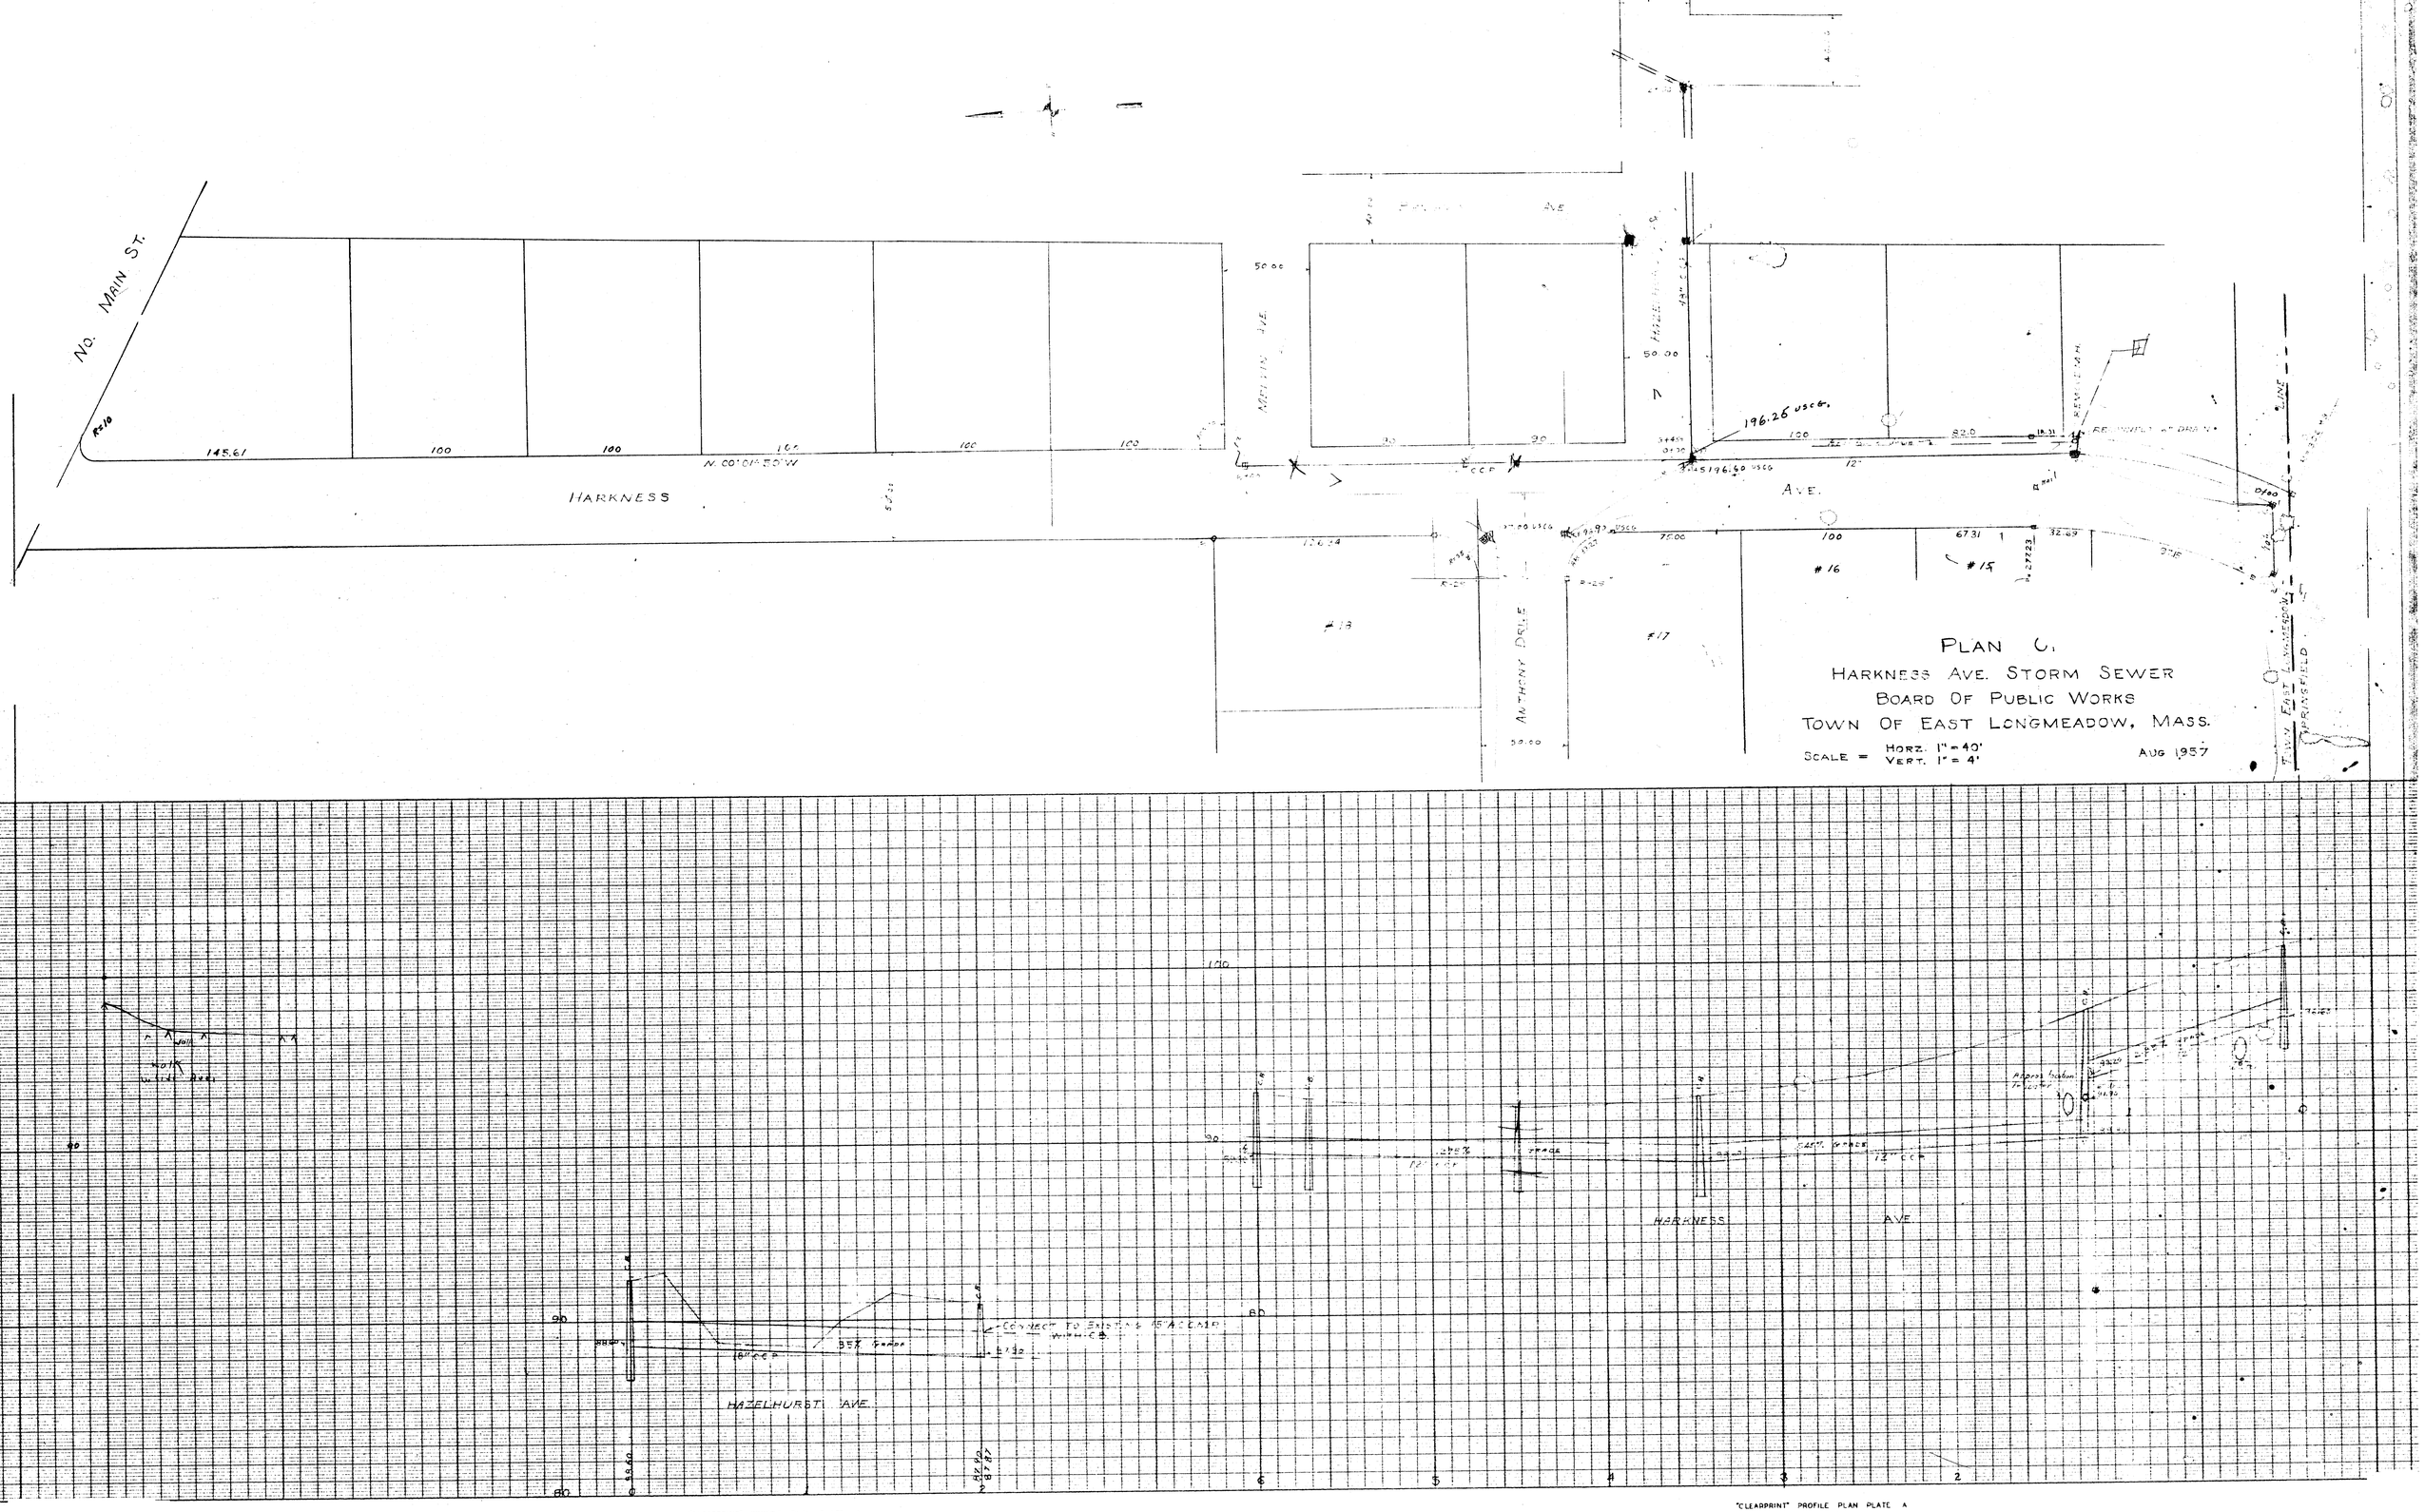

"CLEARPRINT" PROFILE PLAN PLATE A
DIETERICH—POST CO.
MADE IN U.S.A.

"CLEARPRINT" PROFILE PLAN PLATE A
DIETERICH—P"
MADE

SD 16