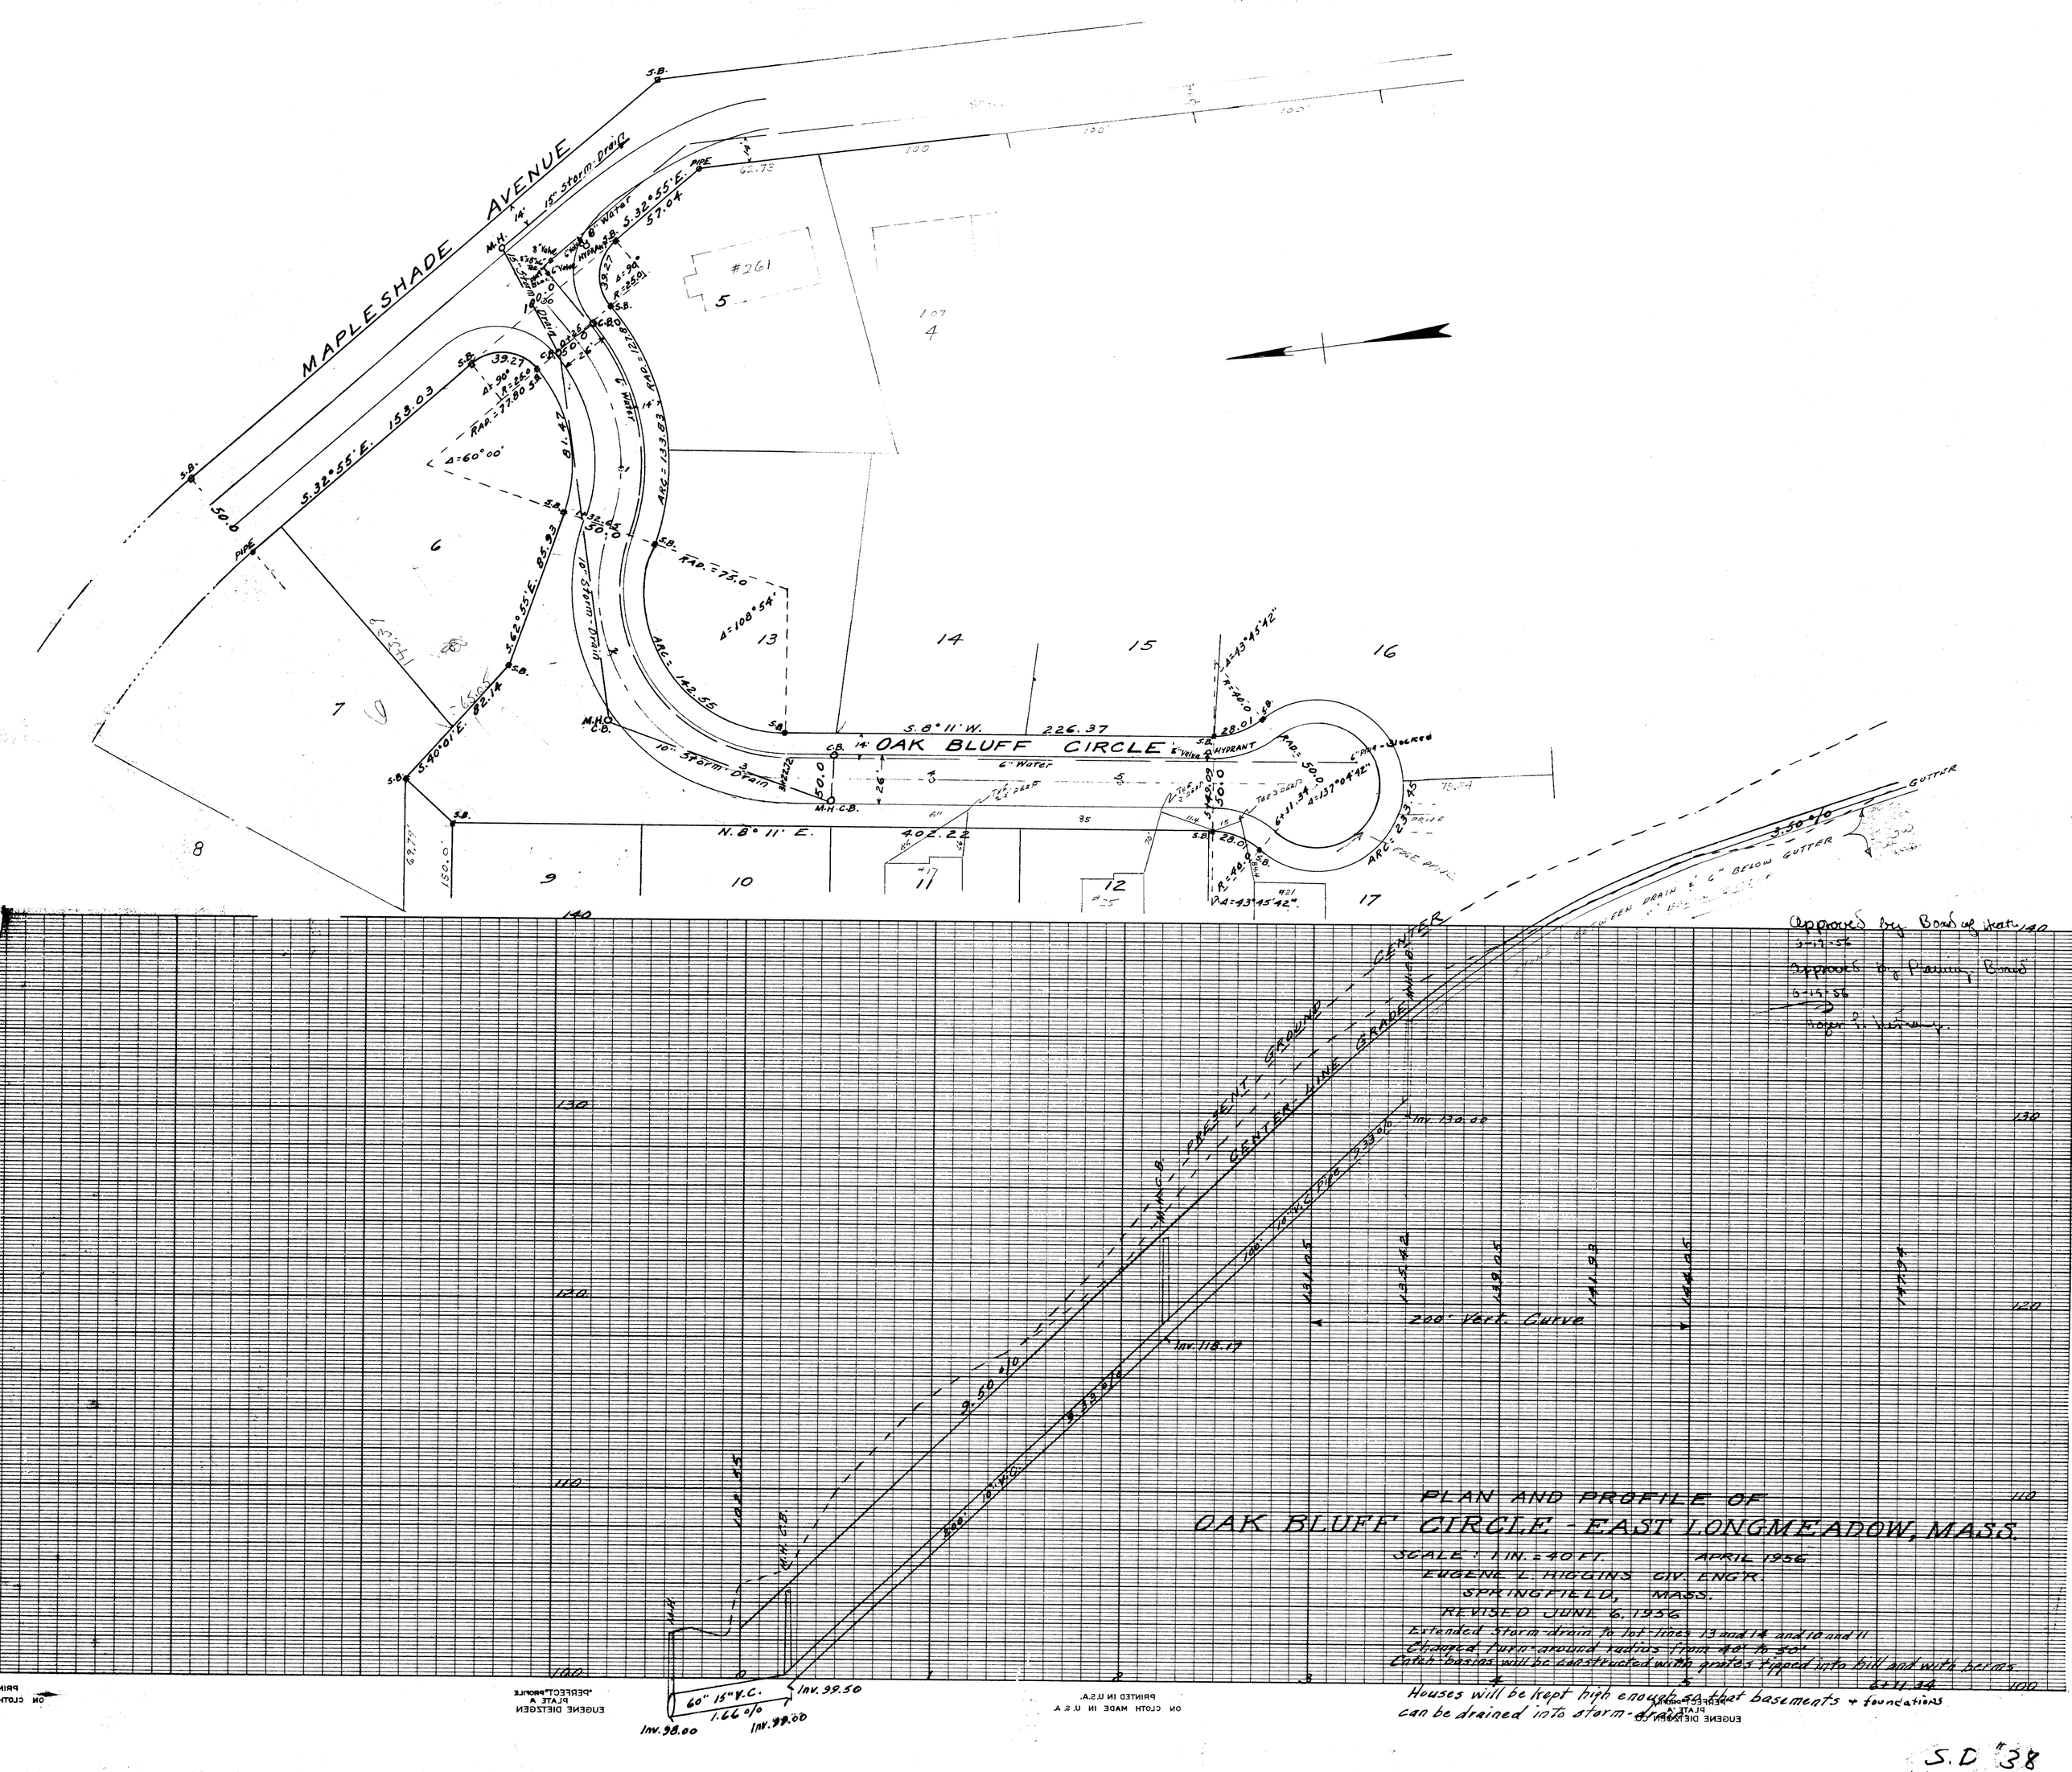

PLAN AND PROFILE OF
OAK BLUFF CIRCLE - EAST LONGMEADOW, MASS.

SCALE: 1 IN. = 40 FT. APRIL 1956
EUGENE L. HIGGINS CIV. ENGR.
SPRINGFIELD, MASS.
REVISED JUNE 6, 1956
Extended Storm-drain to lot lines 13 and 14 and 10 and 11
Changed turn-around radius from 40' to 50'
Catch-basins will be constructed with grates tipped into hill and with berms
6-21-56
Houses will be kept high enough so that basements + foundations can be drained into storm-drain

S.D. #38