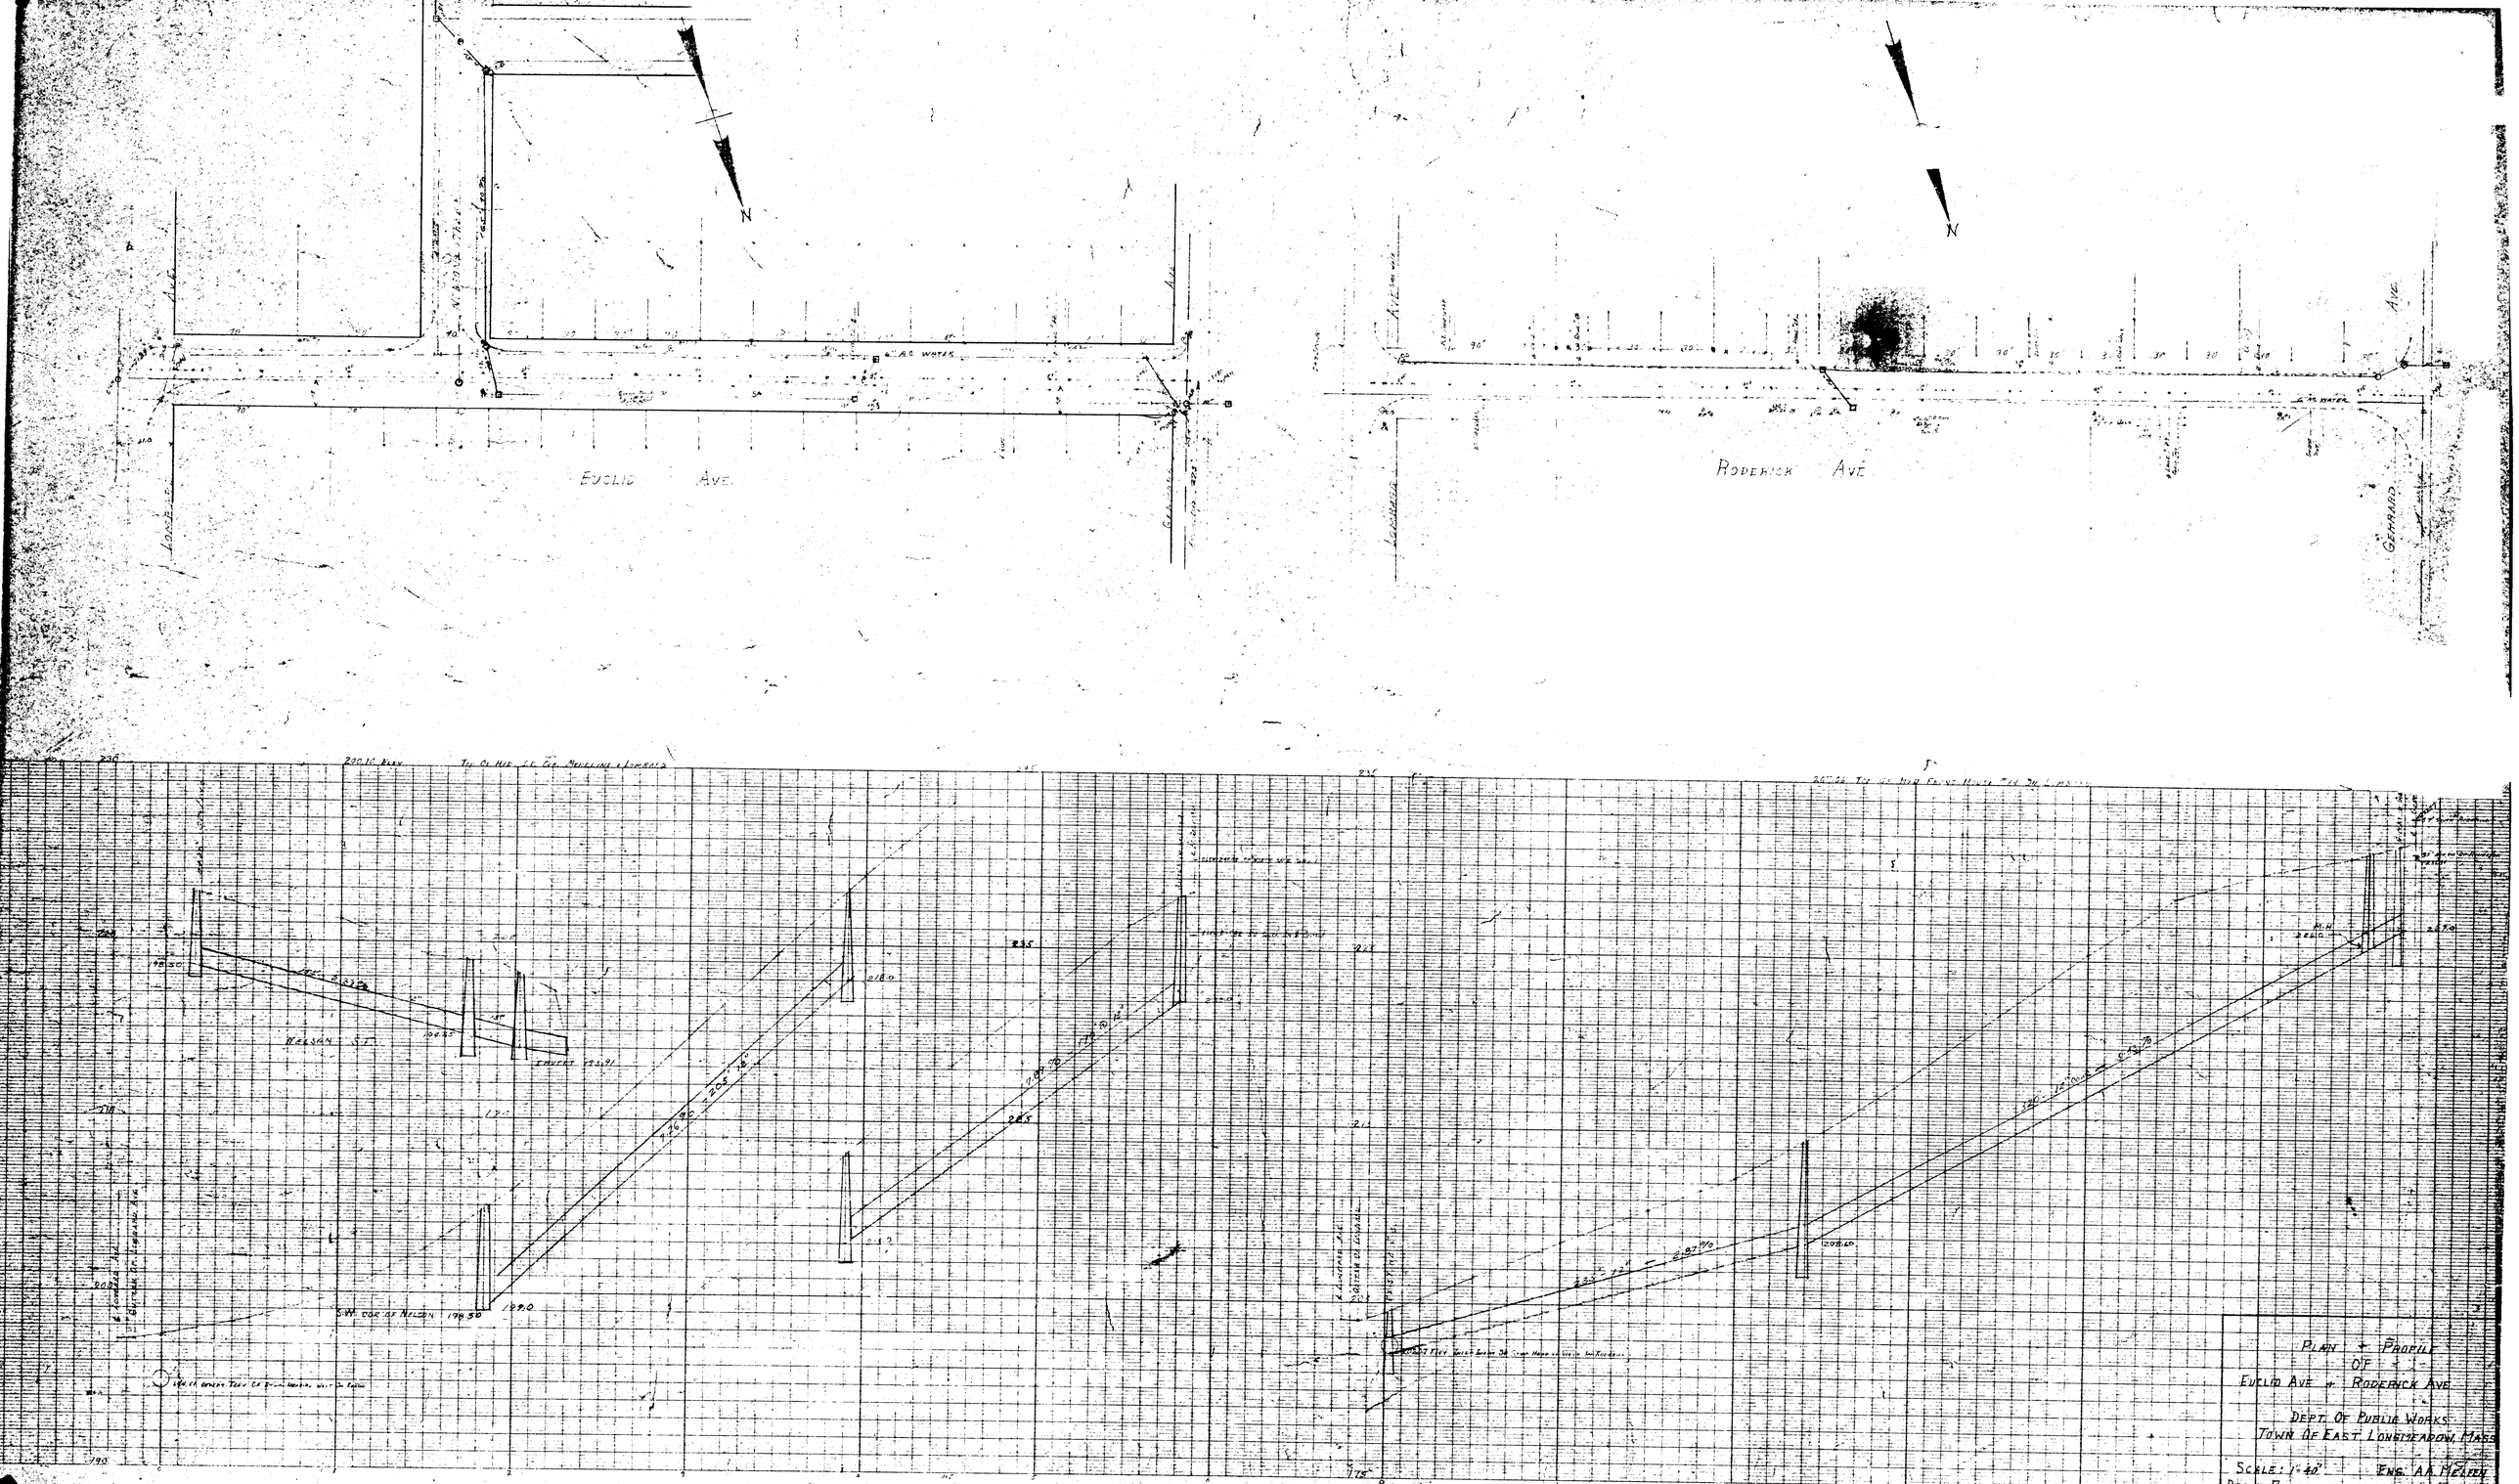

PERFECT PROFILE PLATE A EUGENE DIETZGEN CO.
PRINTED IN U.S.A. ON 100% RAG PAPER MADE IN U.S.A.
PERFECT PROFILE PLATE A EUGENE DIETZGEN CO.