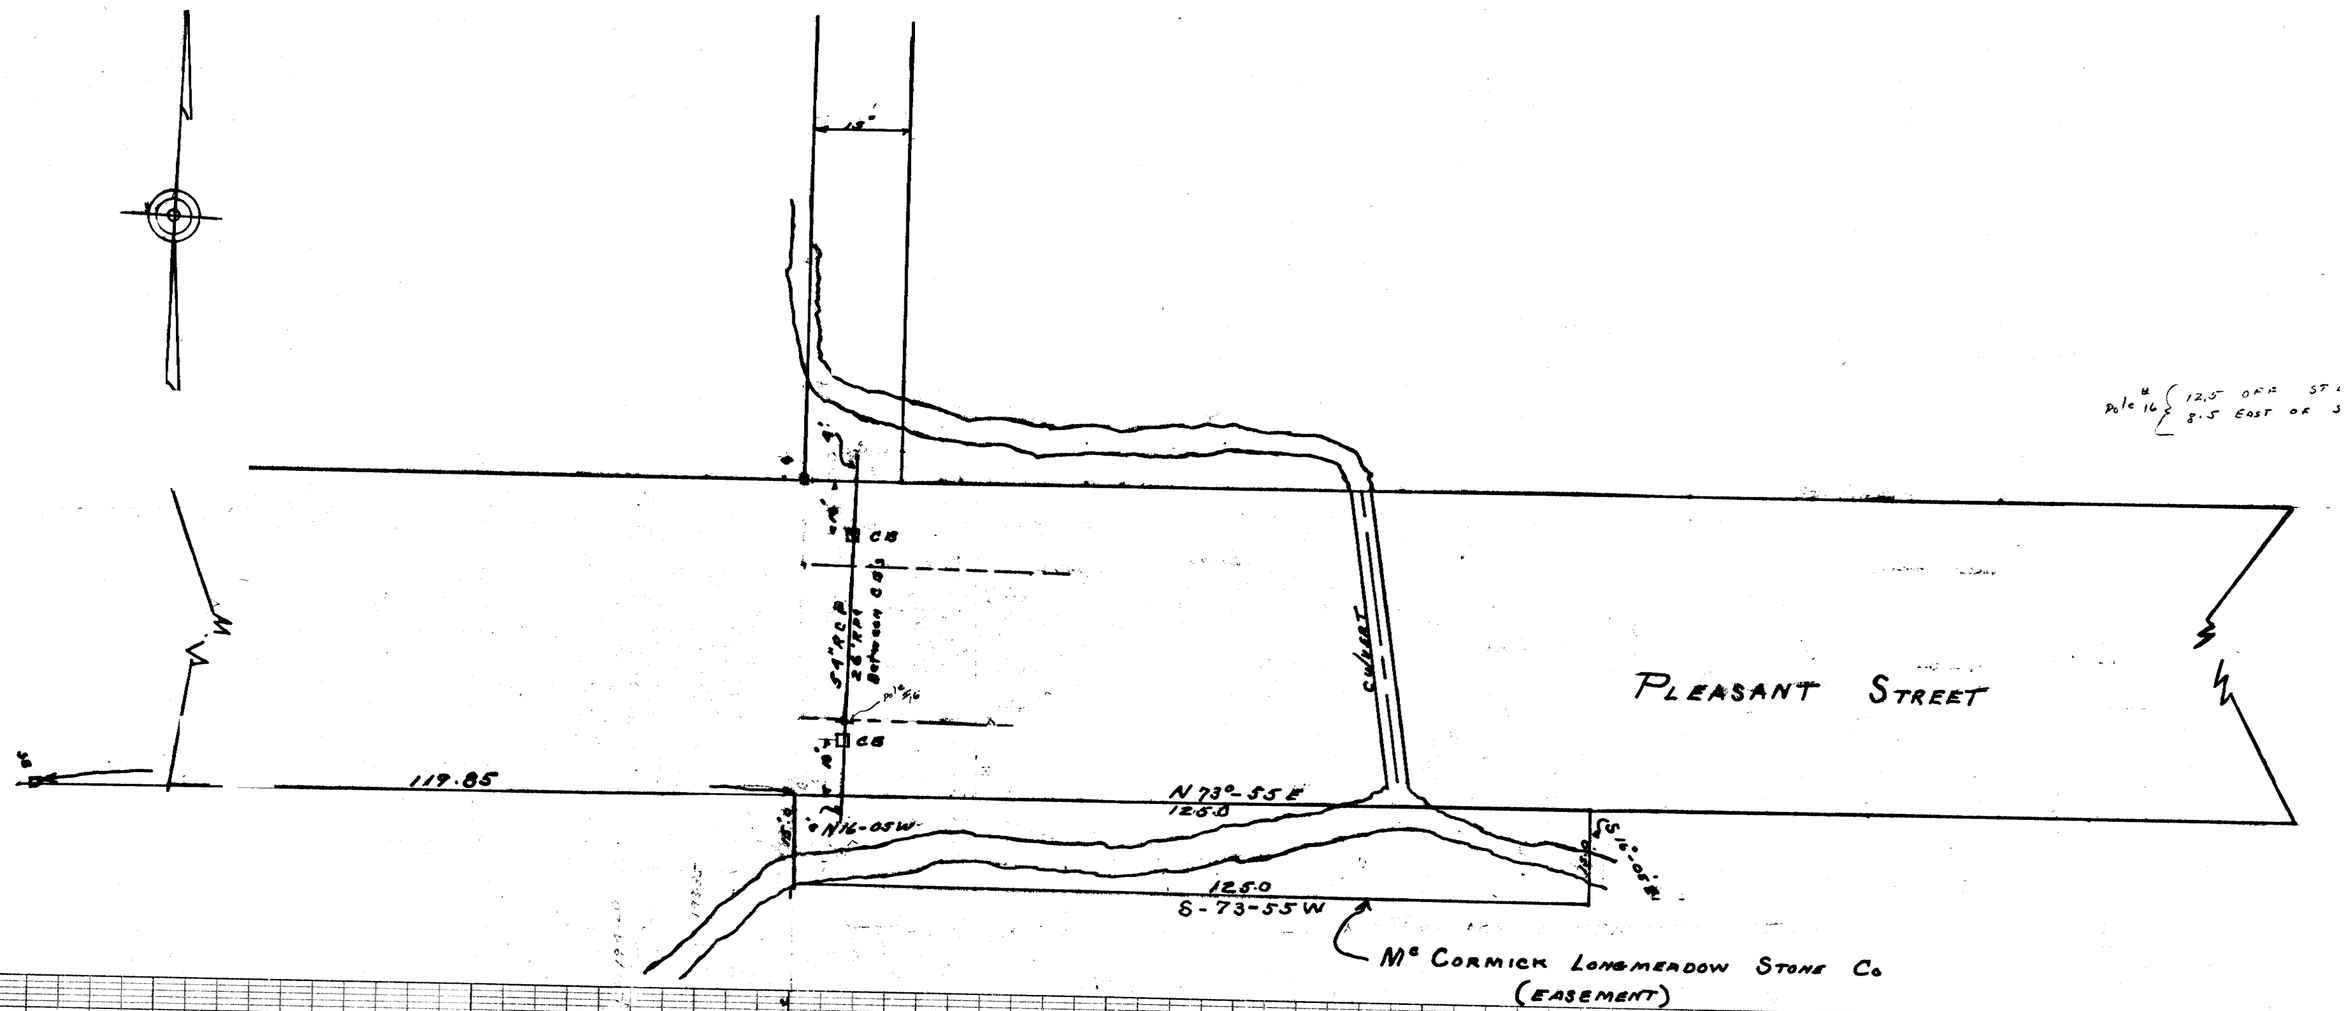

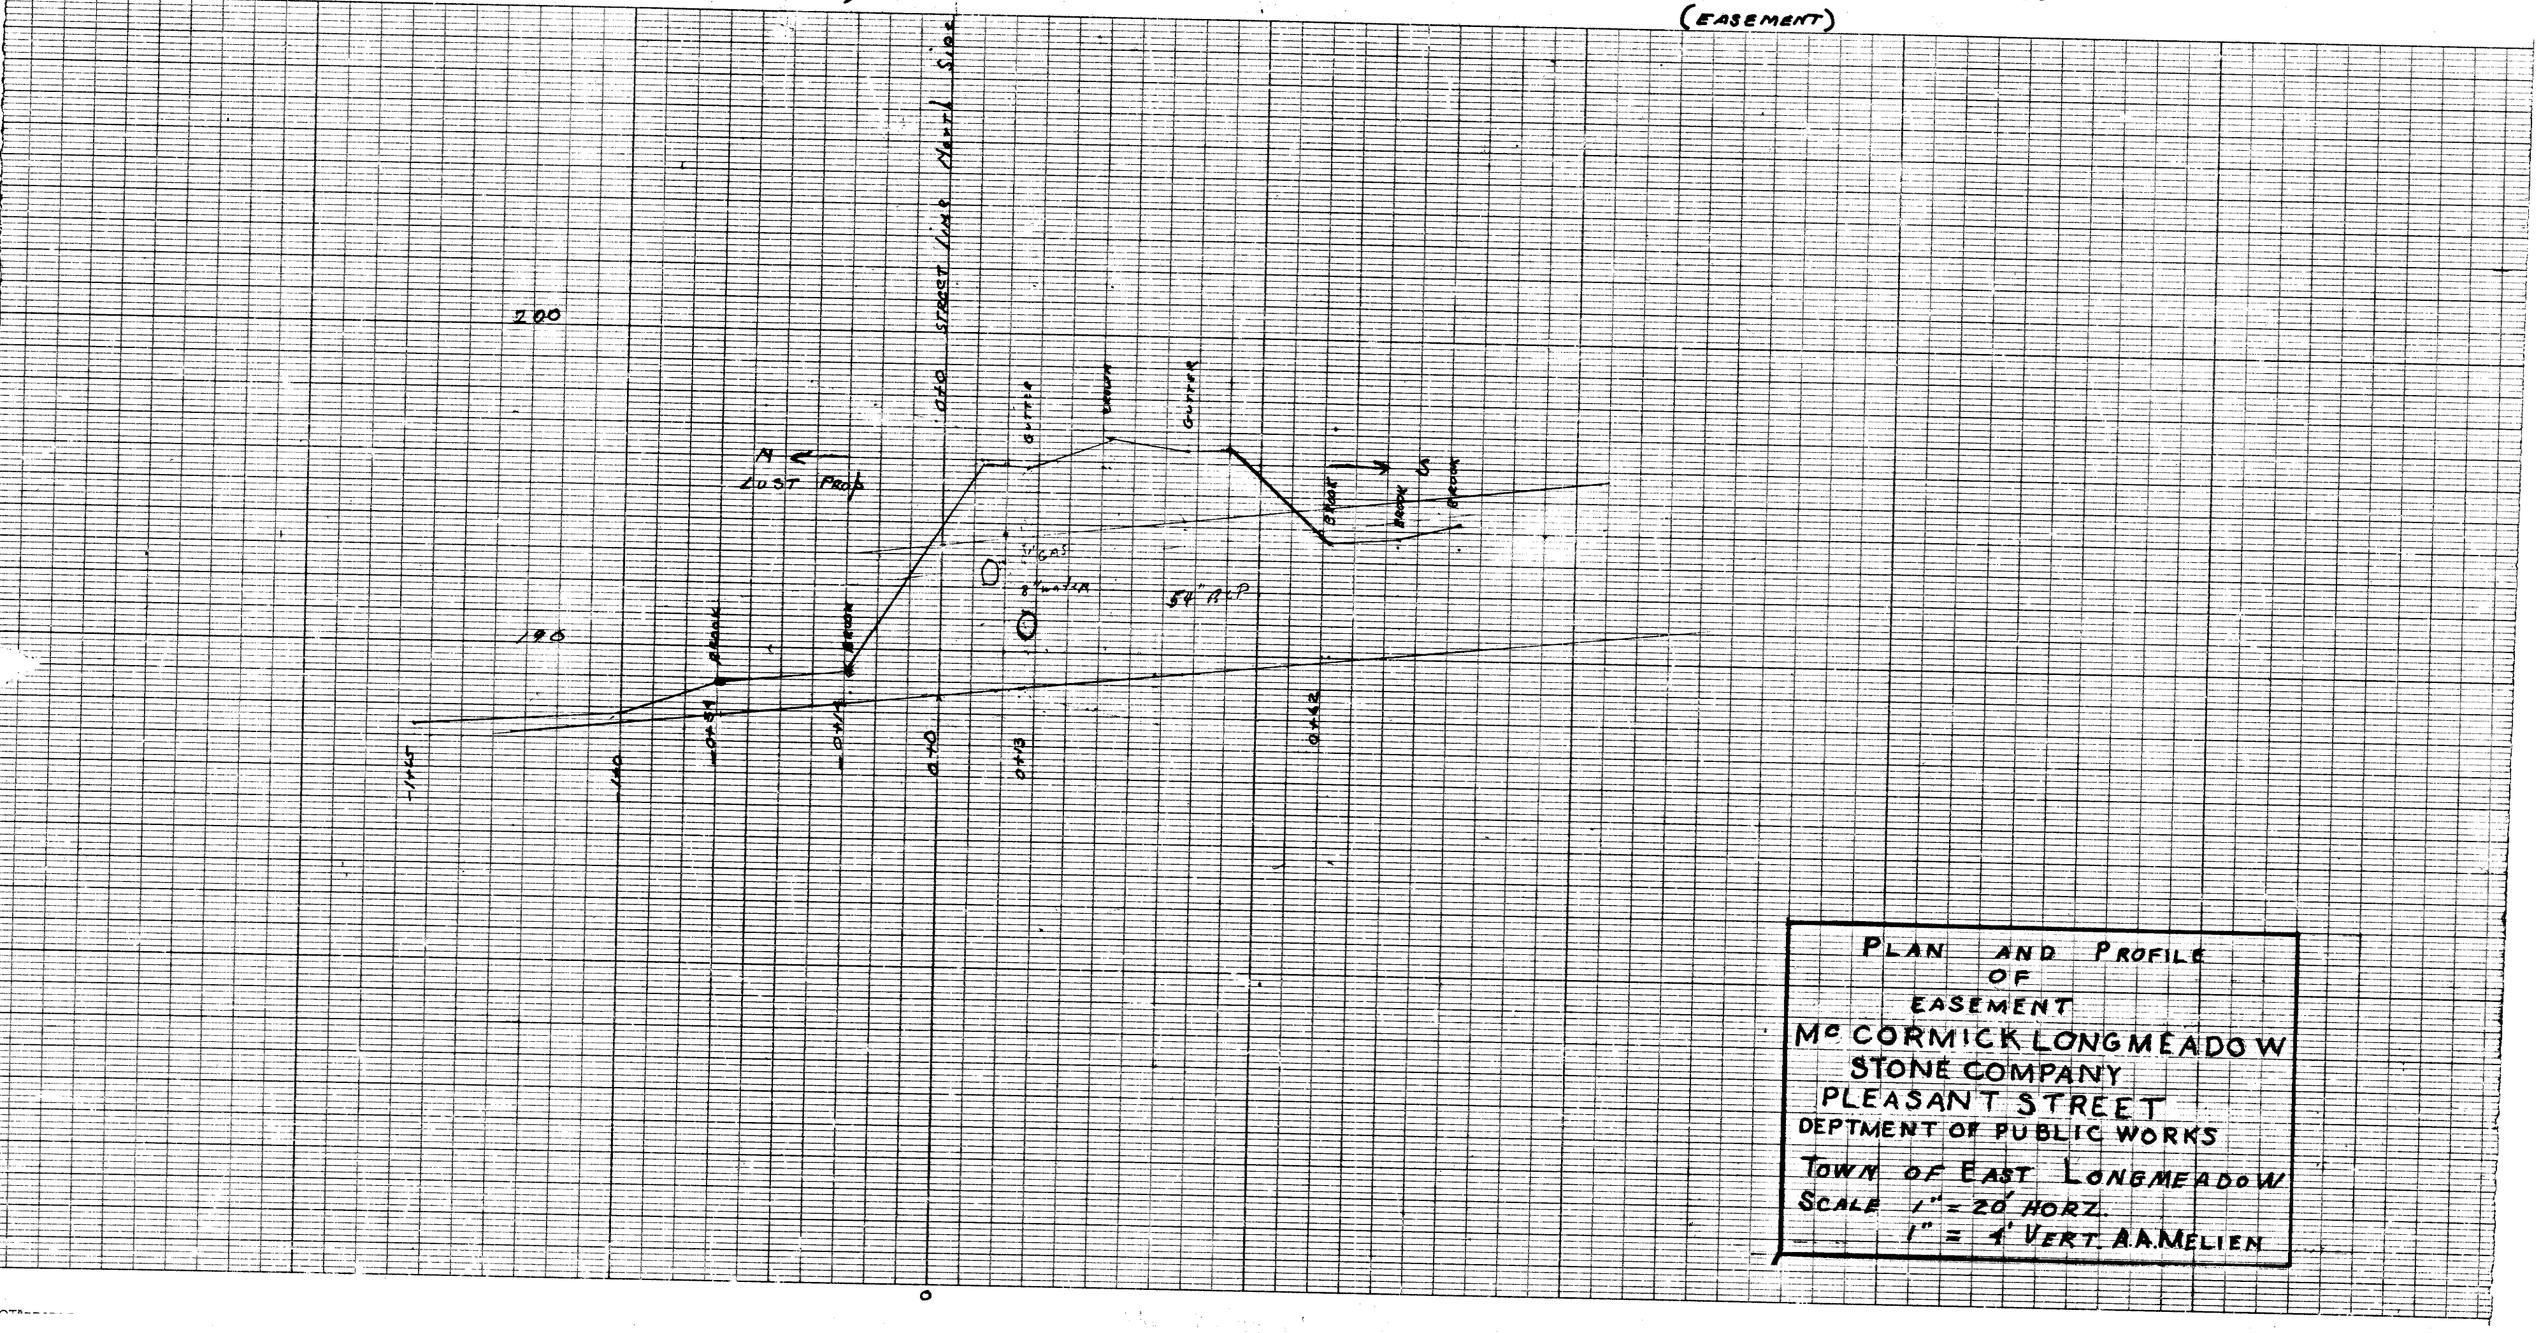

PLAN AND PROFILE
OF
EASEMENT
McCORMICK LONGMEADOW
STONE COMPANY
PLEASANT STREET
DEPTMENT OF PUBLIC WORKS
TOWN OF EAST LONGMEADOW
SCALE 1" = 20' HORZ.
1" = 4' VERT. A.A.MELIEN

PRINTED IN U.S.A.
ON 100% RAG PAPER MADE IN U.S.A.

8D-58