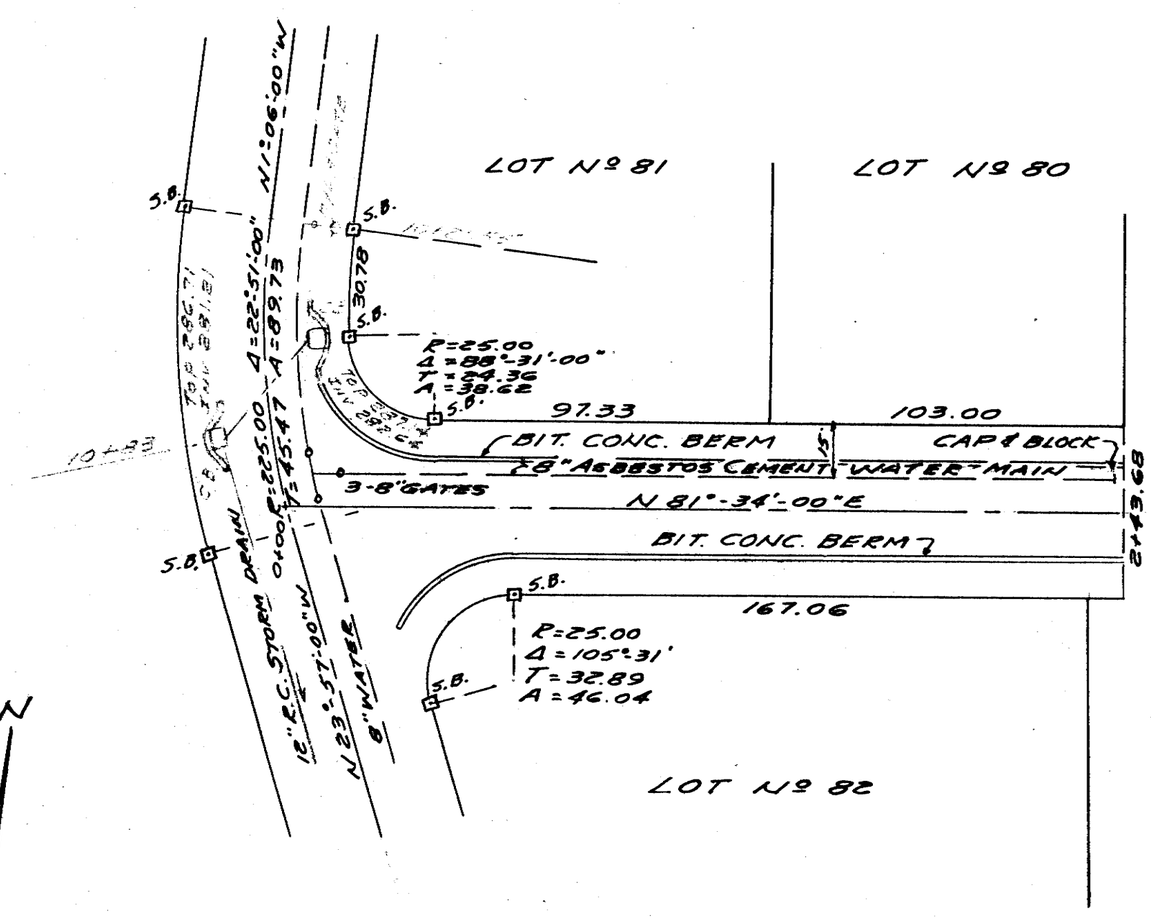

N

GLENWOOD HOMES INC.

PLAN & PROFILE OF OVERBROOK ROAD

EAST VILLAGE - SECTION A

EAST LONGMEADOW, MASS.

FEBRUARY 16, 1960

SCALES: 1"=40' HOR.
1"=4' VERT.

RICHARD H. STOWE, REG. L.S.
LUDLOW, MASS.

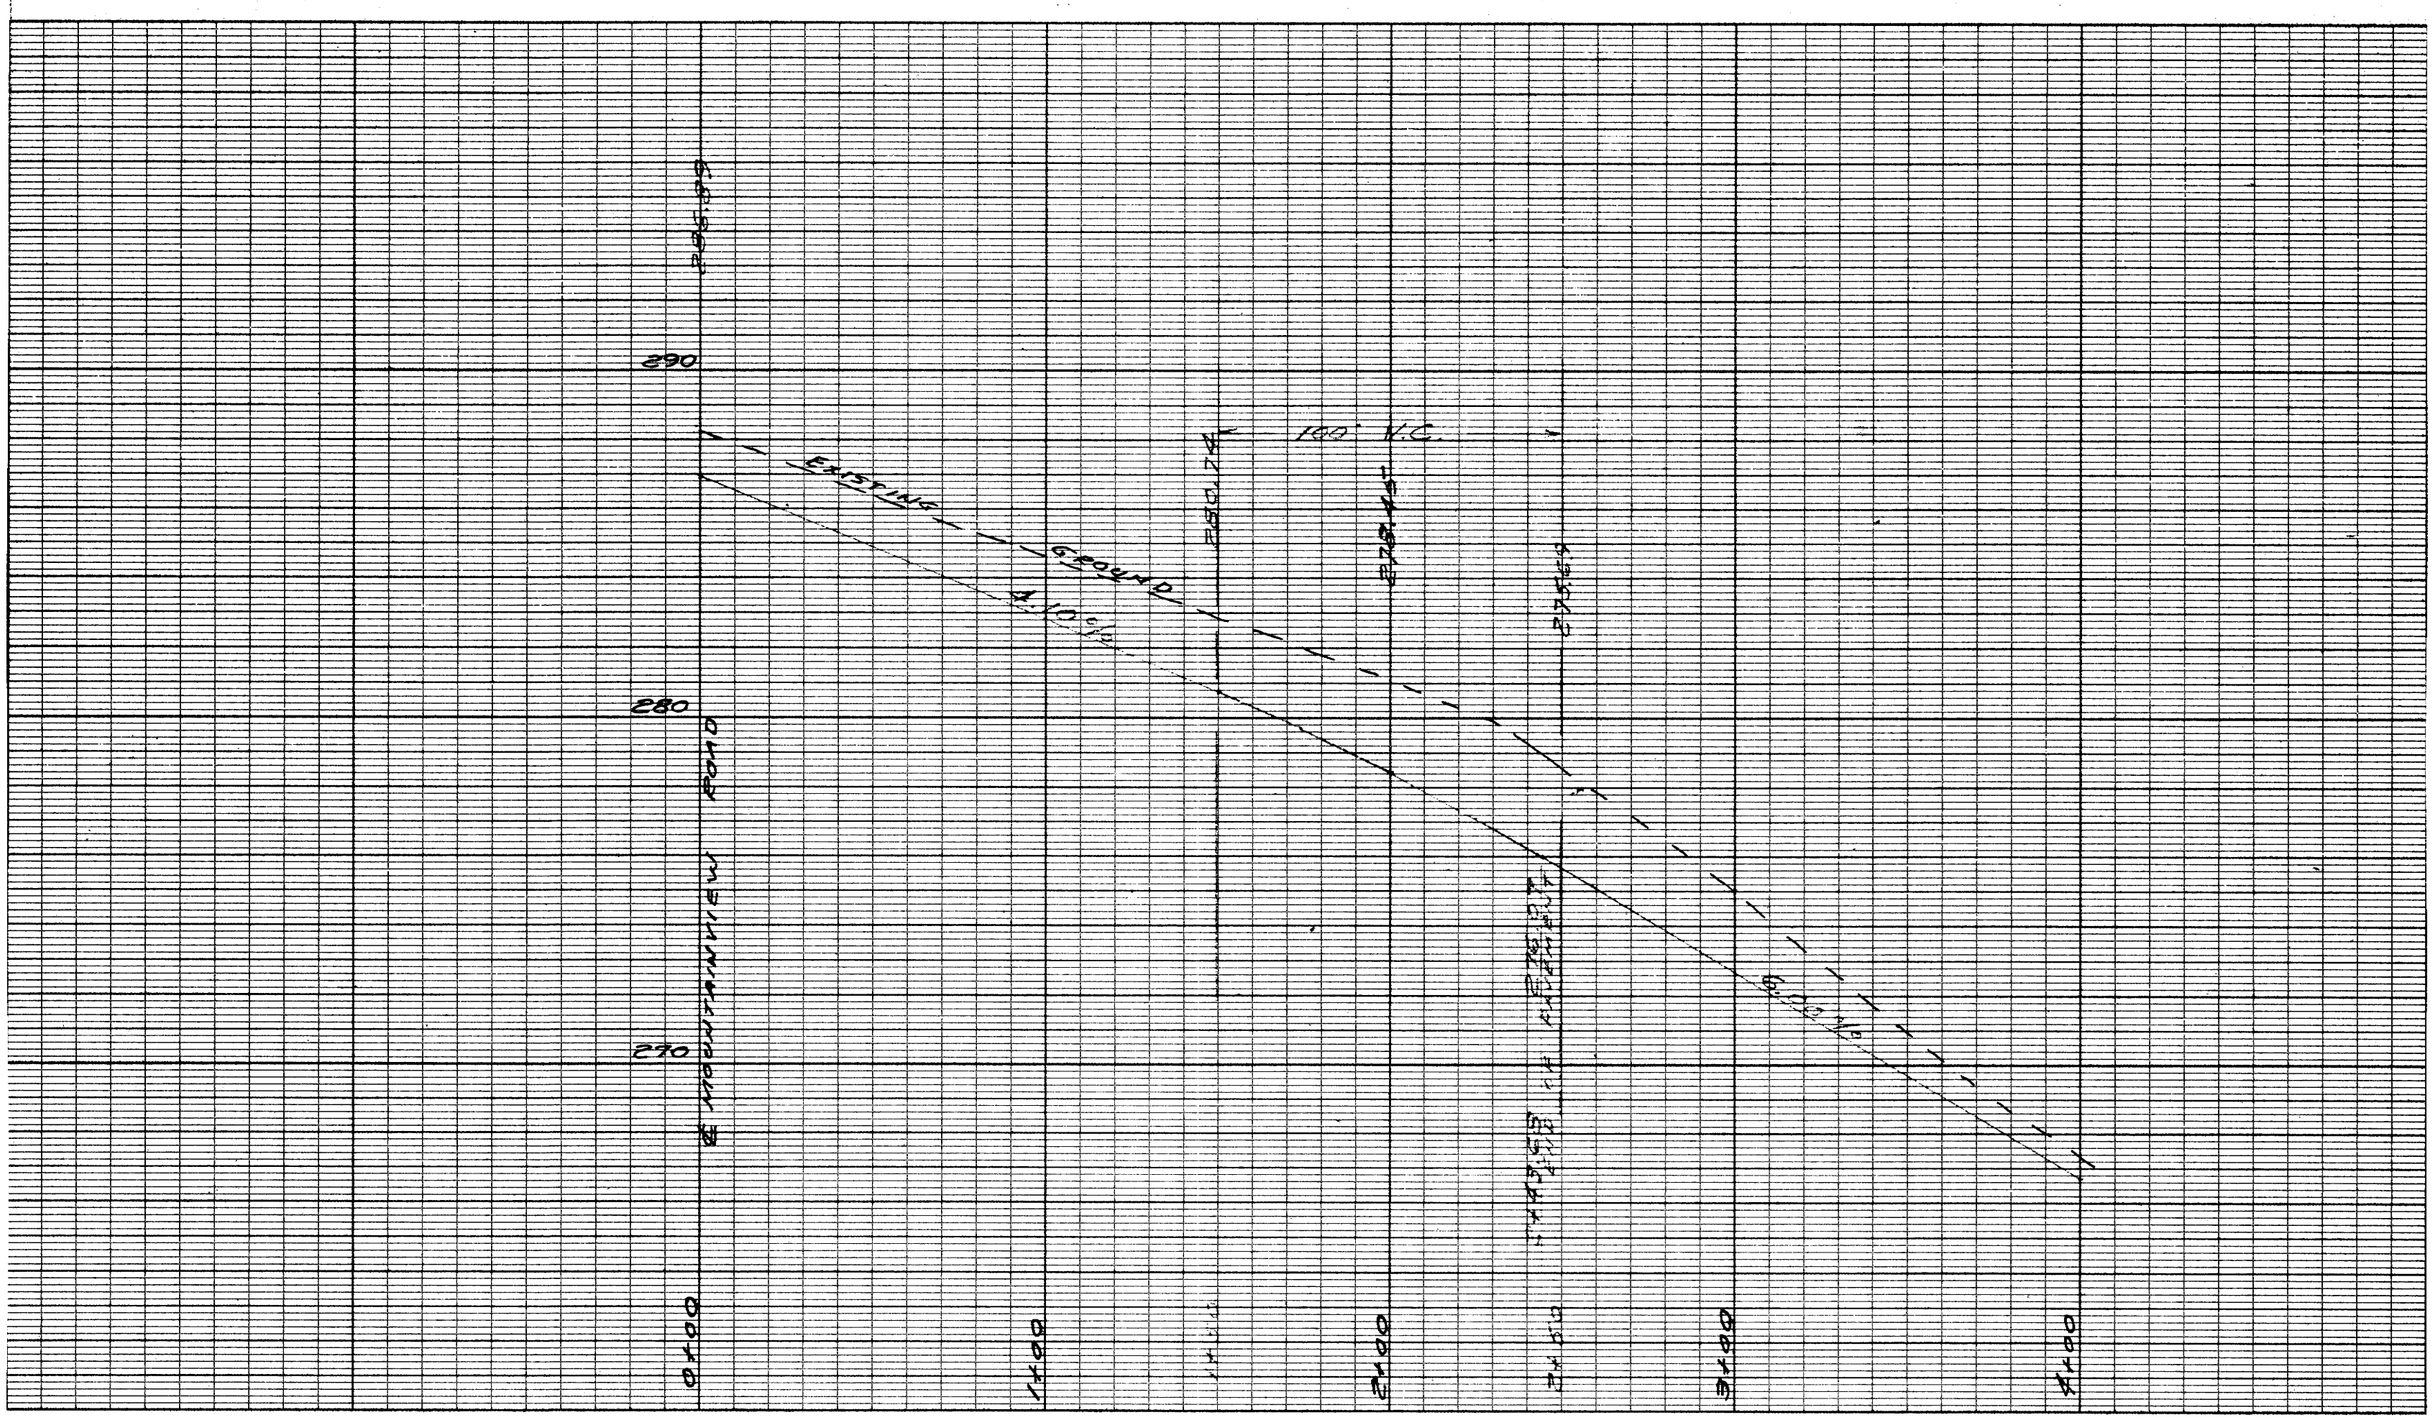

"PERFECT" PROFILE
PLATE A
EUGENE DIETZGEN CO.

PRINTED IN U.S.A.
ON CLOTH MADE IN U. S. A.

SD-91