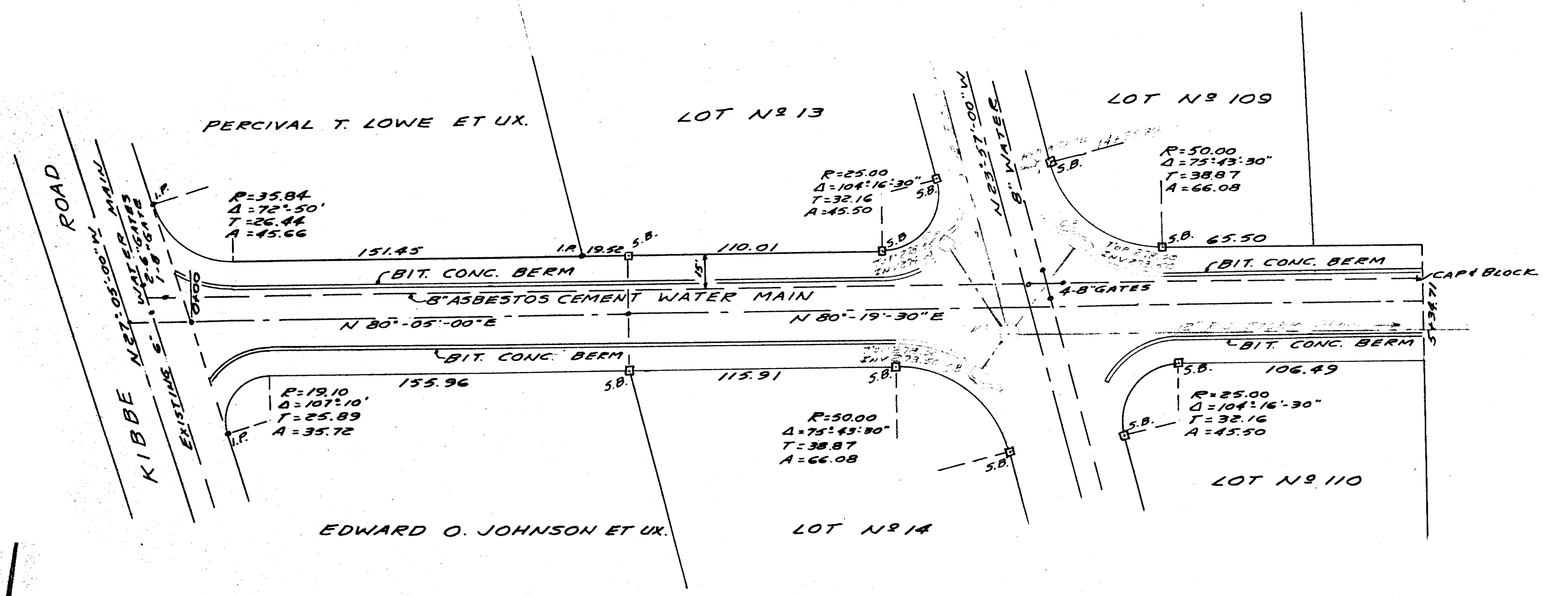

GLENWOOD HOMES INC.

PLAN & PROFILE OF
GLENWOOD ROAD
EAST VILLAGE - SECTION A
EAST LONGMEADOW, MASS.

FEBRUARY 16, 1960

SCALES: 1"=40' HOR.
1"=4' VERT.

RICHARD H. STOWE, REG. L.S.
LUDLOW, MASS.

SD-92