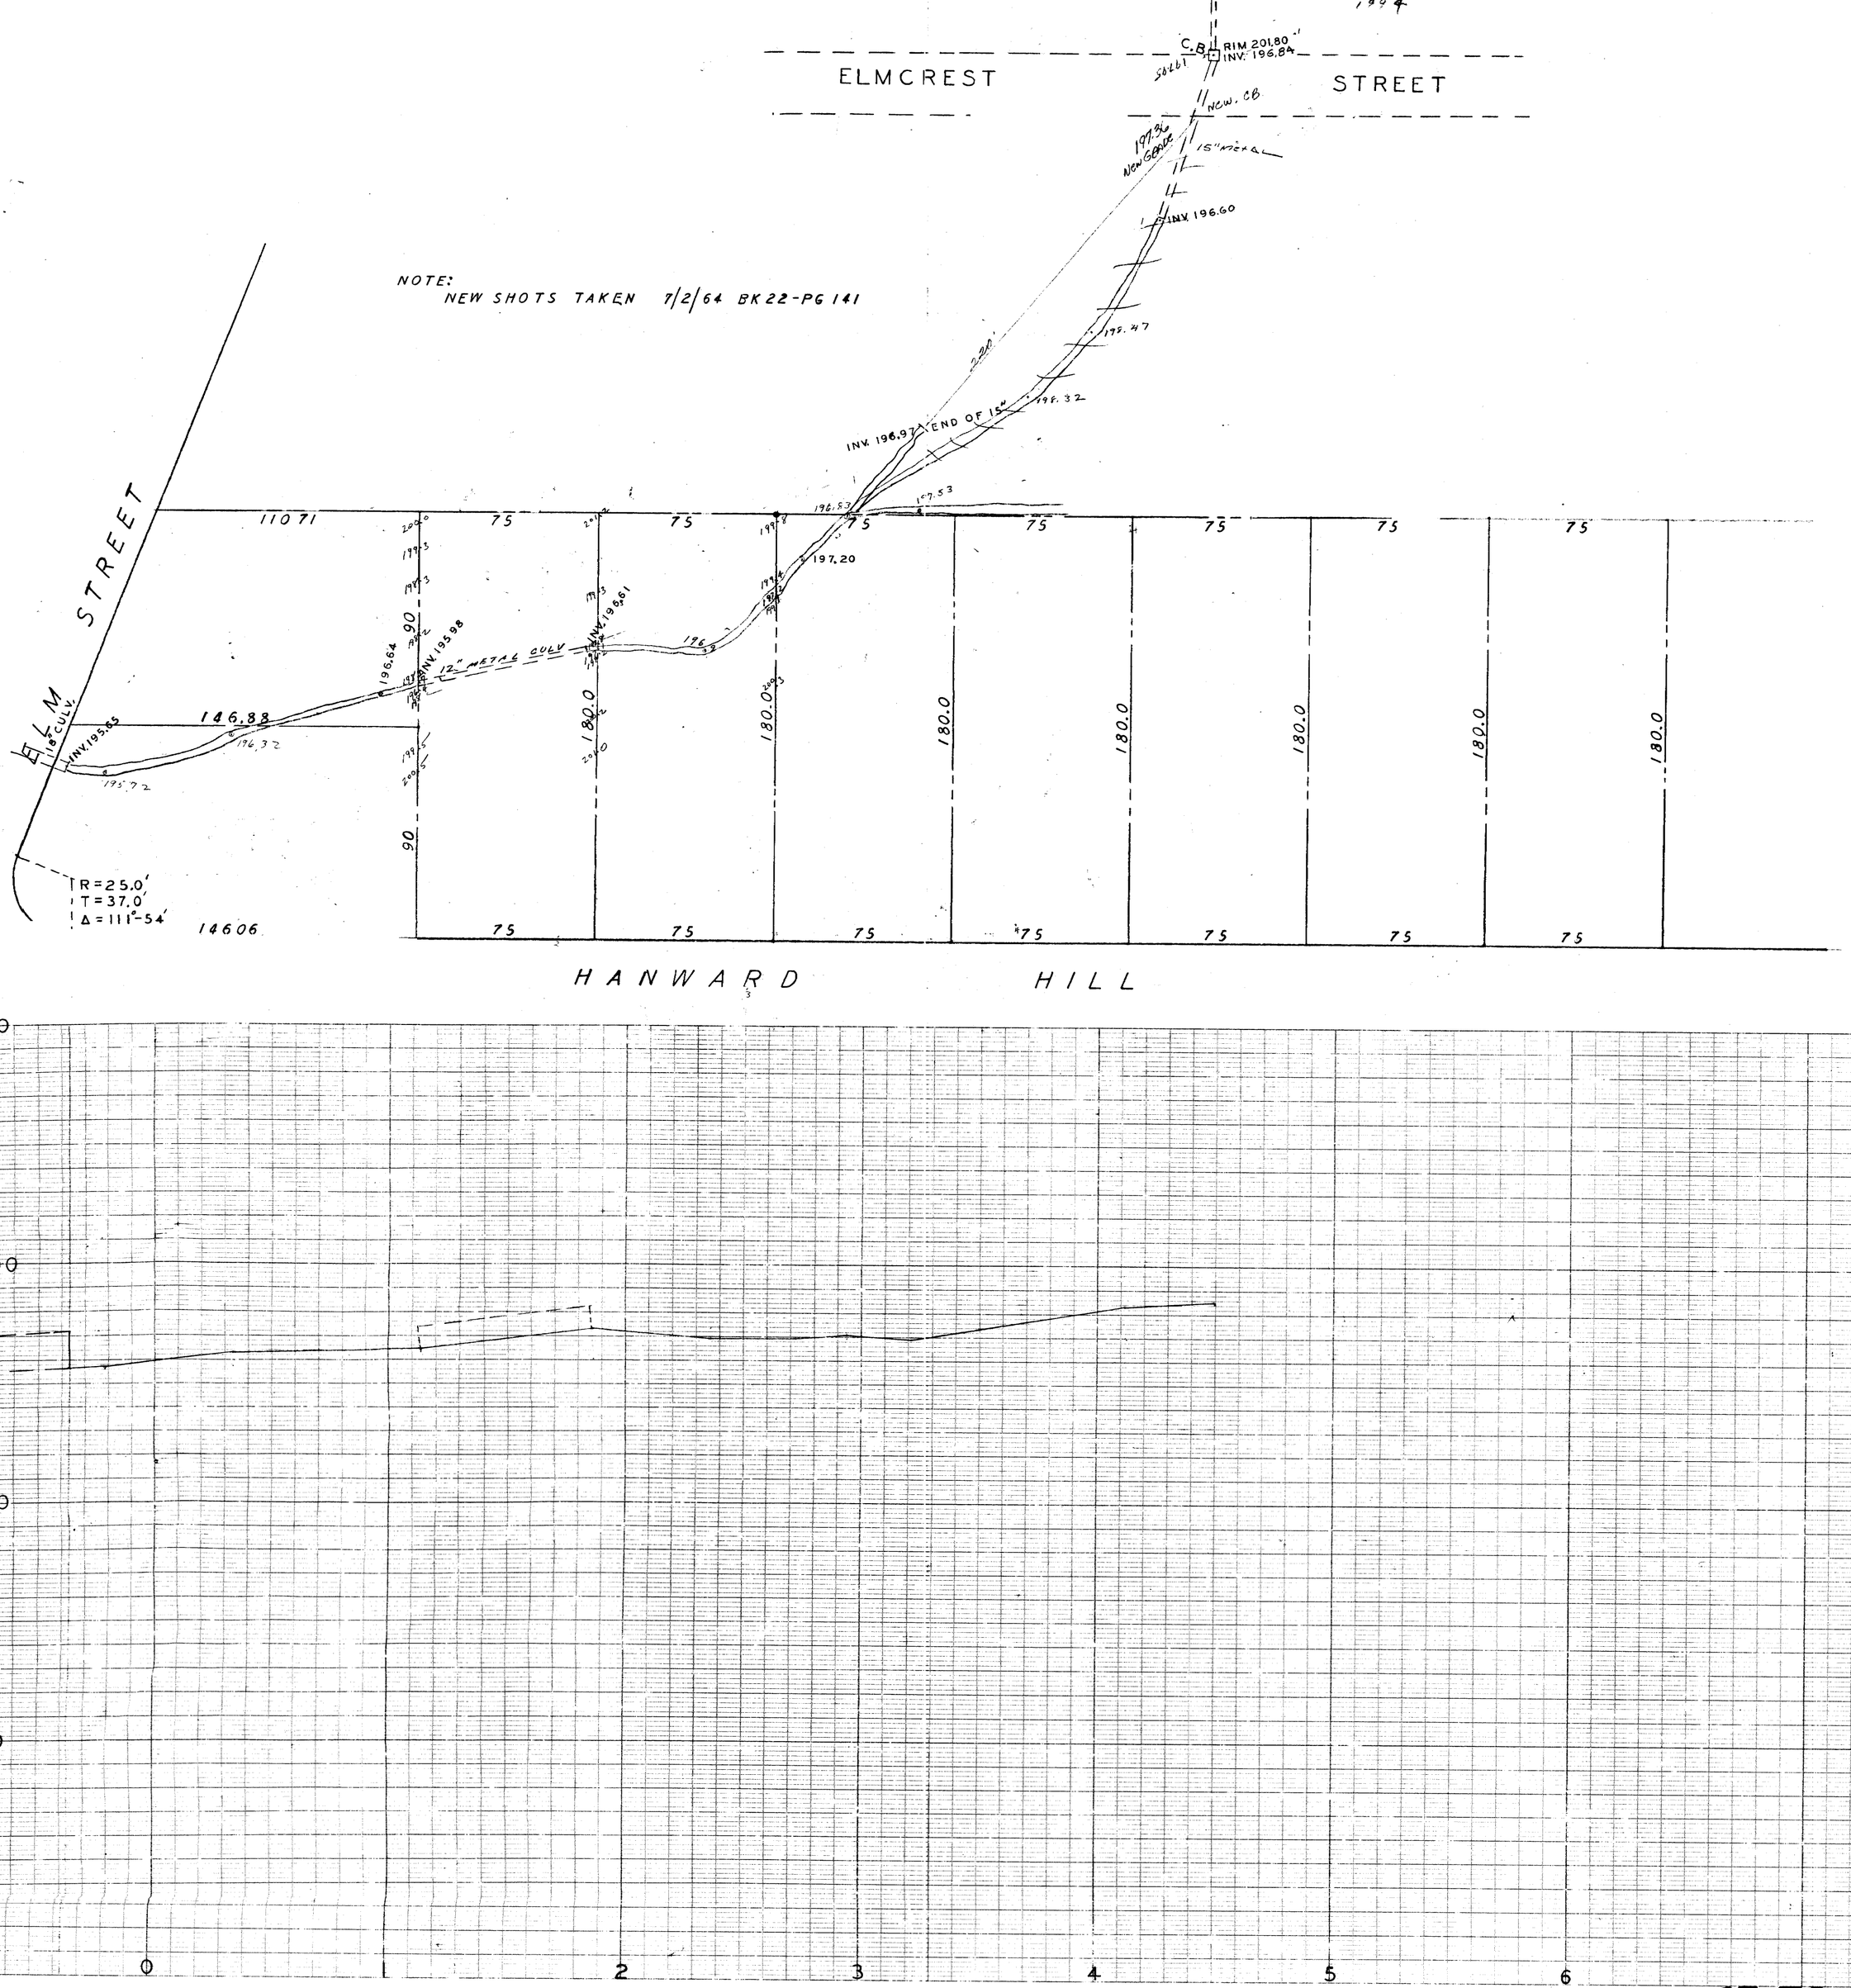
ELMCREST STREET
C.B. RIM 201.80
INV. 196.84
NEW. CB
15" metal
INV. 196.60
NOTE:
NEW SHOTS TAKEN 7/2/64 BK 22-PG 141
END OF 15"
INV. 196.97
12" METAL CULV
INV. 195.98
INV. 196.61
18" CULV.
INV. 195.65
ELM STREET
R = 25.0'
T = 37.0'
Δ = 111°-54'
14606
HANWARD HILL

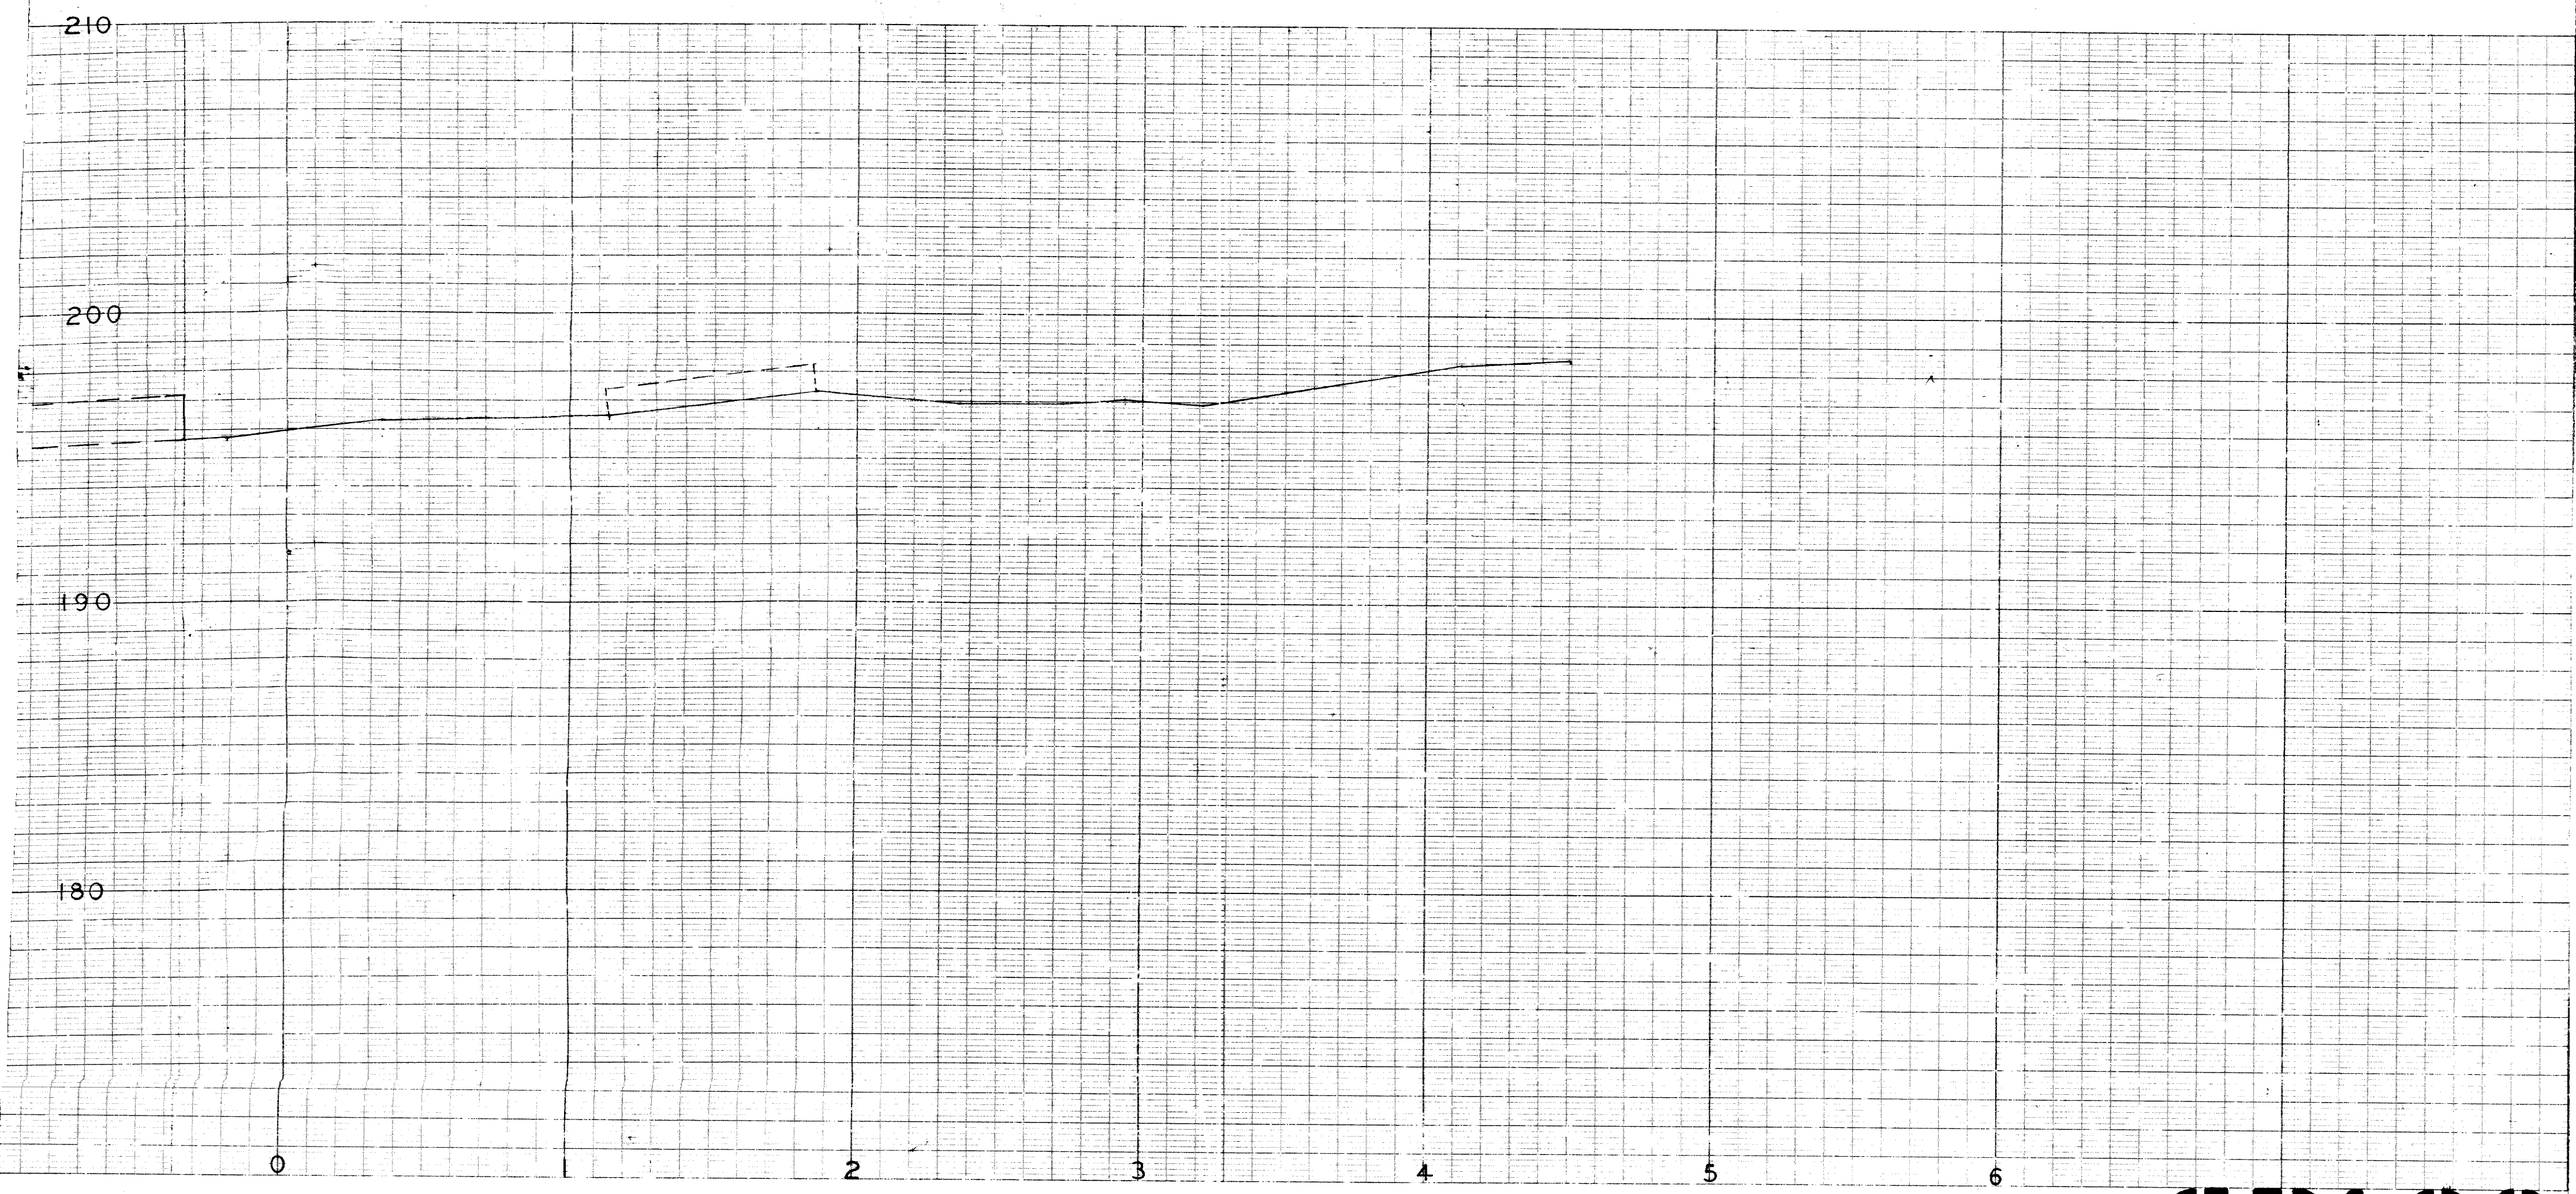
210
200
190
180
0
1
2
3
4
5
6

SD103