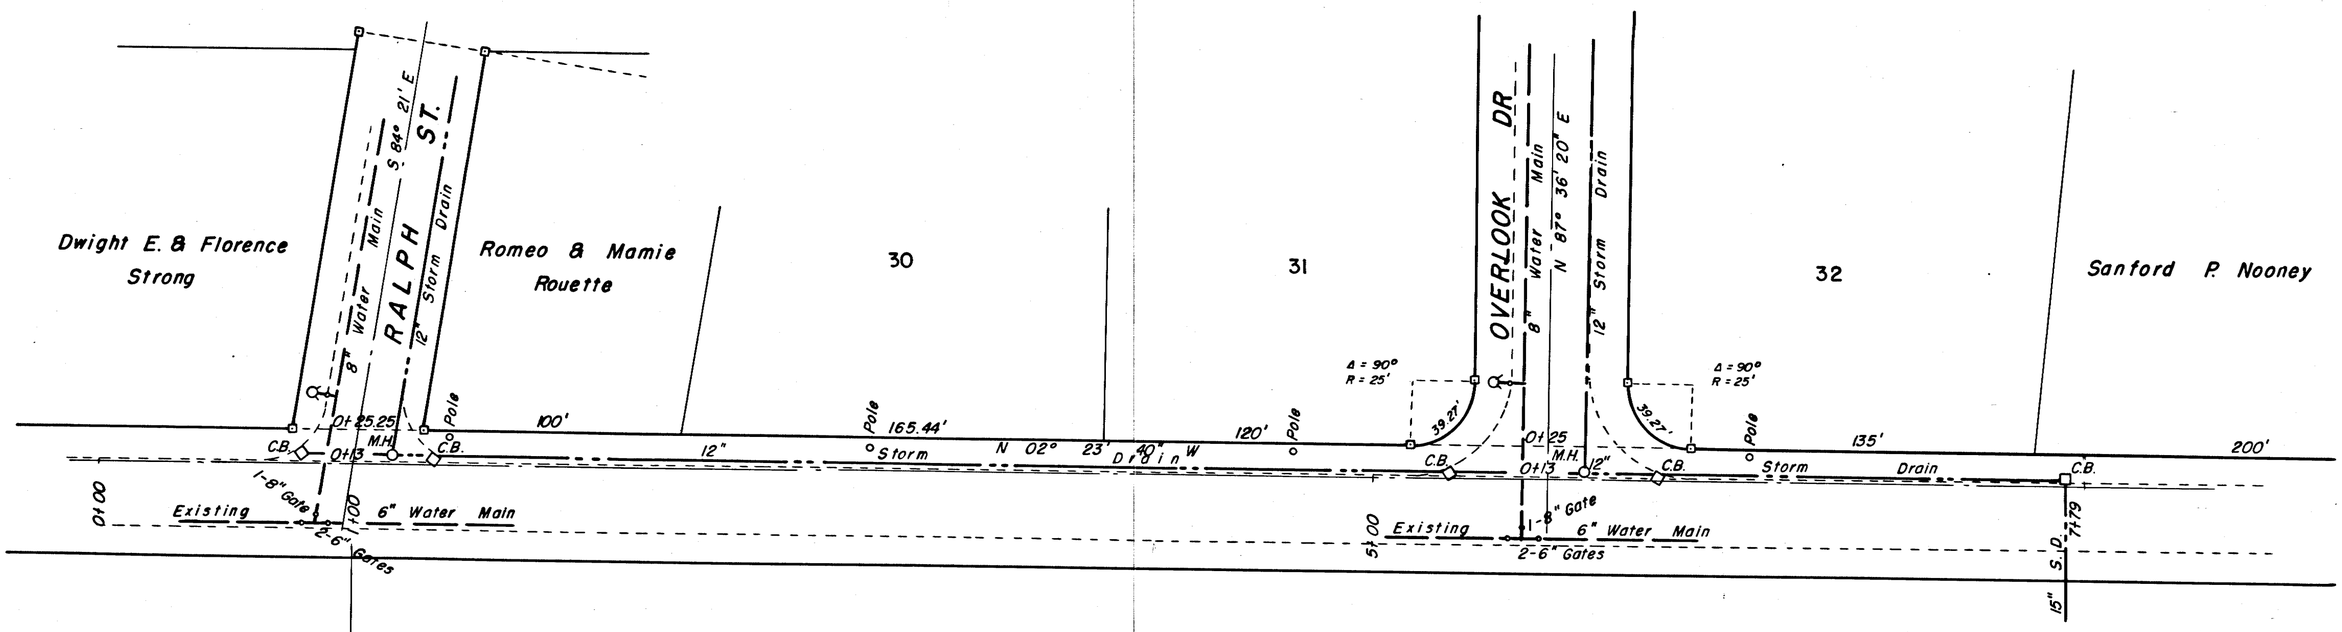

STORM DRAIN PLAN & PROFILE FOR

PARKER STREET

INSTALLED BY

JOSEPH CHAPDELAINE & SONS

EAST LONGMEADOW - MASSACHUSETTS

SCALES: Hor. 1 IN. = 40 FT. MAY, 1962

Vert: 1 IN. = 4 FT.

APPROVED BY EAST LONGMEADOW PLANNING BOARD

DATE: June 8, 1960

Chairman

Note: Construction methods and standards to conform to East Longmeadow Board of Public Works requirements.

C.E. ANDERSON ASSOCIATES

Civil Engineers Land Surveyors

Land Planning Consultants

Springfield - Massachusetts

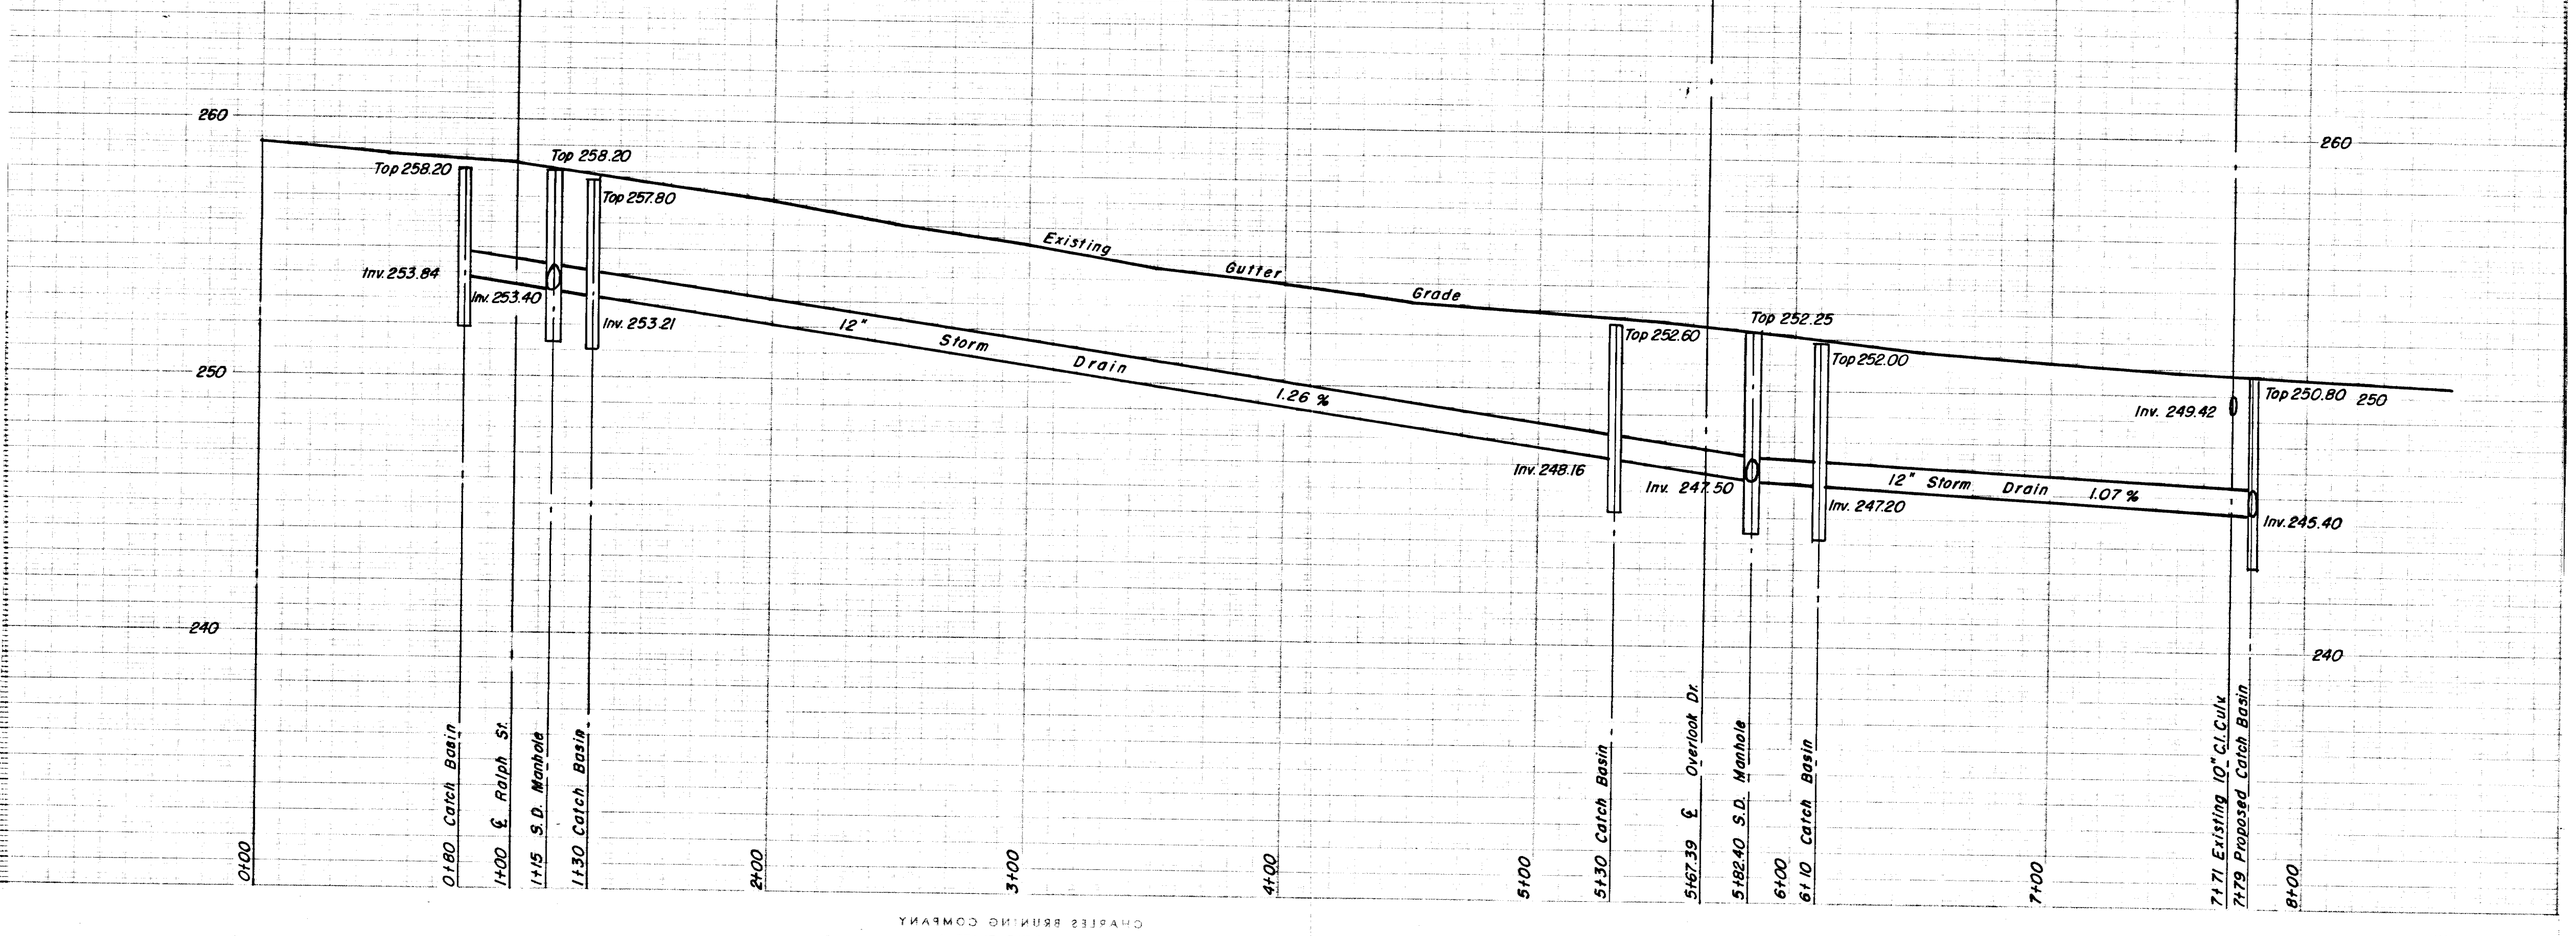

PLAN No. 1401-06

S D.124