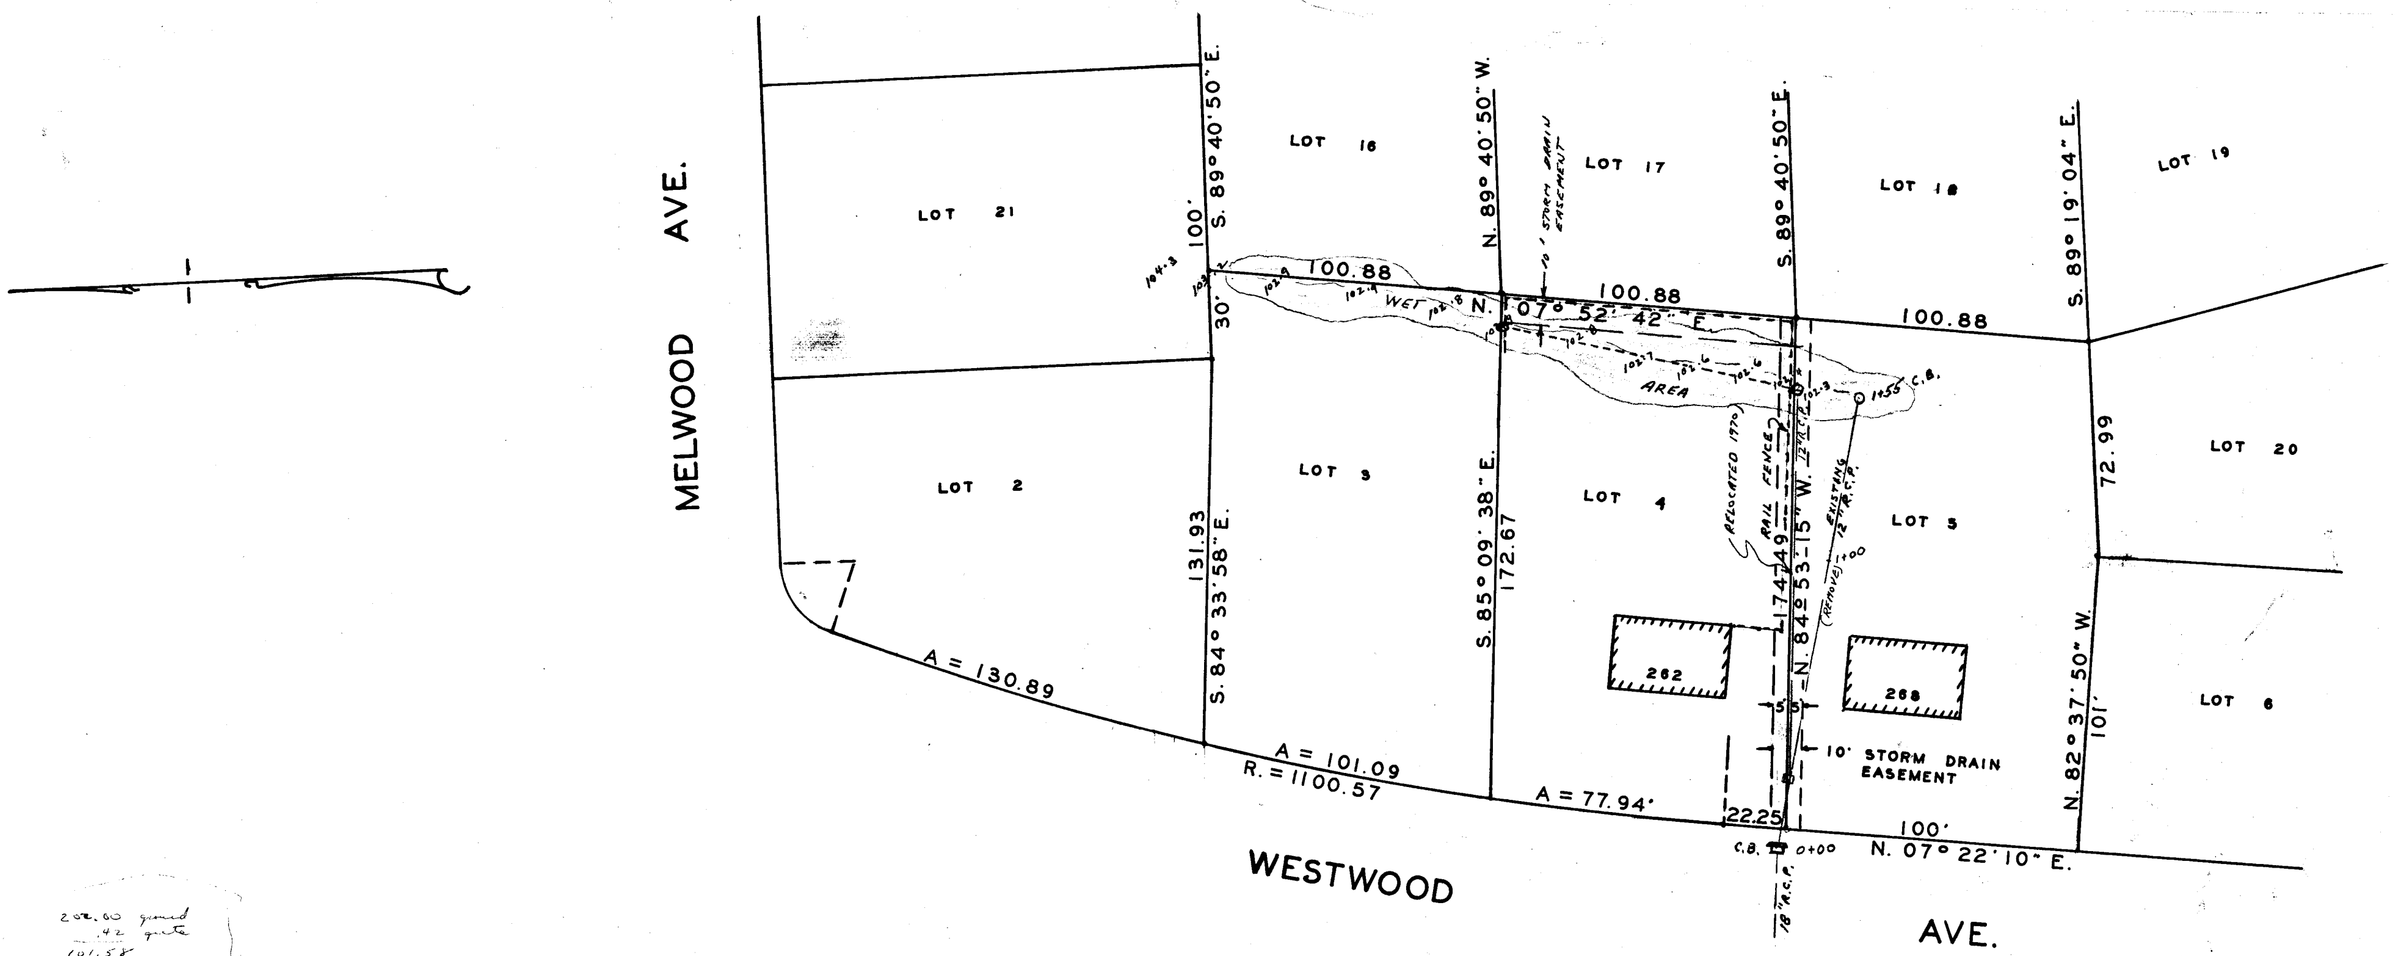


202.00 ground
.42 grate
101.58
1.25 pipe
100.33
.60 pitch
99.73
CATCH BASIN

PLAN & PROFILE OF
EXISTING STORM DRAIN
PROPERTY OF CABRINI & BRUNO
WESTWOOD AVE.
TOWN OF EAST LONGMEADOW
SCALE: 1" = 40' HOR.
1" = 4' VERT.
MAY 1970
A. A. MELIEN
ENG'R.

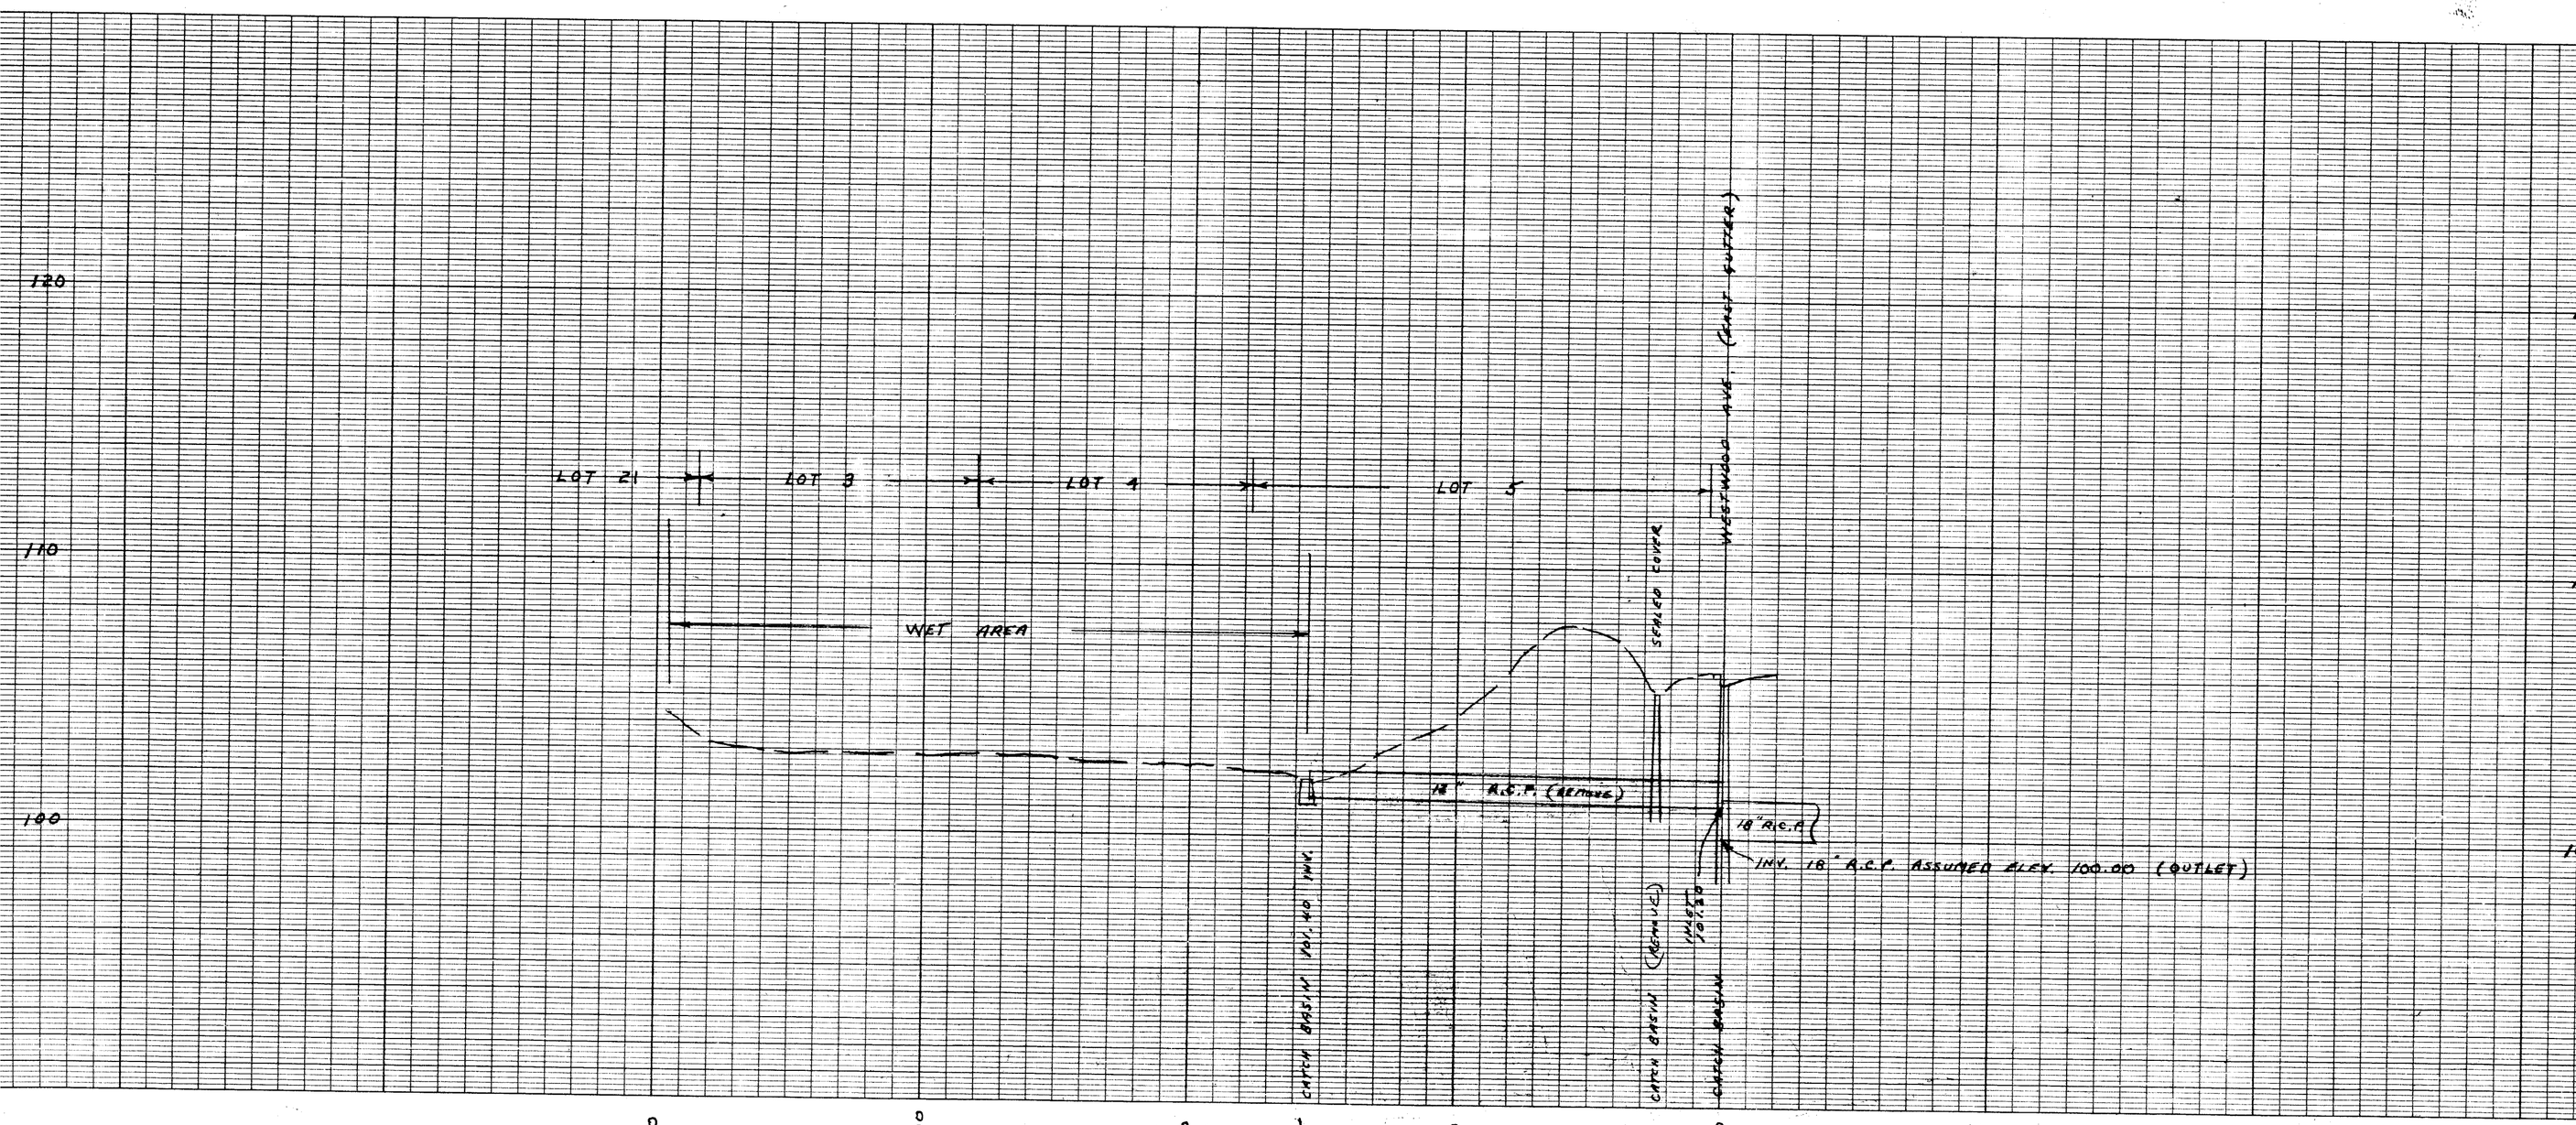


"PERFECT" PROFILE PLATE A EUGENE DIETZGEN CO.
PRINTED IN U.S.A. ON 100% RAG PAPER MADE IN U.S.A.

SID 150