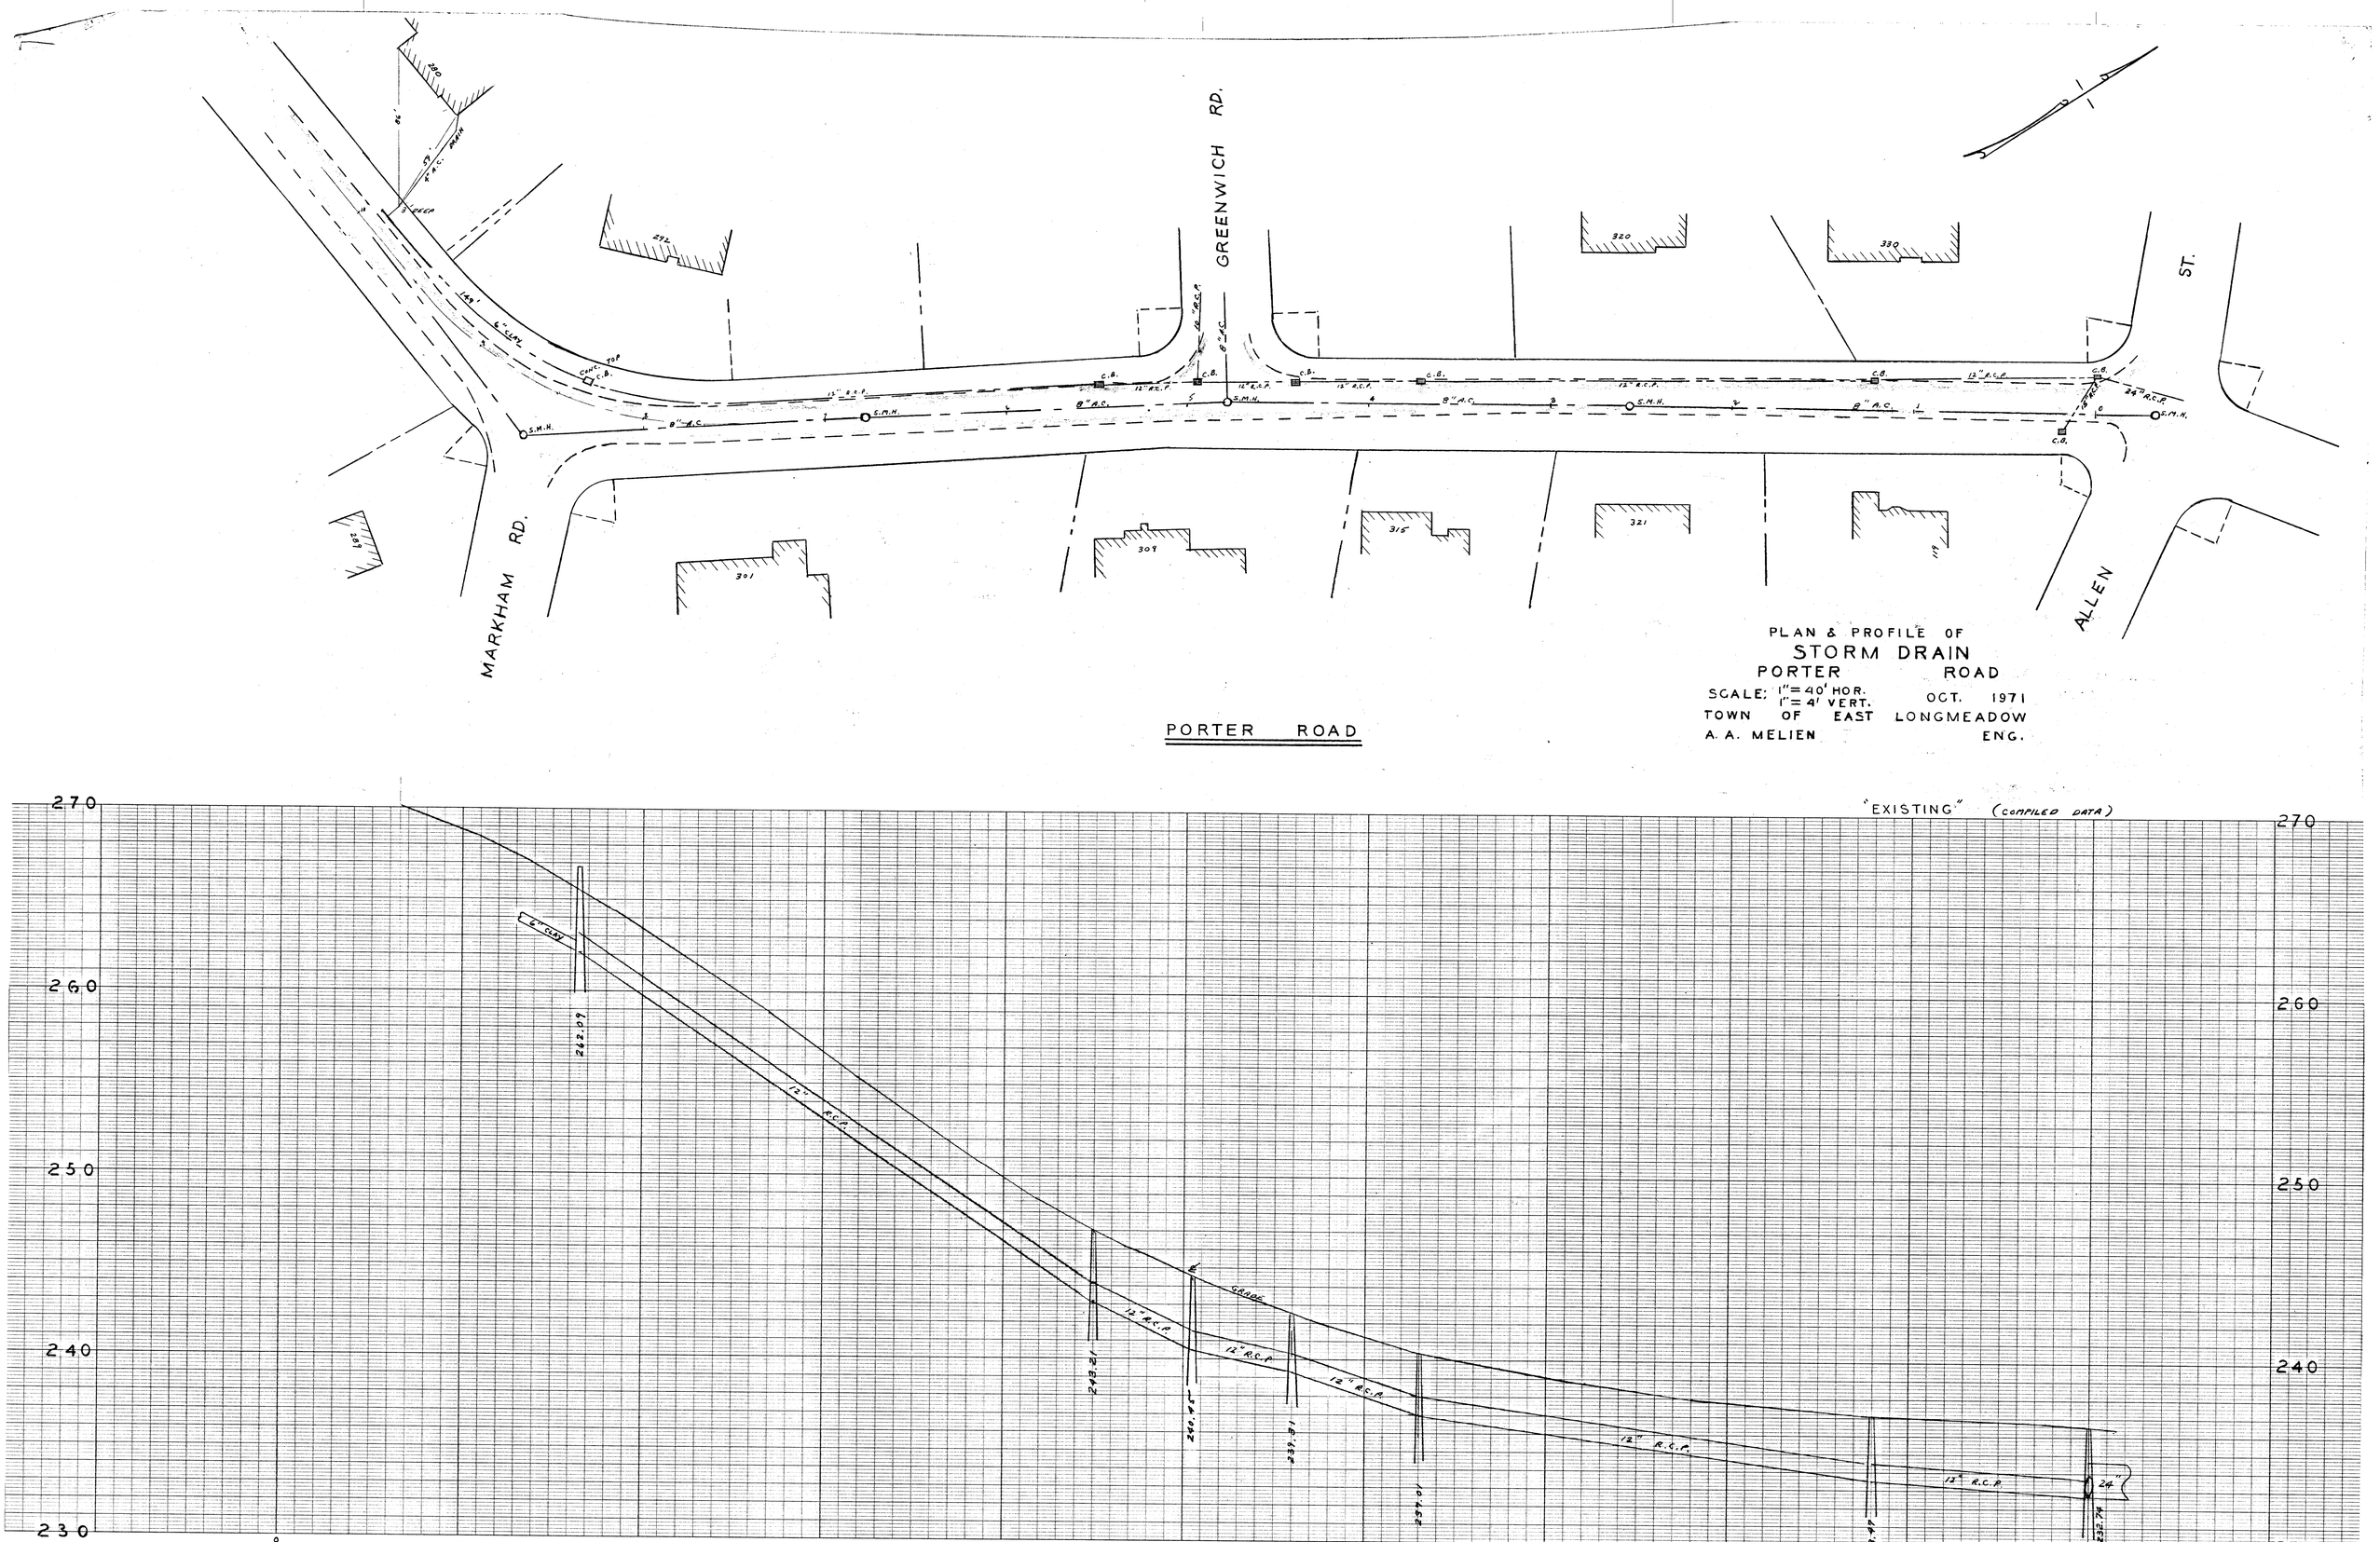
GREENWICH RD.
MARKHAM RD.
ALLEN ST.
PORTER ROAD
PLAN & PROFILE OF
STORM DRAIN
PORTER ROAD
SCALE: 1"=40' HOR.
1"=4' VERT.
OCT. 1971
TOWN OF EAST LONGMEADOW
A. A. MELIEN ENG.
"EXISTING" (COMPILED DATA)
GRADE
12" R.C.P.
24" R.C.P.
6" CLAY
C.B.
S.M.H.
8" A.C.
12" R.C.P.
243.21
240.42
239.81
237.01
238.47
232.74
270
260
250
240
230
10+00
9+00
8+00
7+00
6+00
5+00
4+00
3+00
2+00
1+00
0+00
"PERFECT" PROFILE
PLATE A
EUGENE DIETZGEN CO.
PRINTED IN U.S.A.
ON 100% RAG PAPER MADE IN U.S.A.
SD 156