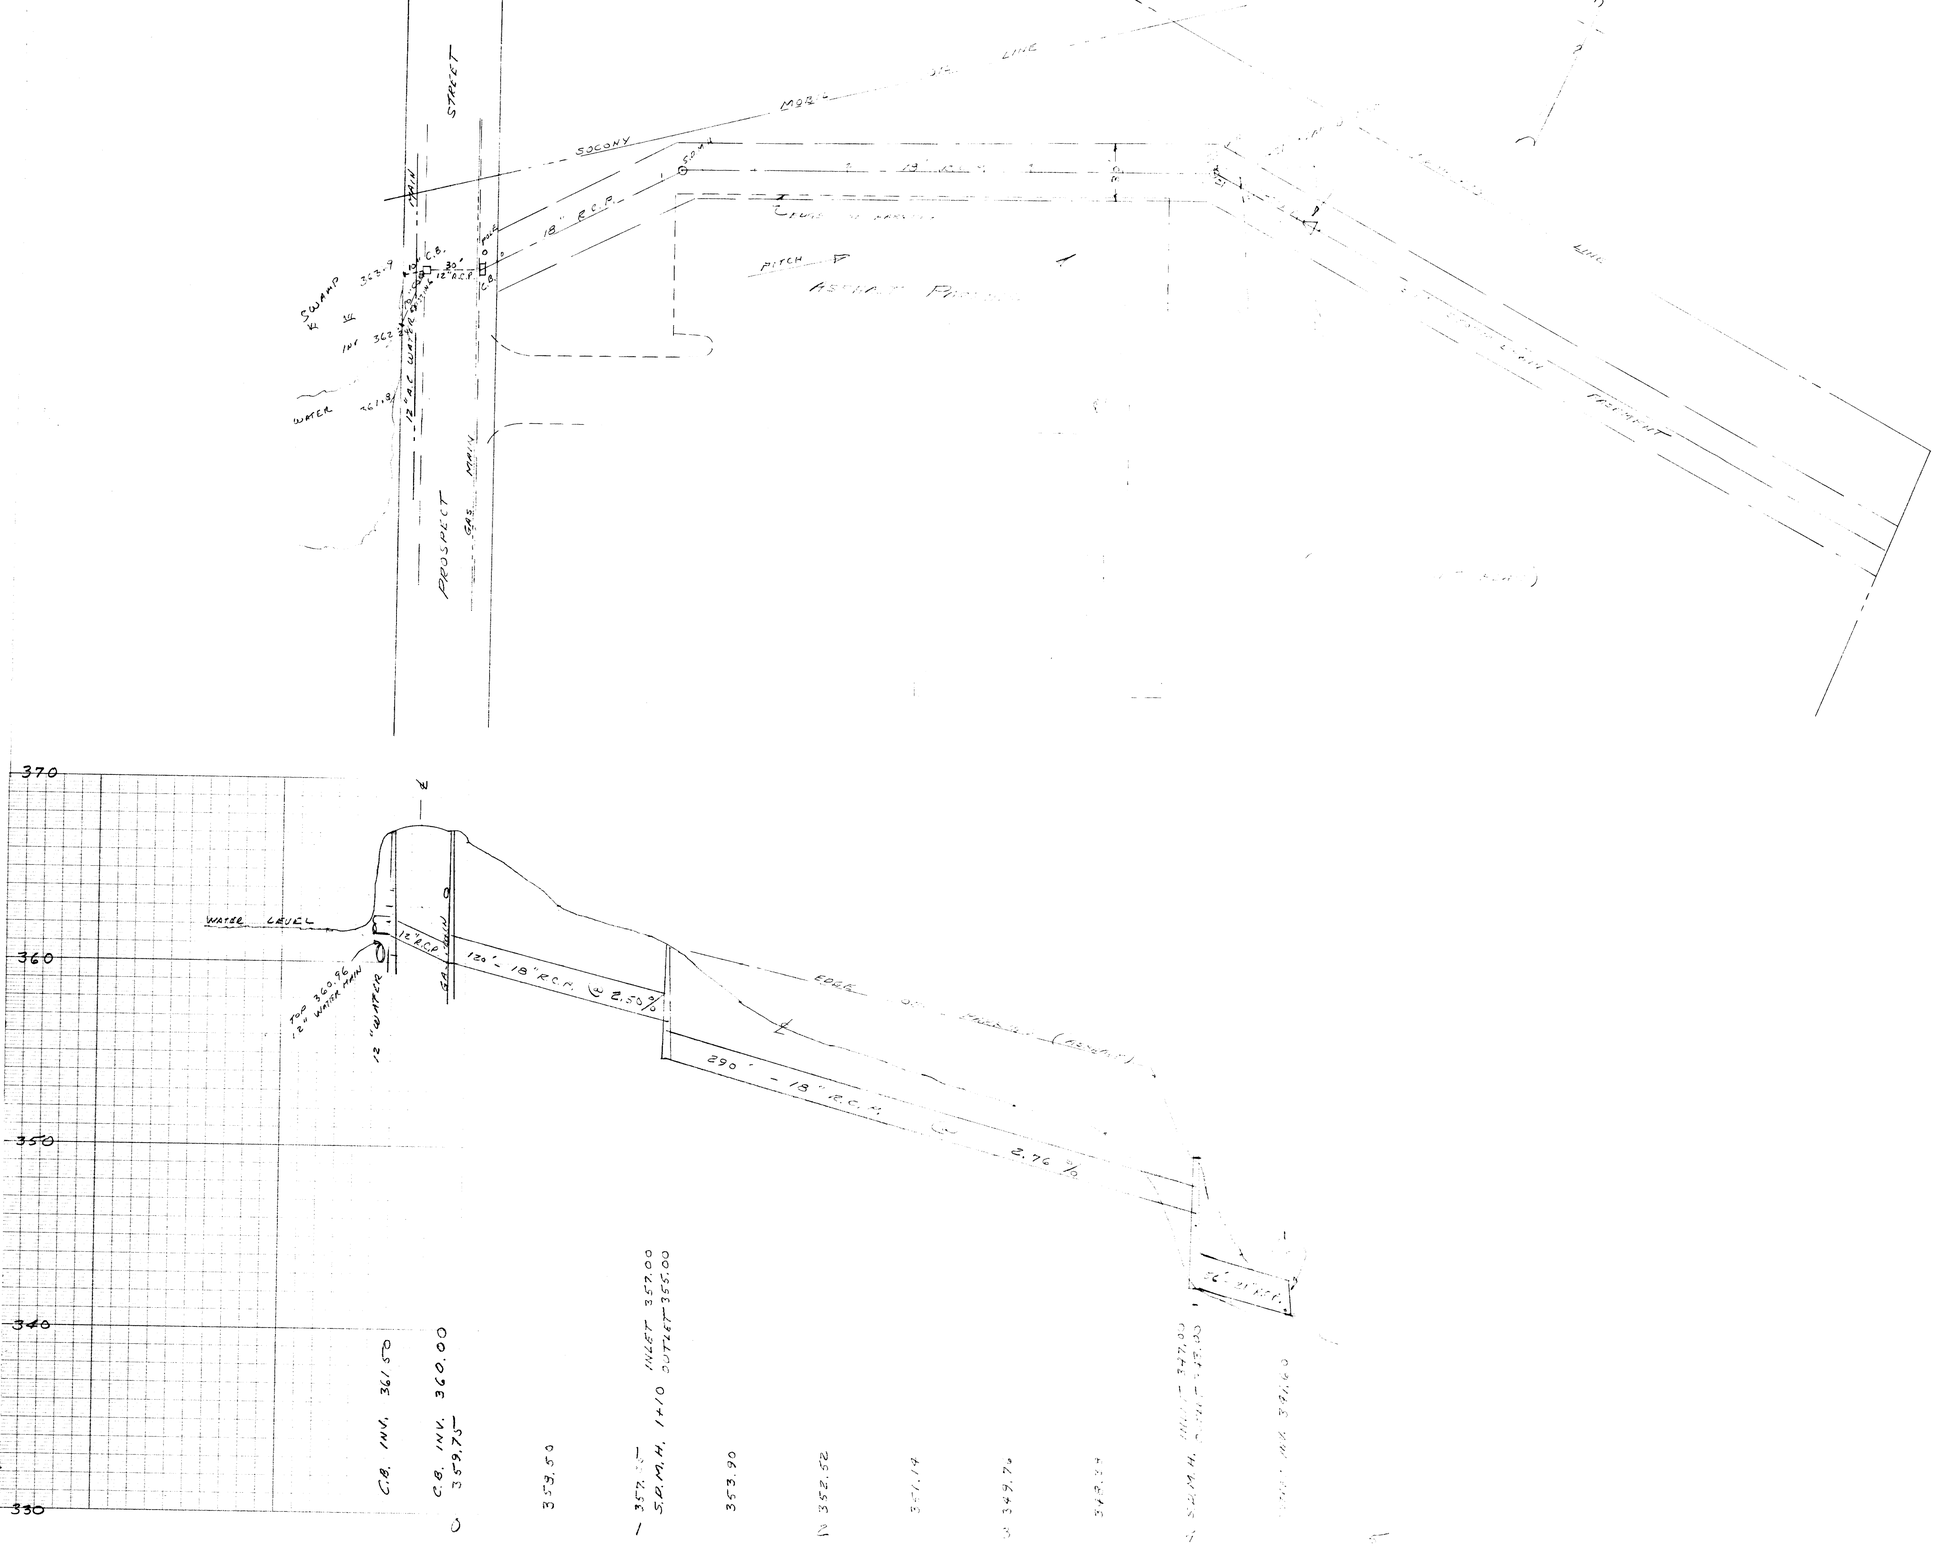

PLAN & PROFILE

PROSPECT STREET (STORM DRAIN)

EAST LONGMEADOW MASS

SCALE 1" - 40 FT HOR
1" - 4 FT VERT

1980

A A MELIEN TOWN ENG'R

SID 2006