PETER CARANDO JR.

RODNEY C. SCOTT

(A)

JOHN J. SEYLER

(B)

23

STEPHEN PERKINS
PATRICIA M. OTWAY

AVOID EXIST. TREES

C.Y.D. TOP 293.0 INV 288.7

B.M.H. OR D TOP 293.0 INV 288.2

D.J.D. TOP 292.0 INV 289.2

existing stream

location of old seasonal stream

inv. 287.44

inv. 282.58

inv. 280.9

inv. 280.51

tar drain

(22)

JOAN M. RUNQUIST

(21)

DONALD R. & JOAN M. TETRAULT

(20)

DWIGHT R. & DORIS B. MAGOVERN

GREENWICH ROAD

GREENWICH PLACE

WATER LINE

m.h. rim 291.52

basin rim 290.74
inv. 286.33
inv. 285.70

basin rim 289.27

m.h. rim 289.4

JANET A. ADELETTI

DRAIN EASM'T

DRAIN EASEMENT

bit. berm

hyd. rim 291.06 (town b.m.)

basin rim 288.44

basin rim 283.16

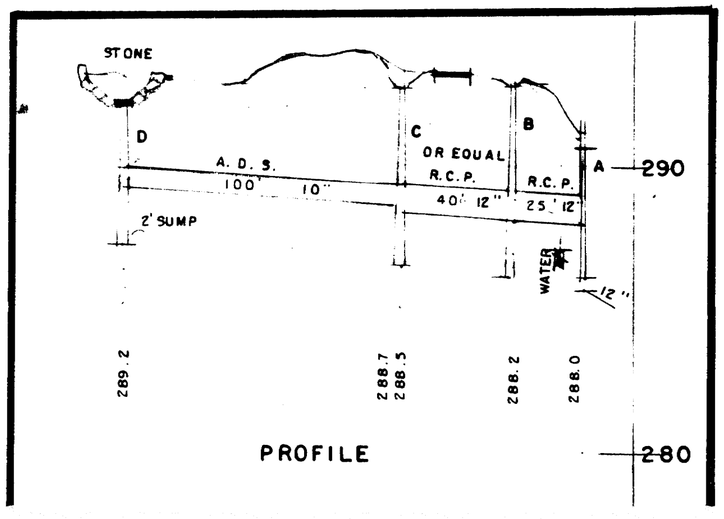

PROPOSED YARD DRAIN
LOT NO 23
EAST LONGMEADOW-M

DURKEE, WHITE, TOWNE & CHAPDELAI
CIVIL ENGINEERS
356 FRONT STREET, CHICOPEE, MAS

MARCH 8, 1984
SCALE 1"=40'
92-5273