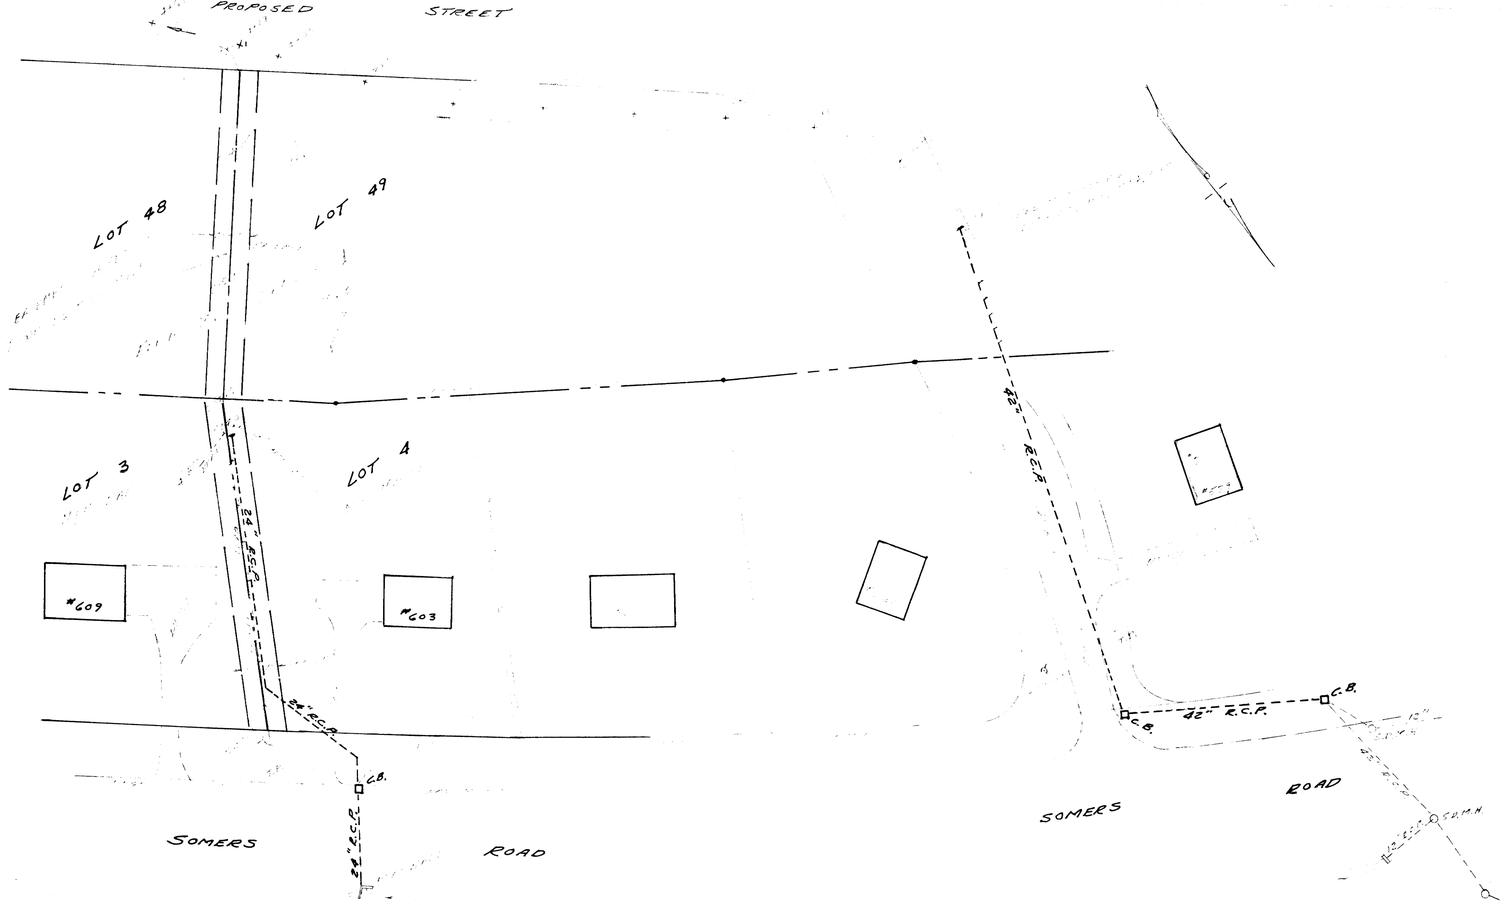

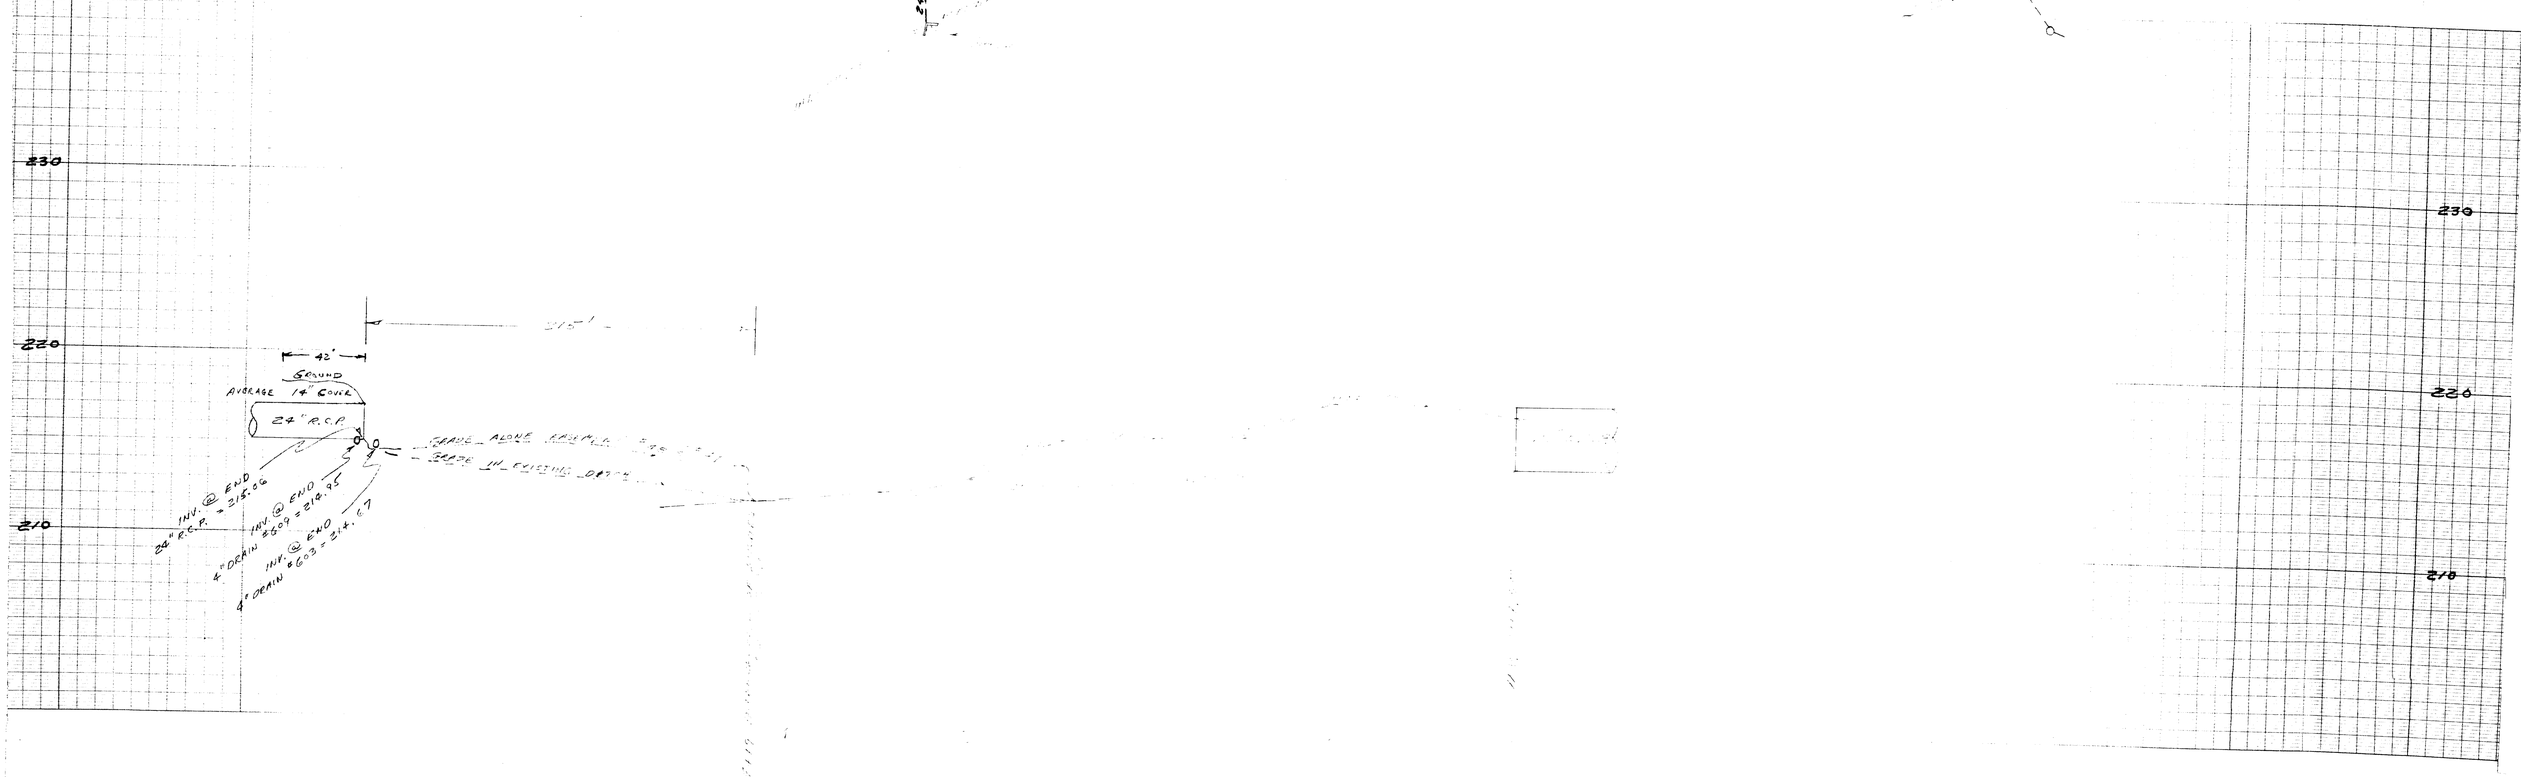

PLAN & PROFILE

STORM DRAIN EASEMENT

EAST LONGMEADOW MASS

SCALE 1" - 40 FT HOR
1" - 4 FT VERT

1981

A A MELIEN TOWN ENG'R

SD 221