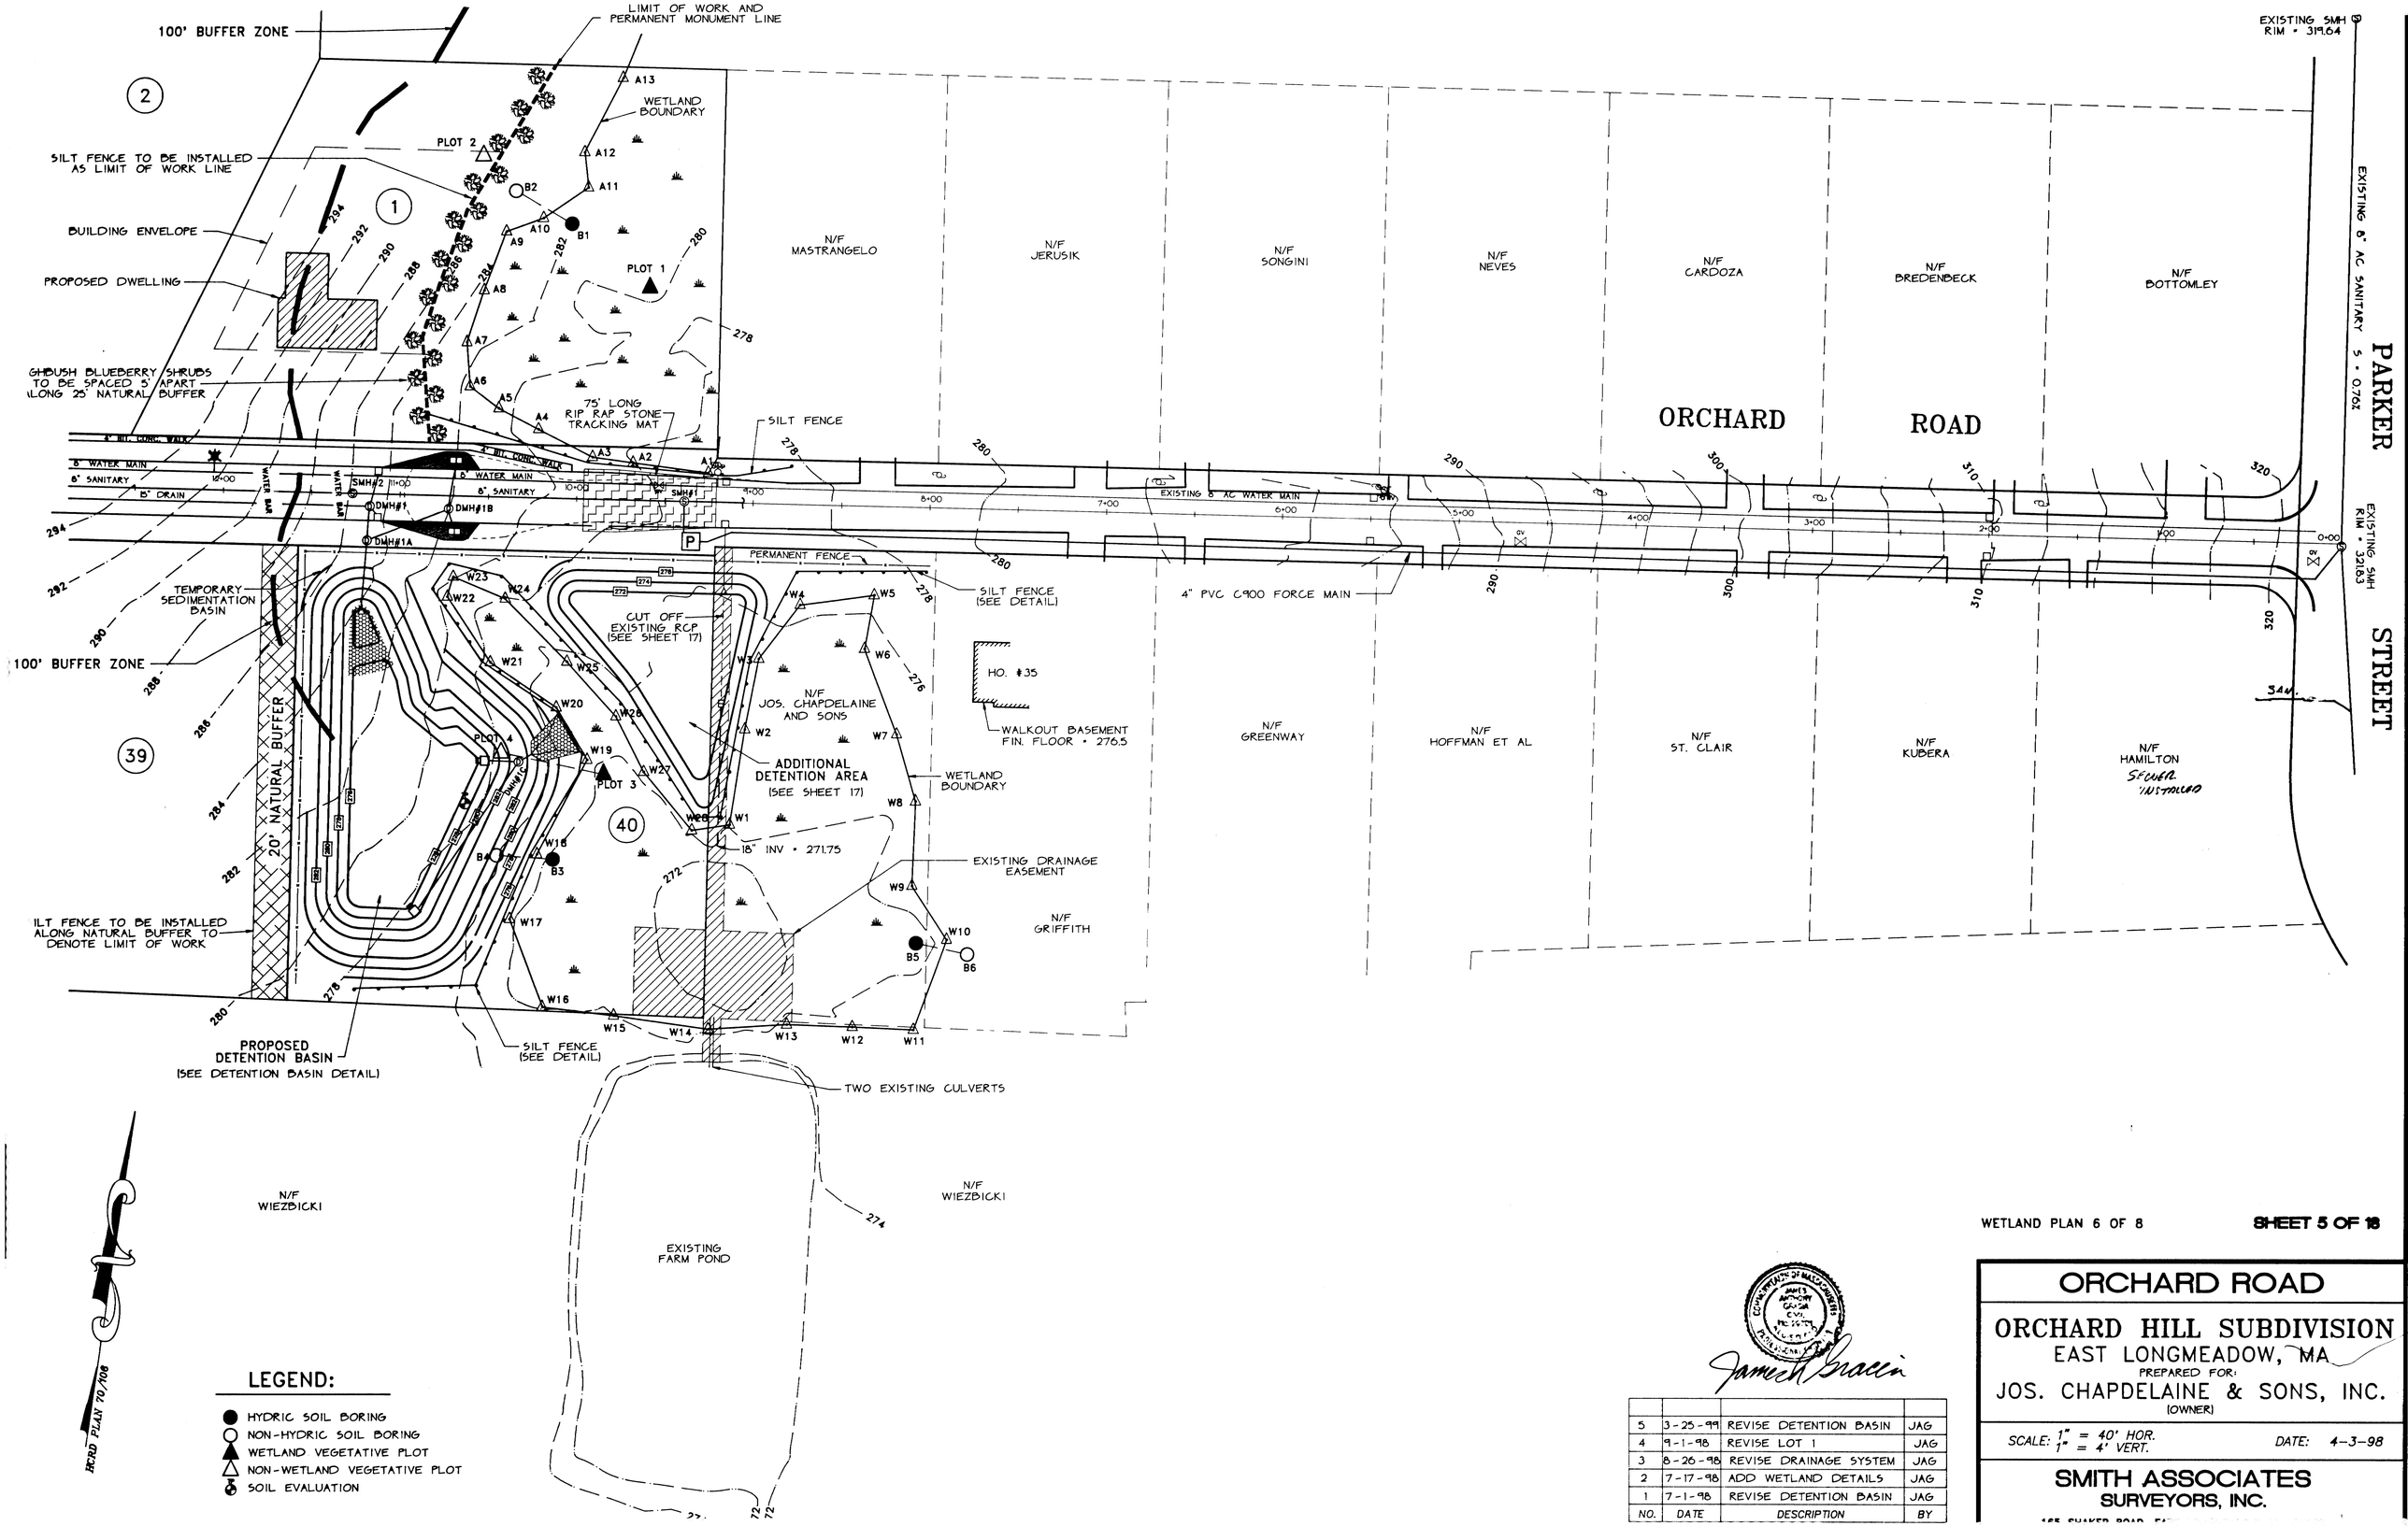

WETLAND PLAN 6 OF 8

SHEET 5 OF 18

NO.	DATE	DESCRIPTION	BY
5	3-25-99	REVISE DETENTION BASIN	JAG
4	9-1-98	REVISE LOT 1	JAG
3	8-26-98	REVISE DRAINAGE SYSTEM	JAG
2	7-17-98	ADD WETLAND DETAILS	JAG
1	7-1-98	REVISE DETENTION BASIN	JAG

ORCHARD ROAD

ORCHARD HILL SUBDIVISION

EAST LONGMEADOW, MA

PREPARED FOR:

JOS. CHAPDELAINE & SONS, INC.

(OWNER)

SCALE: 1" = 40' HOR.
1" = 4' VERT.

DATE: 4-3-98

SMITH ASSOCIATES
SURVEYORS, INC.

SD 251