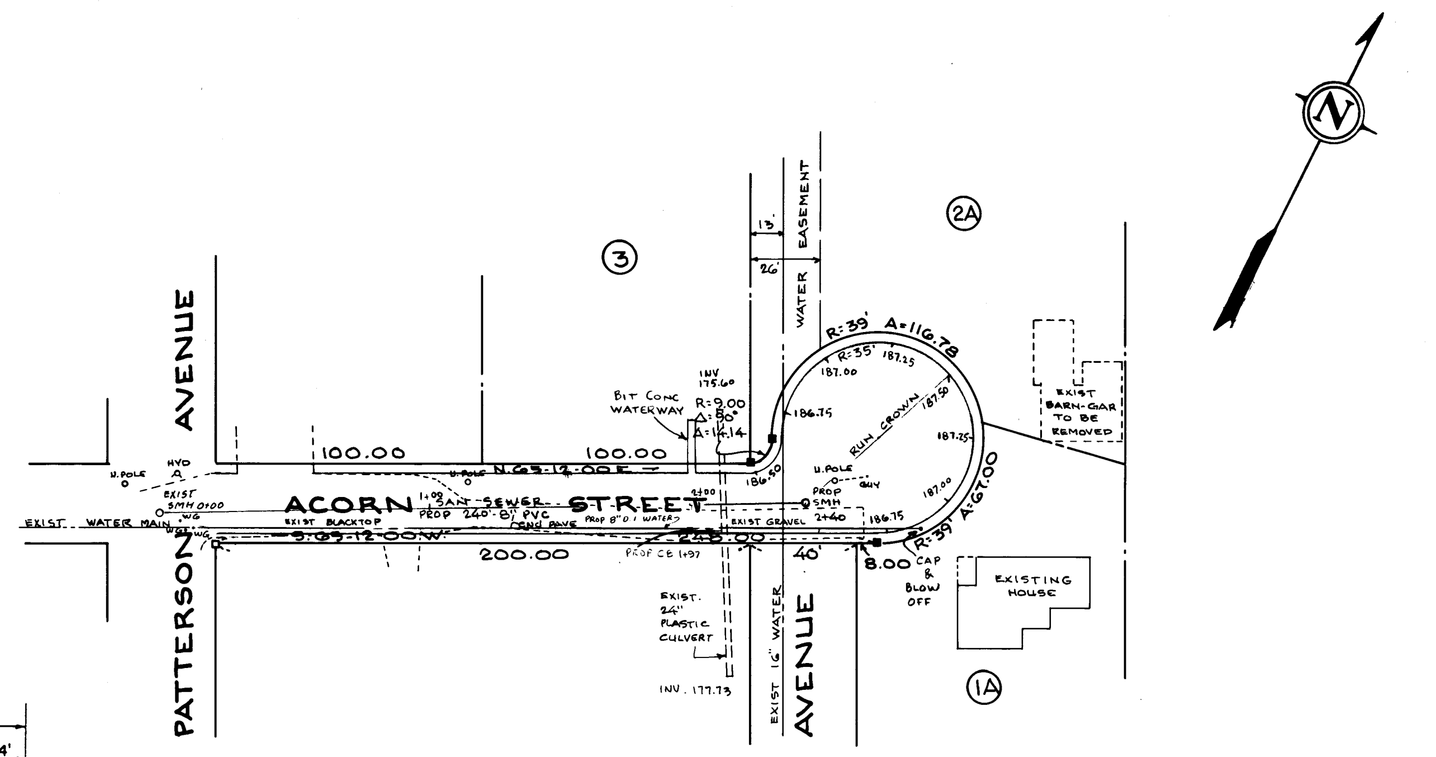

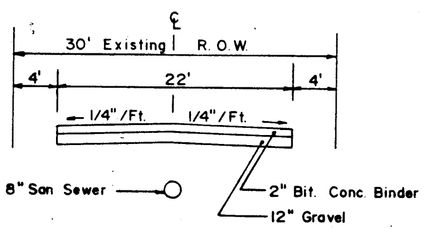

TYPICAL SECTION
ACORN STREET
NOT TO SCALE

HORIZONTAL
GRAPHIC SCALE
0 25 50 100 150
FEET

VERTICAL
GRAPHIC SCALE
0 25 5 10 15
FEET

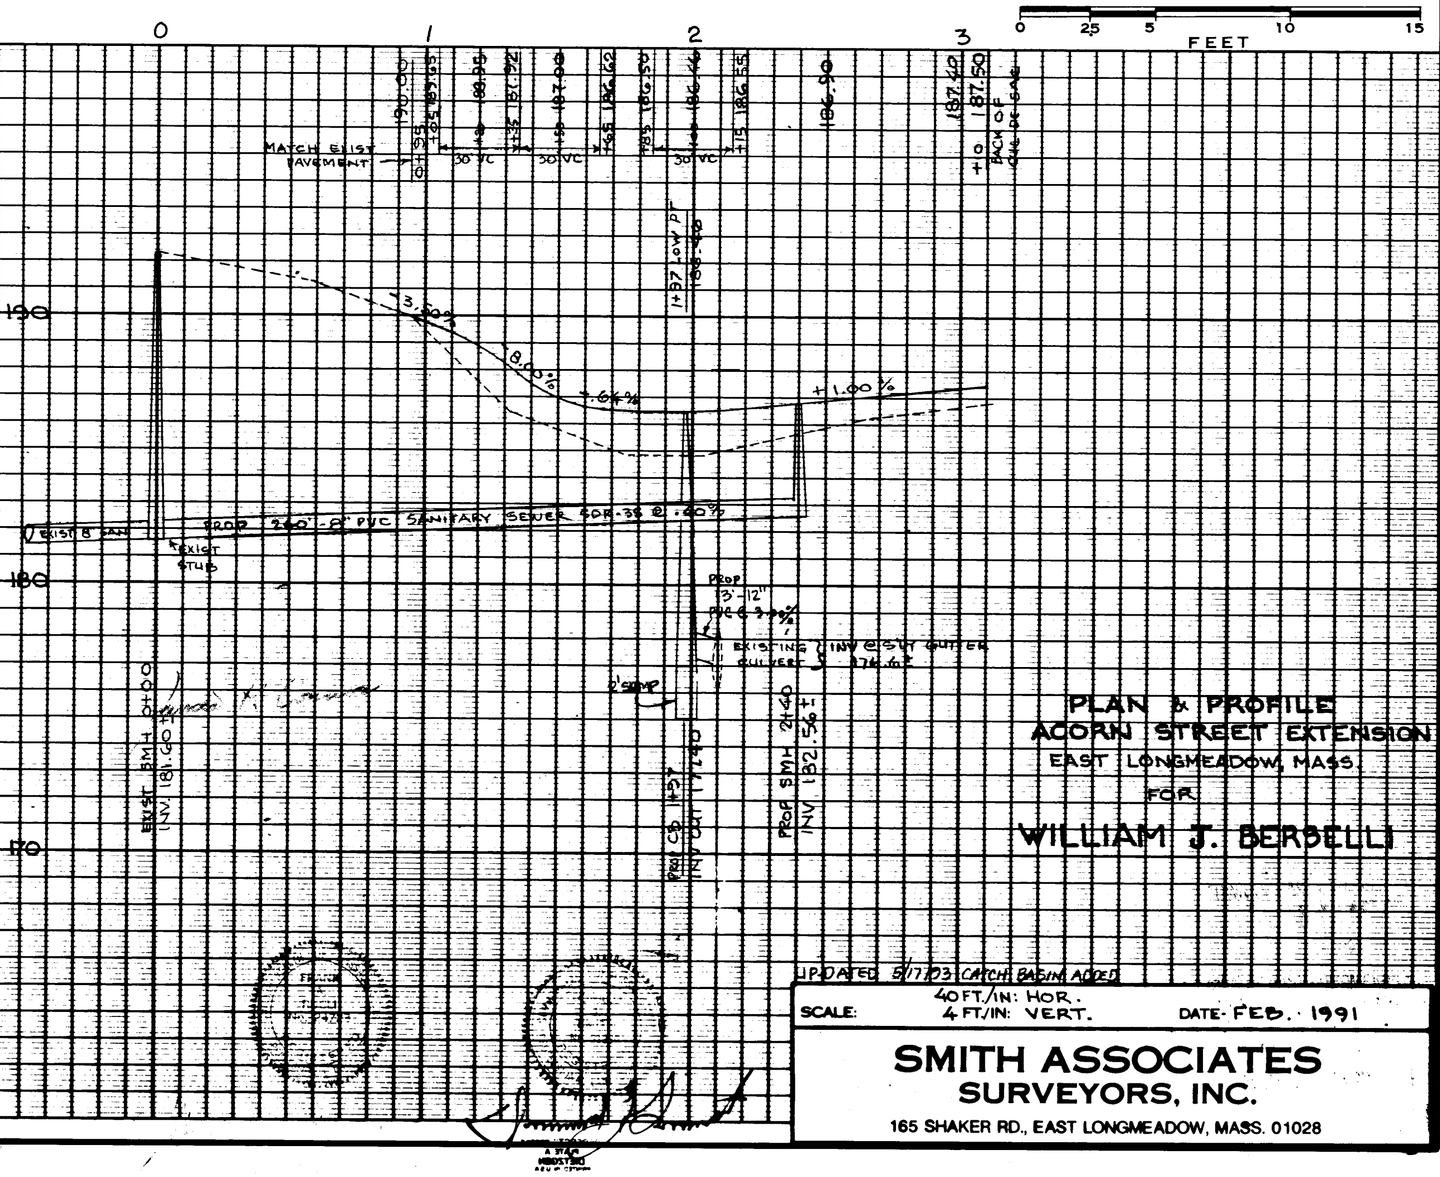

UPDATED 5/17/03 CATCH BASIN ADDED

SCALE: 40 FT./IN: HOR. 4 FT./IN: VERT. DATE: FEB. 1991

PLAN & PROFILE
ACORN STREET EXTENSION
EAST LONGMEADOW, MASS.
FOR
WILLIAM J. BERSELLI

SMITH ASSOCIATES
SURVEYORS, INC.
165 SHAKER RD., EAST LONGMEADOW, MASS. 01028