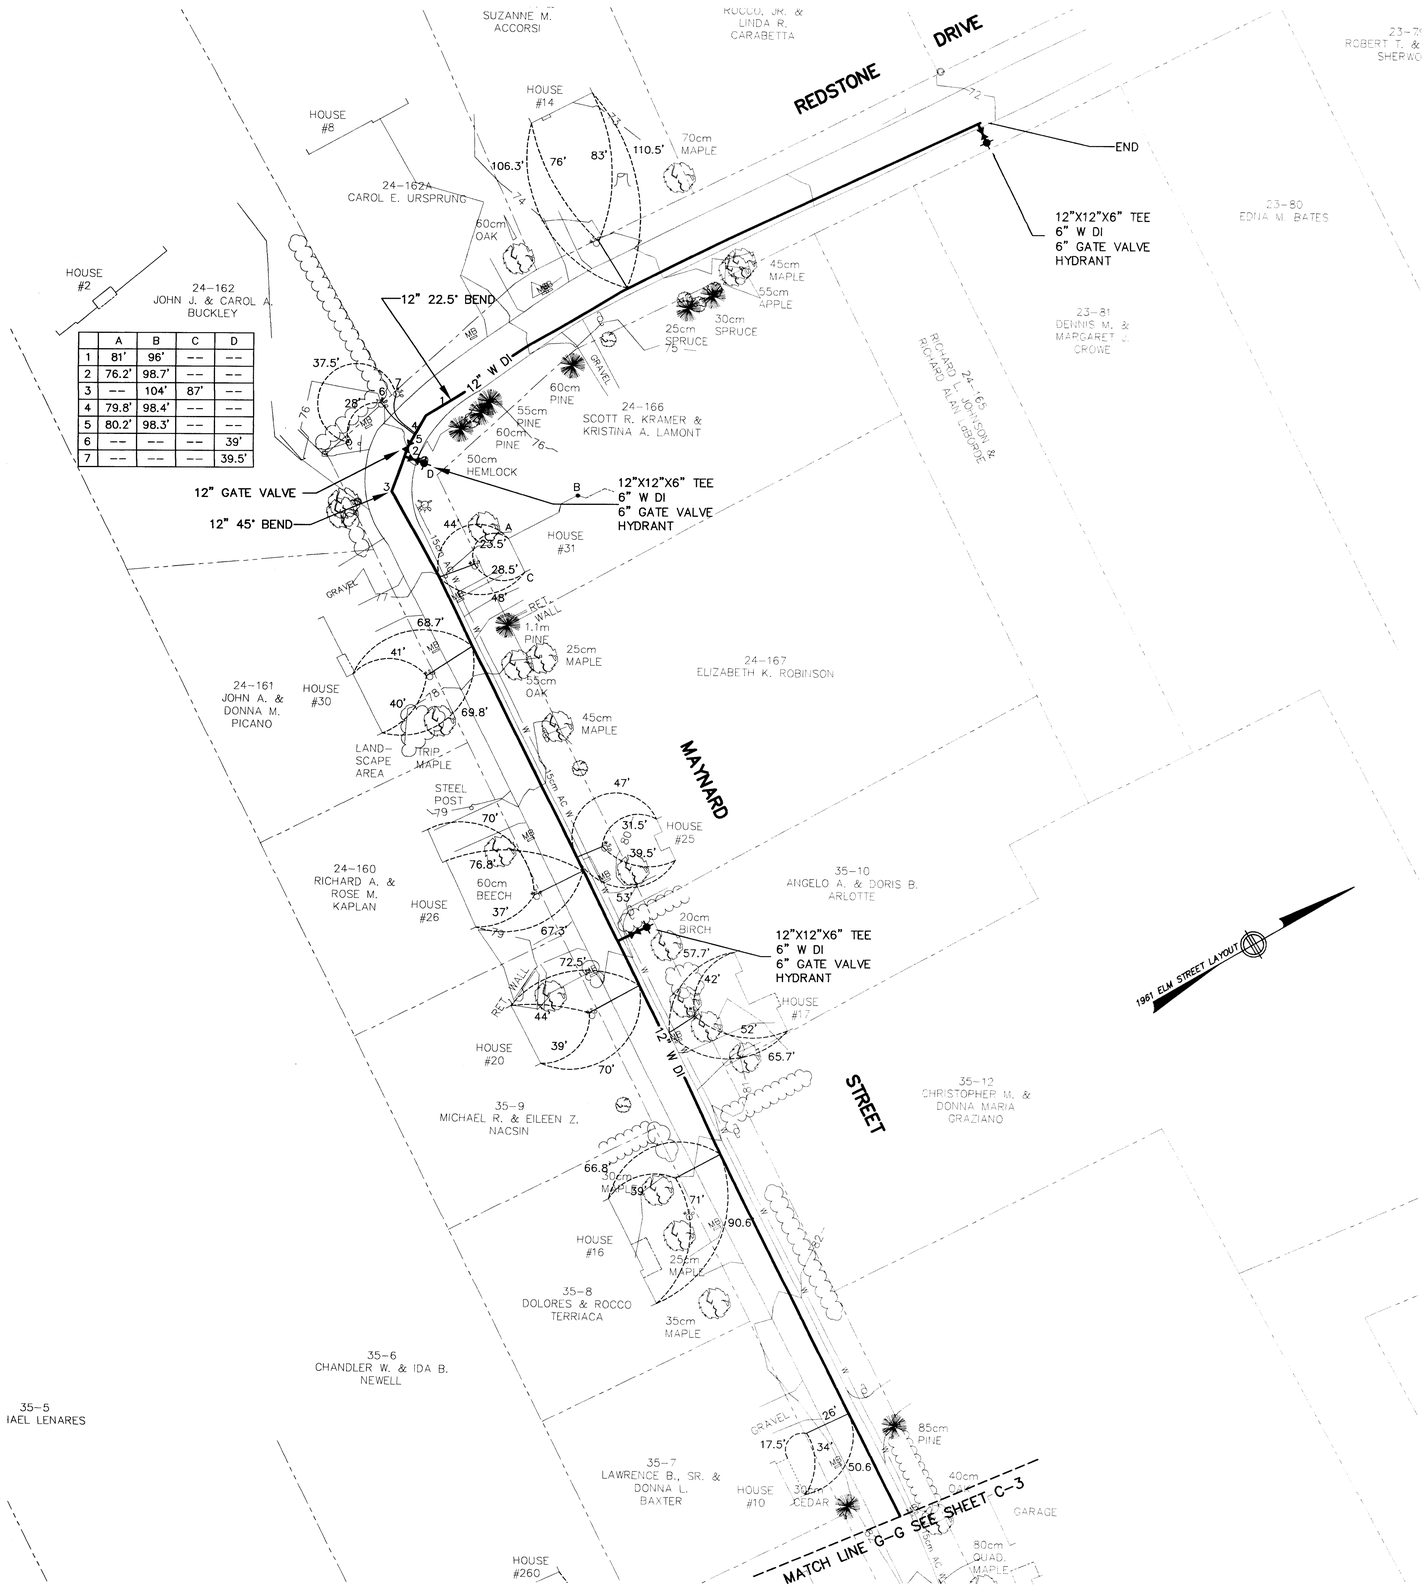

	A	B	C	D
1	81'	96'	--	--
2	76.2'	98.7'	--	--
3	--	104'	87'	--
4	79.8'	98.4'	--	--
5	80.2'	98.3'	--	--
6	--	--	--	39'
7	--	--	--	39.5'

RECORD DRAWING

Weston & Sampson
ENGINEERS, INC.
FIVE CENTENNIAL DRIVE, PEABODY, MA 01960

No.	Date	Dr.By	Ck.By	App.By	Description
1	2/99	WGS	DRW	JLM	REVISED FOR RECORD DRAWING

APPROVED

REGISTERED PROFESSIONAL ENGINEER

DATE

TOWN OF EAST LONGMEADOW, MASSACHUSETTS
BOARD OF PUBLIC WORKS
ELM STREET AREA WATER IMPROVEMENTS

MAYNARD STREET AND REDSTONE DRIVE

CADD NO.	SCALE:	CONTRACT:	JOB NO.	DR.BY	CK.BY	APP.BY
R-C5	1"=40'		98068	WGS	DRW	JLM

C-5

FILE NO. 107-21

SHEET 7 OF 8