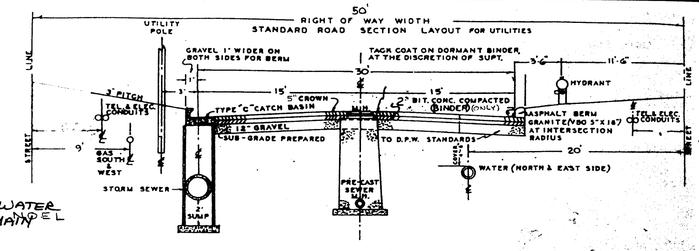

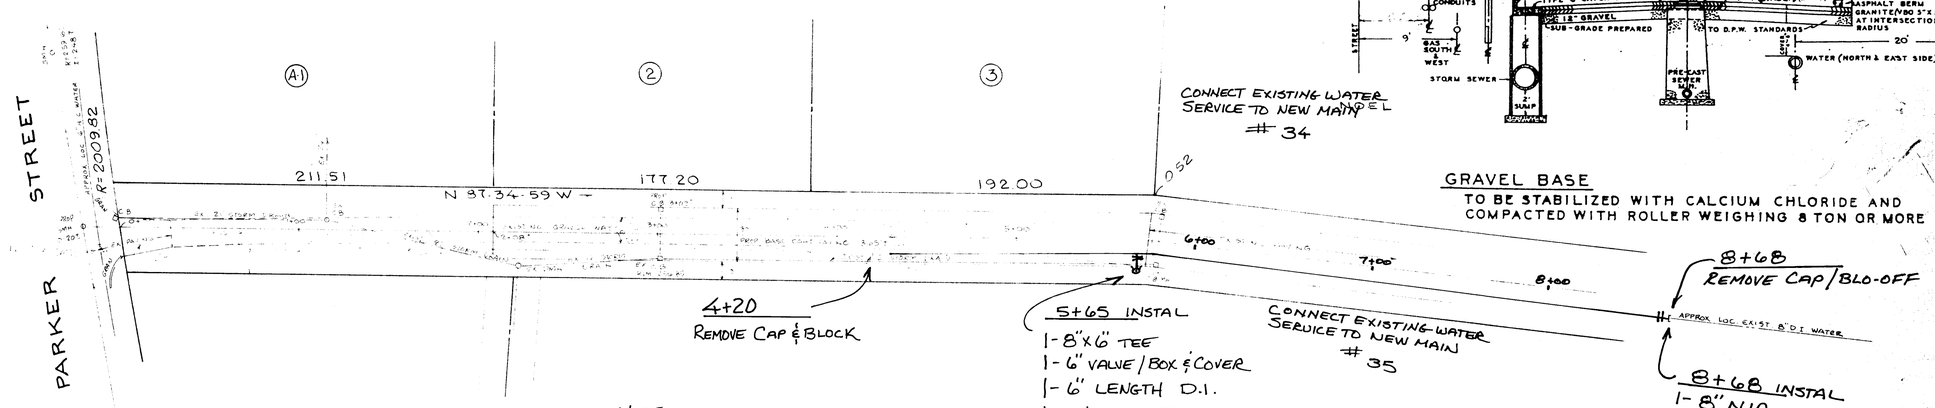

CONNECT EXISTING WATER SERVICE TO NEW MAIN #34

GRAVEL BASE

TO BE STABILIZED WITH CALCIUM CHLORIDE AND COMPACTED WITH ROLLER WEIGHING 8 TON OR MORE

NOTE: NEW WATER MAIN TO BE AIR & BACTERIA TESTED PRIOR TO CONNECTION OF HOUSES #34 & 35

CONTRACTOR TO NOTIFY RESIDENTS 48 HOURS PRIOR TO LOSS OF WATER SERVICE

NOTE: NEW WATER MAIN TO MAINTAIN 4.5 MINIMUM BURY

NEW WATER MAIN TO BE FILLED USING HYDRANT TO HYDRANT METHOD

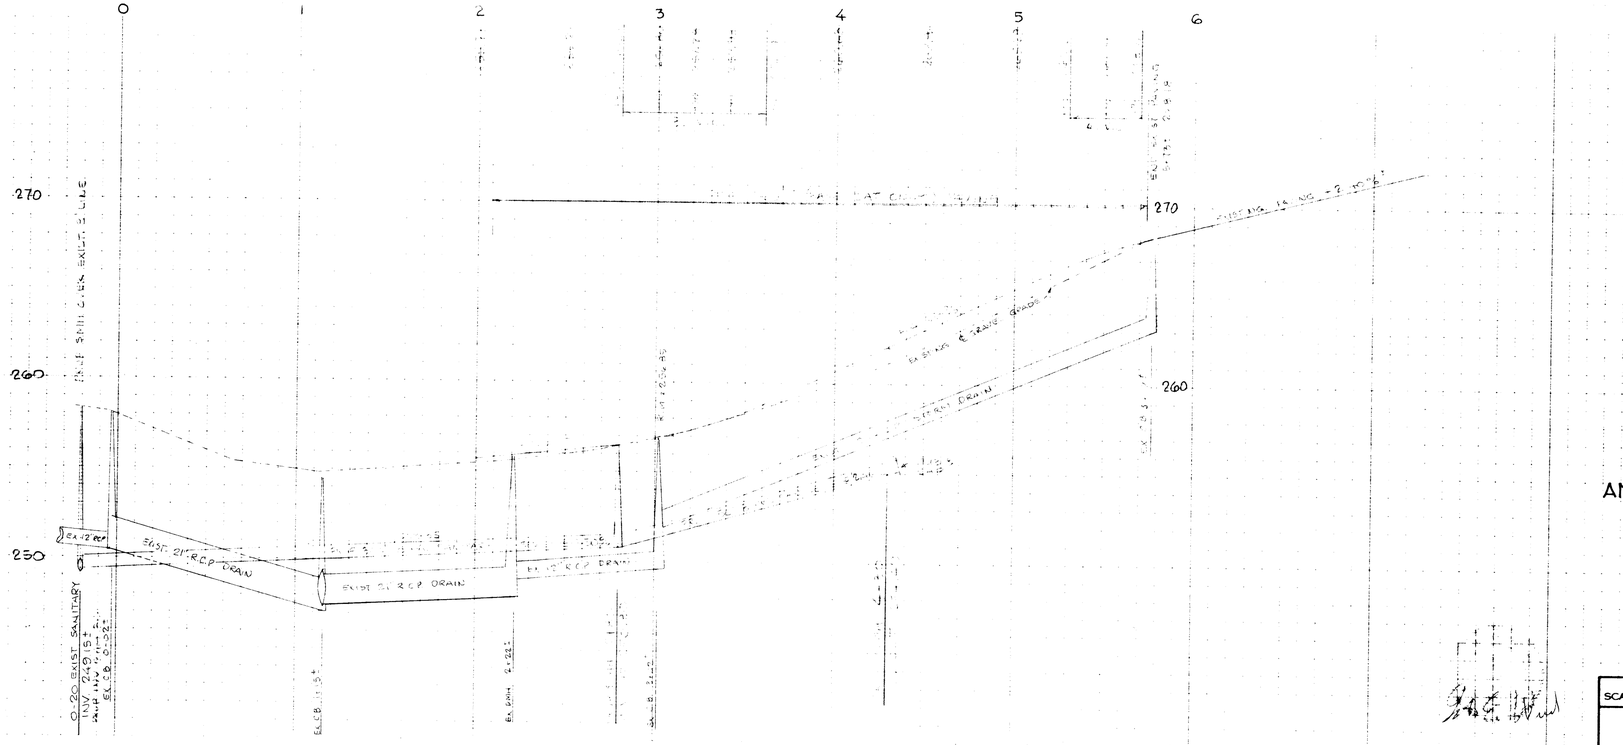

PLAN AND PROFILE
TIMBER DRIVE
EAST LONGMEADOW, MA.
PREPARED BY
ANTONIO M. & DIANE M. GOMES

SCALE: 4 FT/IN: VERT
40 FT/IN: HOR.
DATE: MAY 1997

SMITH ASSOCIATES
SURVEYORS, INC.
165 SHAKER RD., EAST LONGMEADOW, MASS. 01028