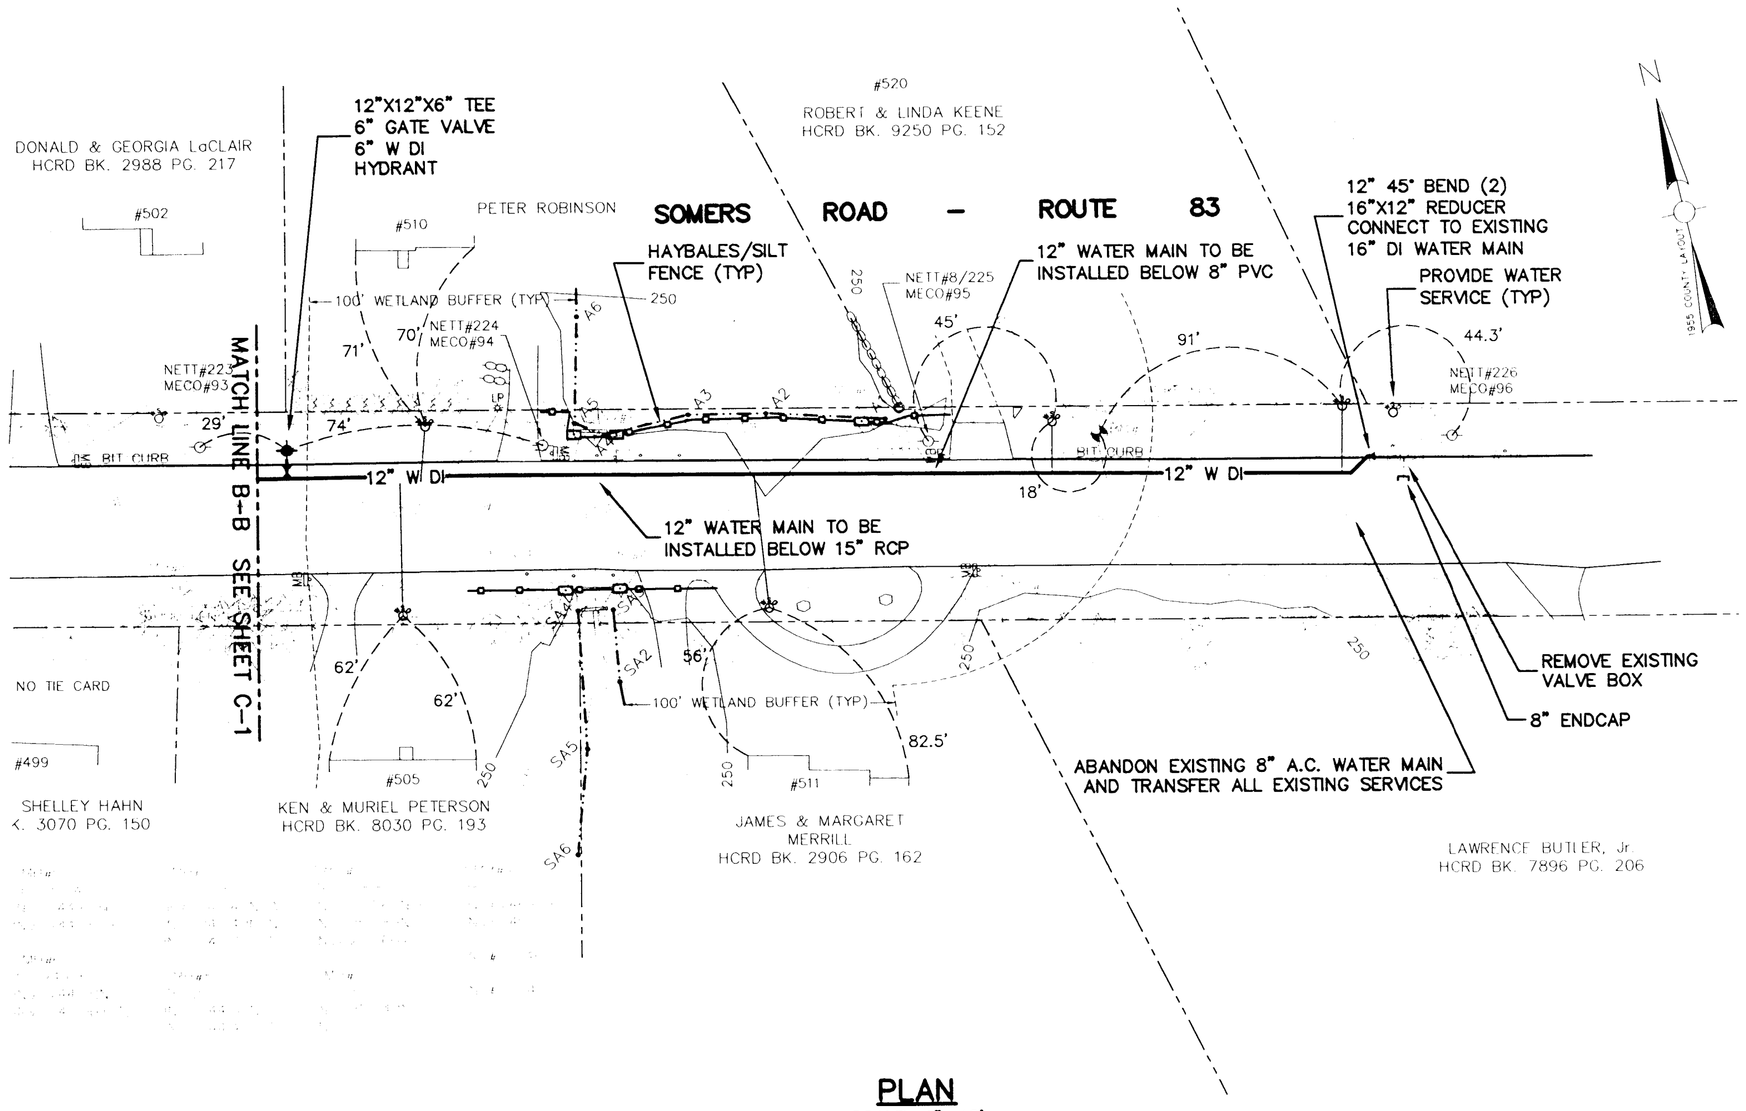

PLAN
SCALE: 1"=40'

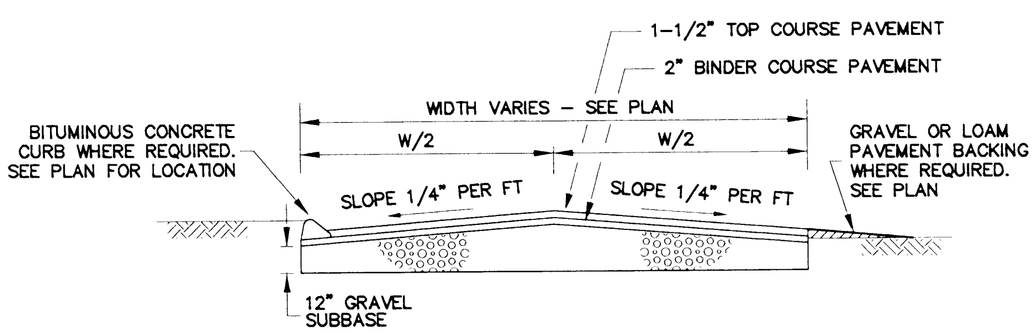

TYPICAL SECTION THROUGH SOUTH BEND ROAD
N.T.S.

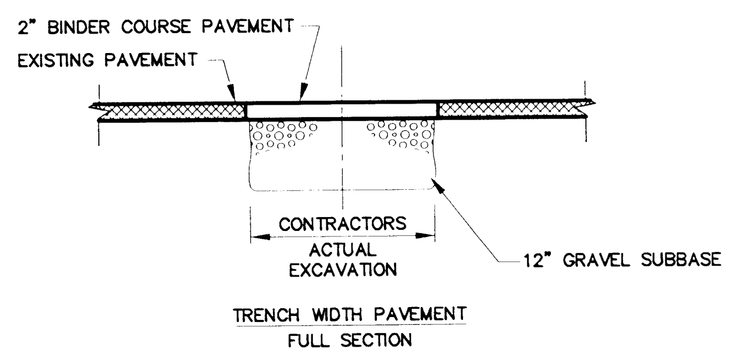

TEMPORARY PAVEMENT REPLACEMENT DETAIL
N.T.S.

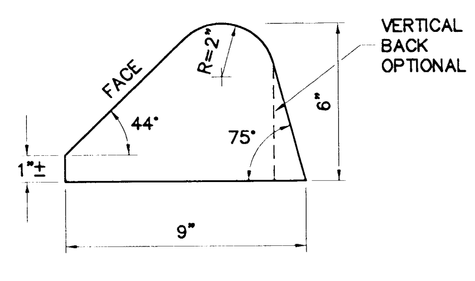

CURB DETAIL
CURB IS TYPE-2 PER MASS.
DPW CONSTRUCTION STANDARDS

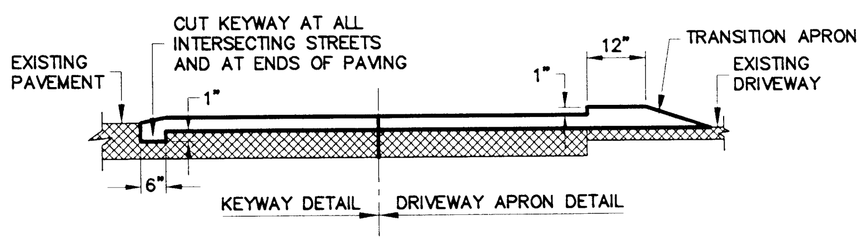

KEYWAY AND DRIVEWAY APRON DETAIL
N.T.S.

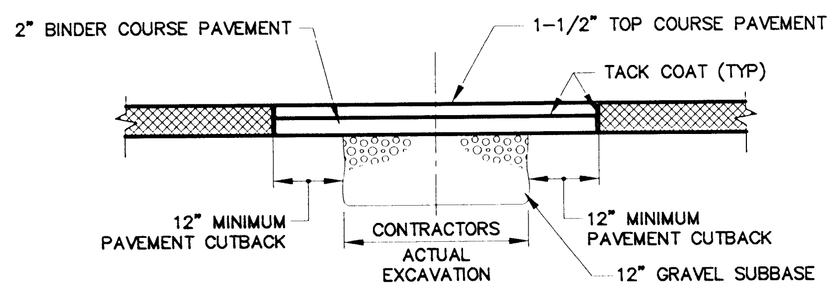

TRENCH REPAIR FOR SOMERS ROAD
N.T.S.

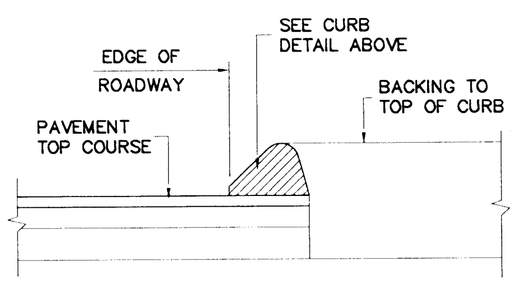

BITUMINOUS CONCRETE CURB
N.T.S.

RECORD DRAWING

Weston & Sampson
ENGINEERS, INC.
Five Centennial Drive, Peabody, MA 01960-7985

No.	Date	Description
1	11/01	RECORD DRAWING

Dr. By	WGS	Ck. By	DRL
App. By	PJC		

APPROVED
REGISTERED PROFESSIONAL ENGINEER
11/20/01
DATE

COMMONWEALTH OF MASSACHUSETTS
PATRICK J. CONNELLY
CIVIL
No. 31458
REGISTERED PROFESSIONAL ENGINEER

TOWN OF EAST LONGMEADOW, MASSACHUSETTS
BOARD OF PUBLIC WORKS
SOMERS ROAD HIGH SERVICE WATER MAIN REPLACEMENT
SOMERS ROAD - STATION 7+65 TO 11+47
DETAILS

CADD NO.	SCALE	CONTRACT	JOB NO.	DR. BY	DSN. BY	CHK. BY	APP. BY
RC-2	1"=40'		200096	WGS	WGS	DRL	PJC

C-2

FILE NO.

SHEET 4 OF 5