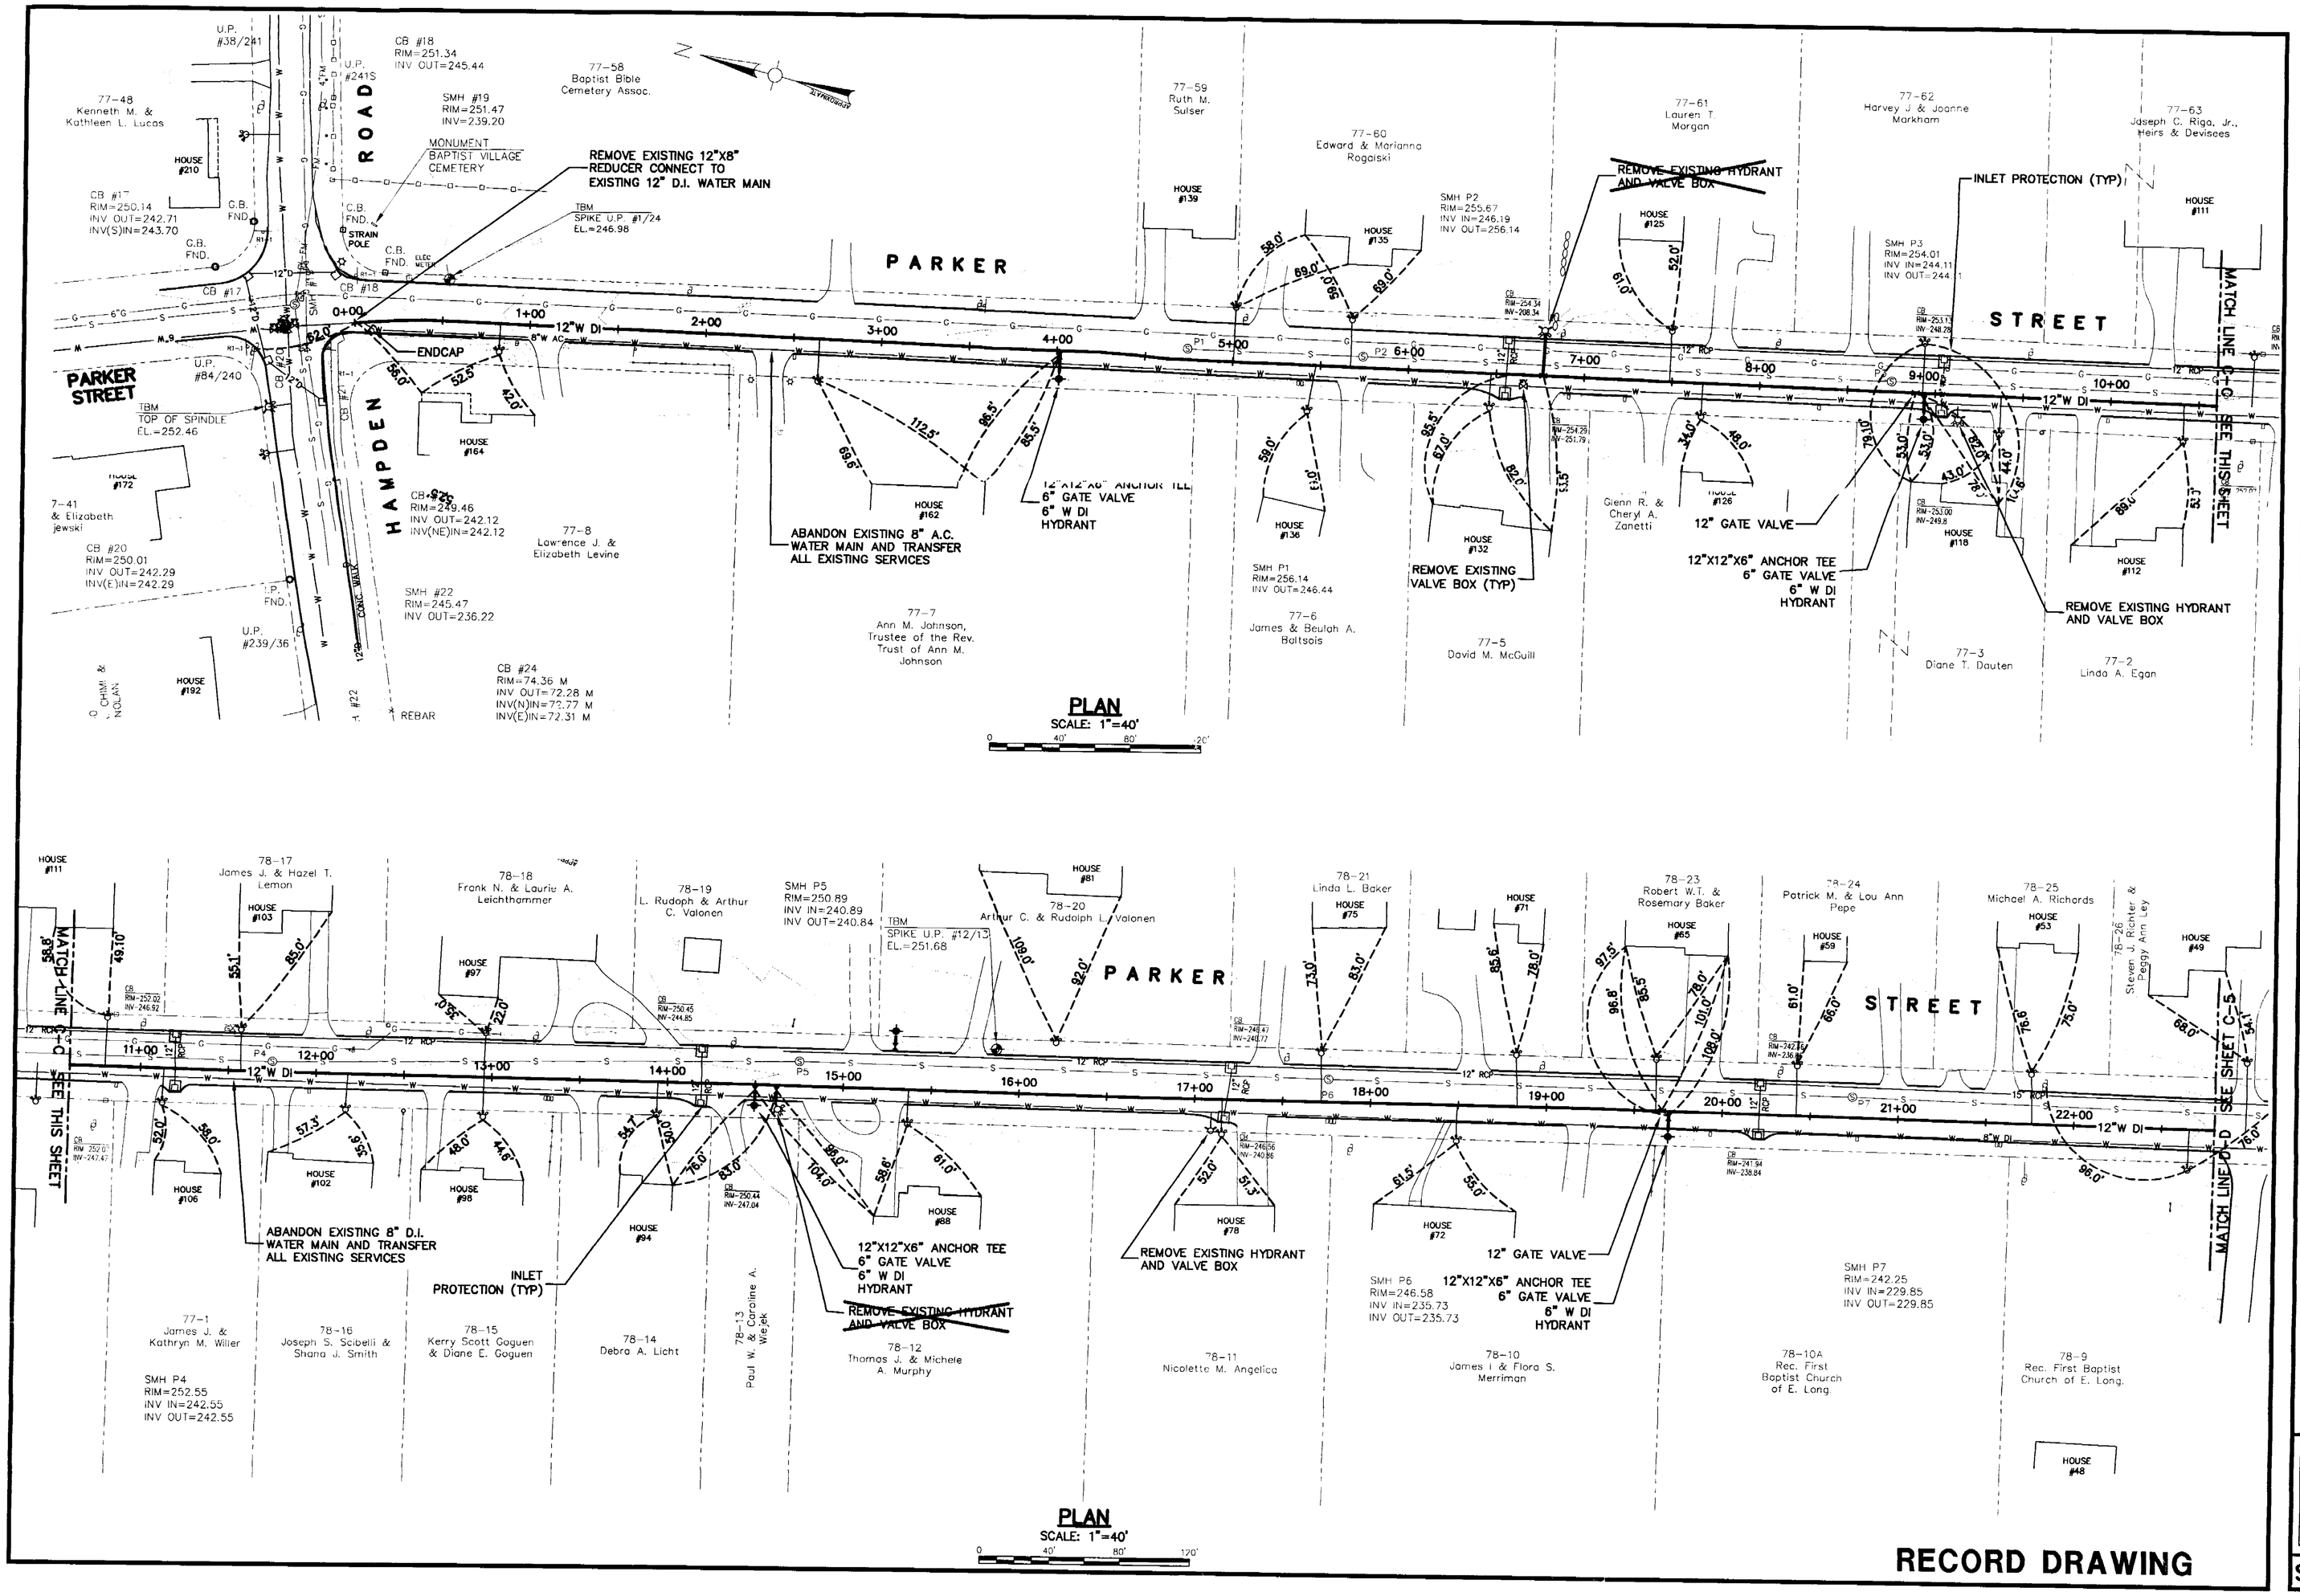

RECORD DRAWING

Weston & Sampson ENGINEERS, INC.

No.	Date	Description
1	2/04	RECORD DRAWING

WGS	DRL			
Dr.By	Ck.By	Ap.By		
A	P	P	R	O V E D

REGISTERED PROFESSIONAL ENGINEER

DATE

TOWN OF EAST LONGMEADOW
BOARD OF PUBLIC WORKS
WATER MAIN IMPROVEMENTS PROJECT

PARKER STREET STA 0+00 TO 22+80

CADD NO. RPARKER	SCALE: 1"=40'	CONTRACT:	JOB NO. 202038	DR.BY WGS	DSN.BY WGS	CHK.BY DRL	APP.BY PJC

C-4

FILE NO. 141-17

SHEET 6 OF 13