NOTES:

1. TEMPORARY WATER SERVICE SHALL BE PROVIDED FOR ALL WATER MAIN REPLACEMENT ON SMITH AVENUE TO ELIMINATE SERVICE INTERRUPTIONS DURING THE INSTALLATION OF THE 8" DI WATER MAIN FROM SAUGUS AVENUE TO WESTWOOD AVENUE. TEMPORARY SERVICES SHALL BE MAINTAINED UNTIL THE 8" DI WATER MAIN HAS BEEN DISINFECTED, PRESSURE TESTED AND SERVICE LINES ARE CONNECTED

2. EXISTING A.C. WATER MAIN TO BE REMOVED ONLY WHEN NECESSARY FOR THE INSTALLATION OF THE 8" DI WATER MAIN

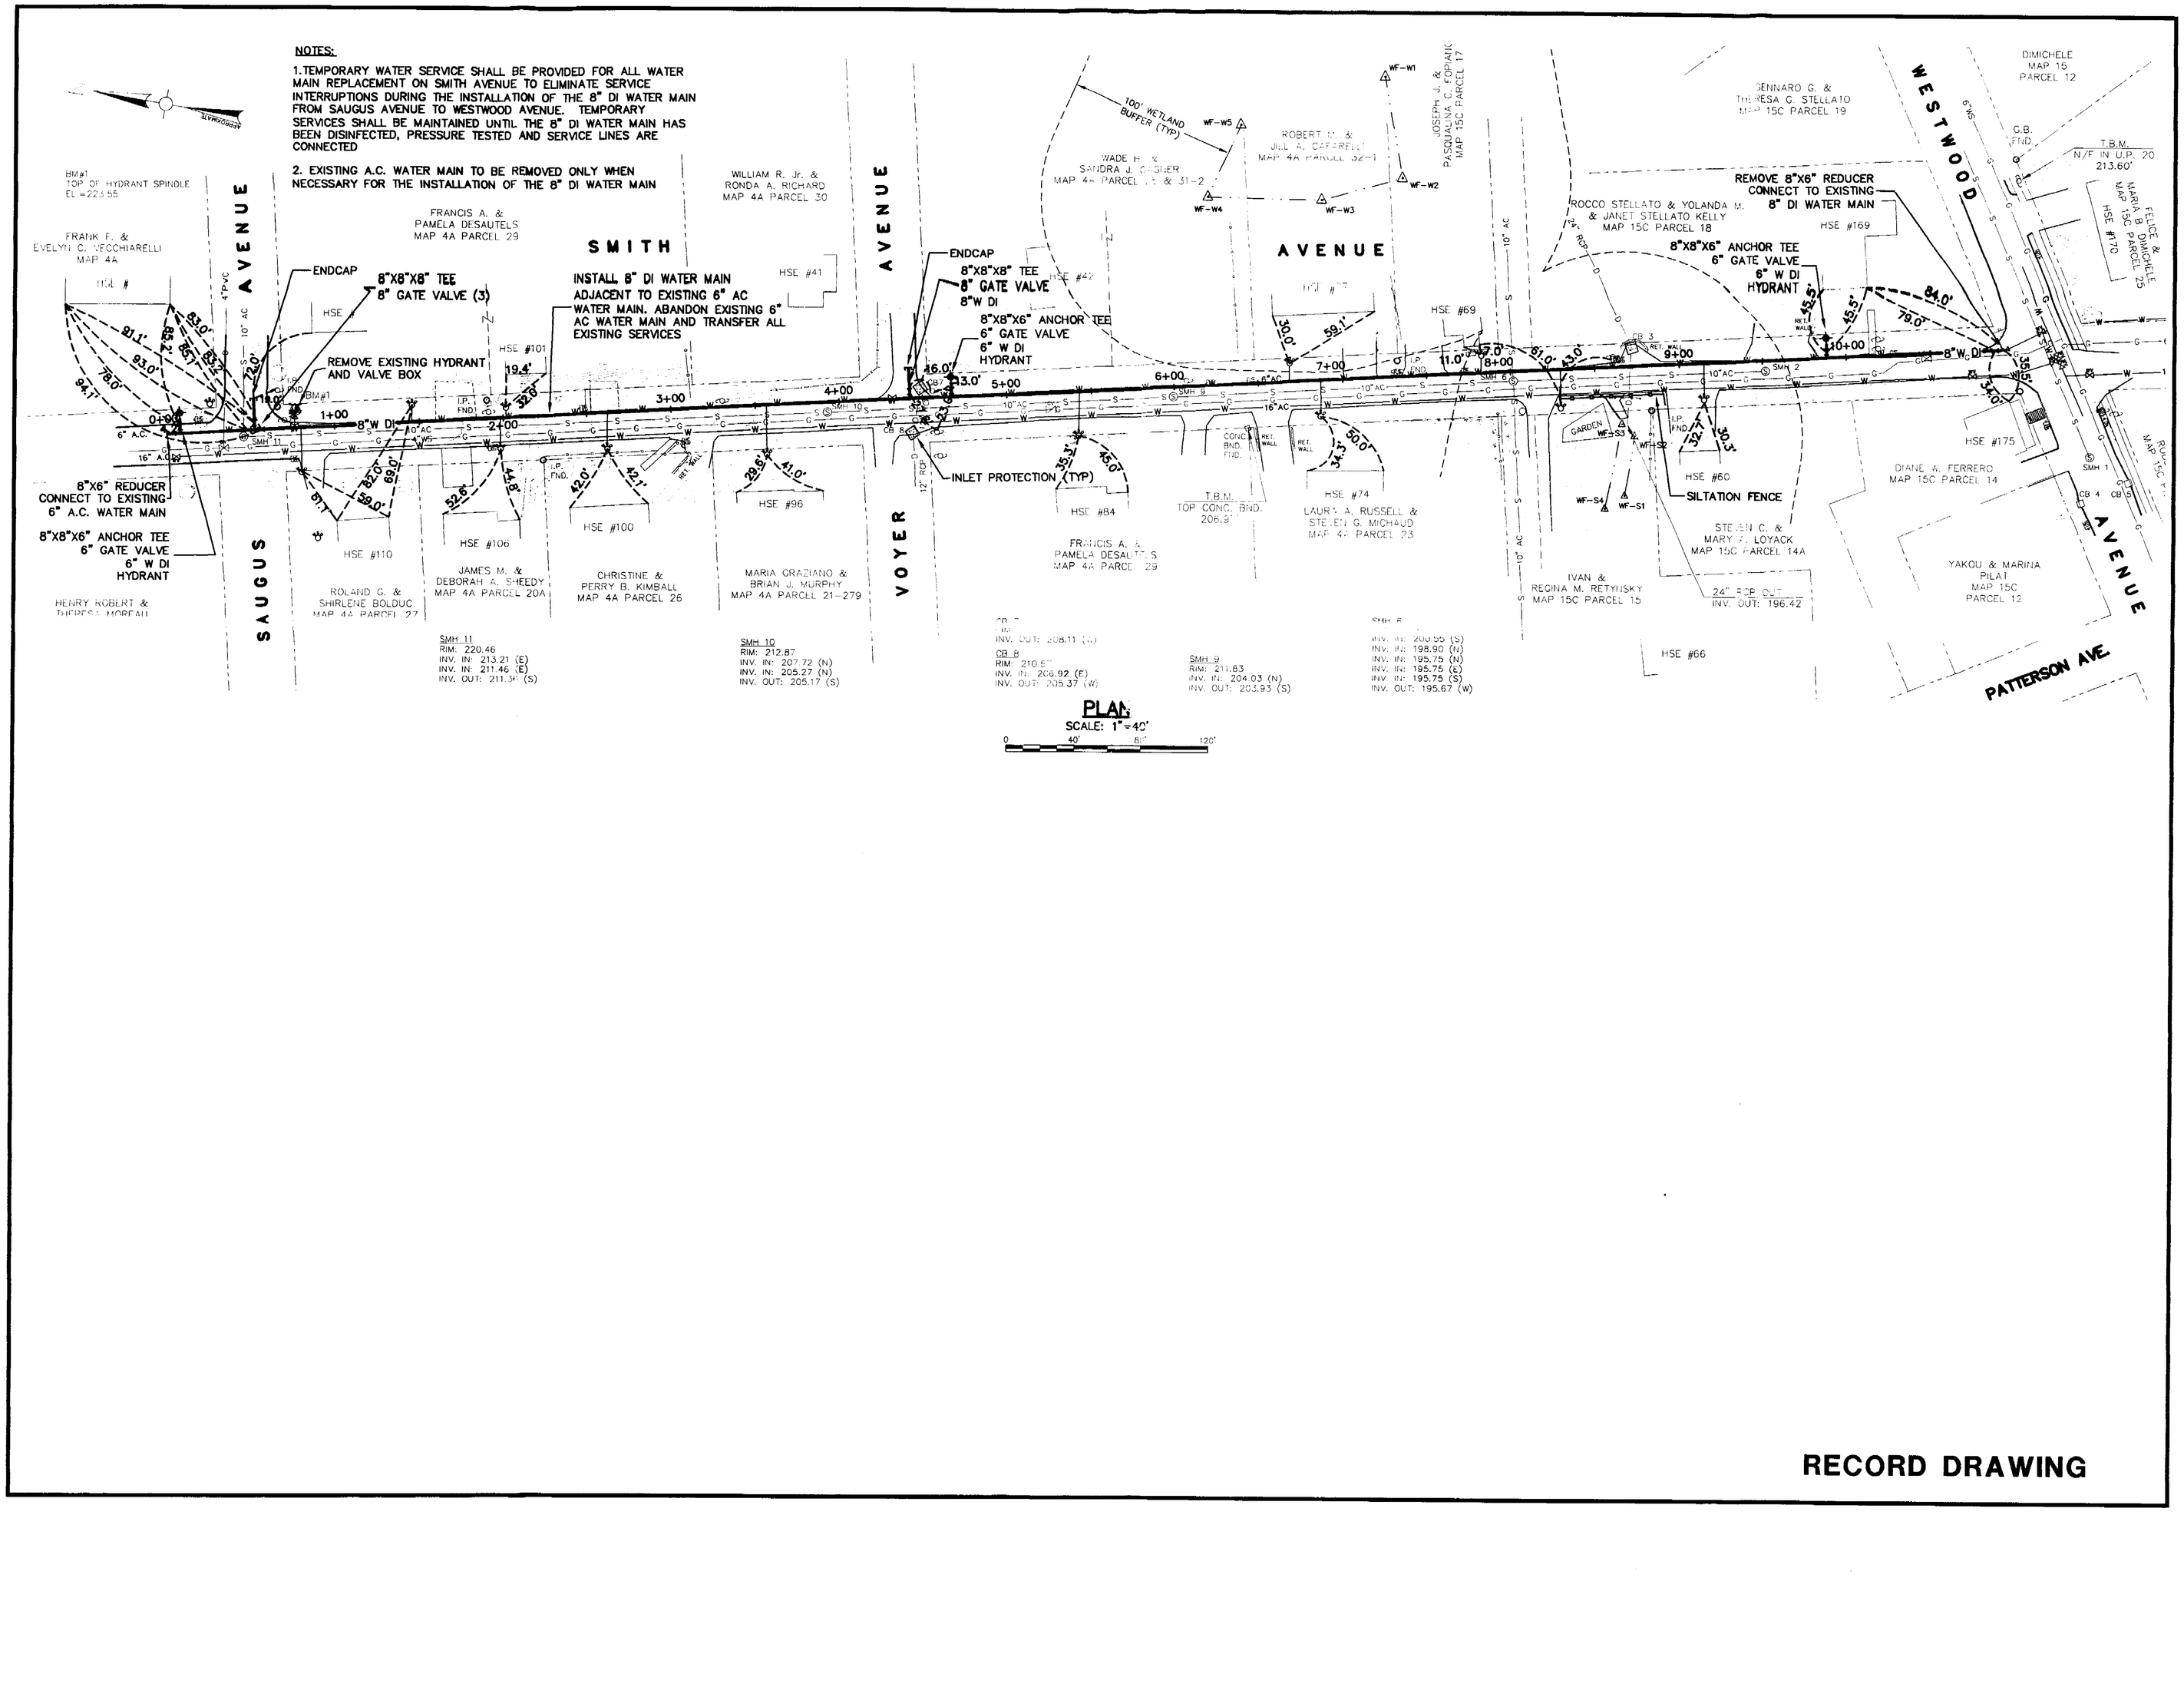

RECORD DRAWING

Weston & Sampson
ENGINEERS, INC.

No.	Date	Dr.By	Ck.By	App.By	Description
1	2/04	WGS	DRL		RECORD DRAWING

APPROVED

REGISTERED PROFESSIONAL ENGINEER DATE

TOWN OF EAST LONGMEADOW
BOARD OF PUBLIC WORKS
WATER MAIN IMPROVEMENTS PROJECT

SMITH AVENUE STA 0+00 TP 10+95

CADD NO.	SCALE:	CONTRACT:	JOB NO.	DR.BY	DSN.BY	CHK.BY	APP.BY
RSMITH	1"=40'		202038	WGS	WGS	DRL	PJC

C-9

FILE NO. 141-12

SHEET 11 OF 13