STA 0+00 PORTER ROAD CONNECTION:

1-12" TAPPING SLEEVE
1-12" GATE VALVE & BOX
1-12" NIPPLE, 3' LONG
1-12" 45° BEND
1-12" 45° BEND TO RAISE OVER STORM DRAIN
1-12" 22½° BENDTO TURN DOWN HORIZONTAL

STA 4+00 NEW HYDRANT:

INSTALL NEW HYDRANT ASSEMBLY,

SEE DETAIL 1/8

STA 8+67 NEW HYDRANT:

INSTALL NEW HYDRANT ASSEMBLY,

SEE DETAIL 1/8

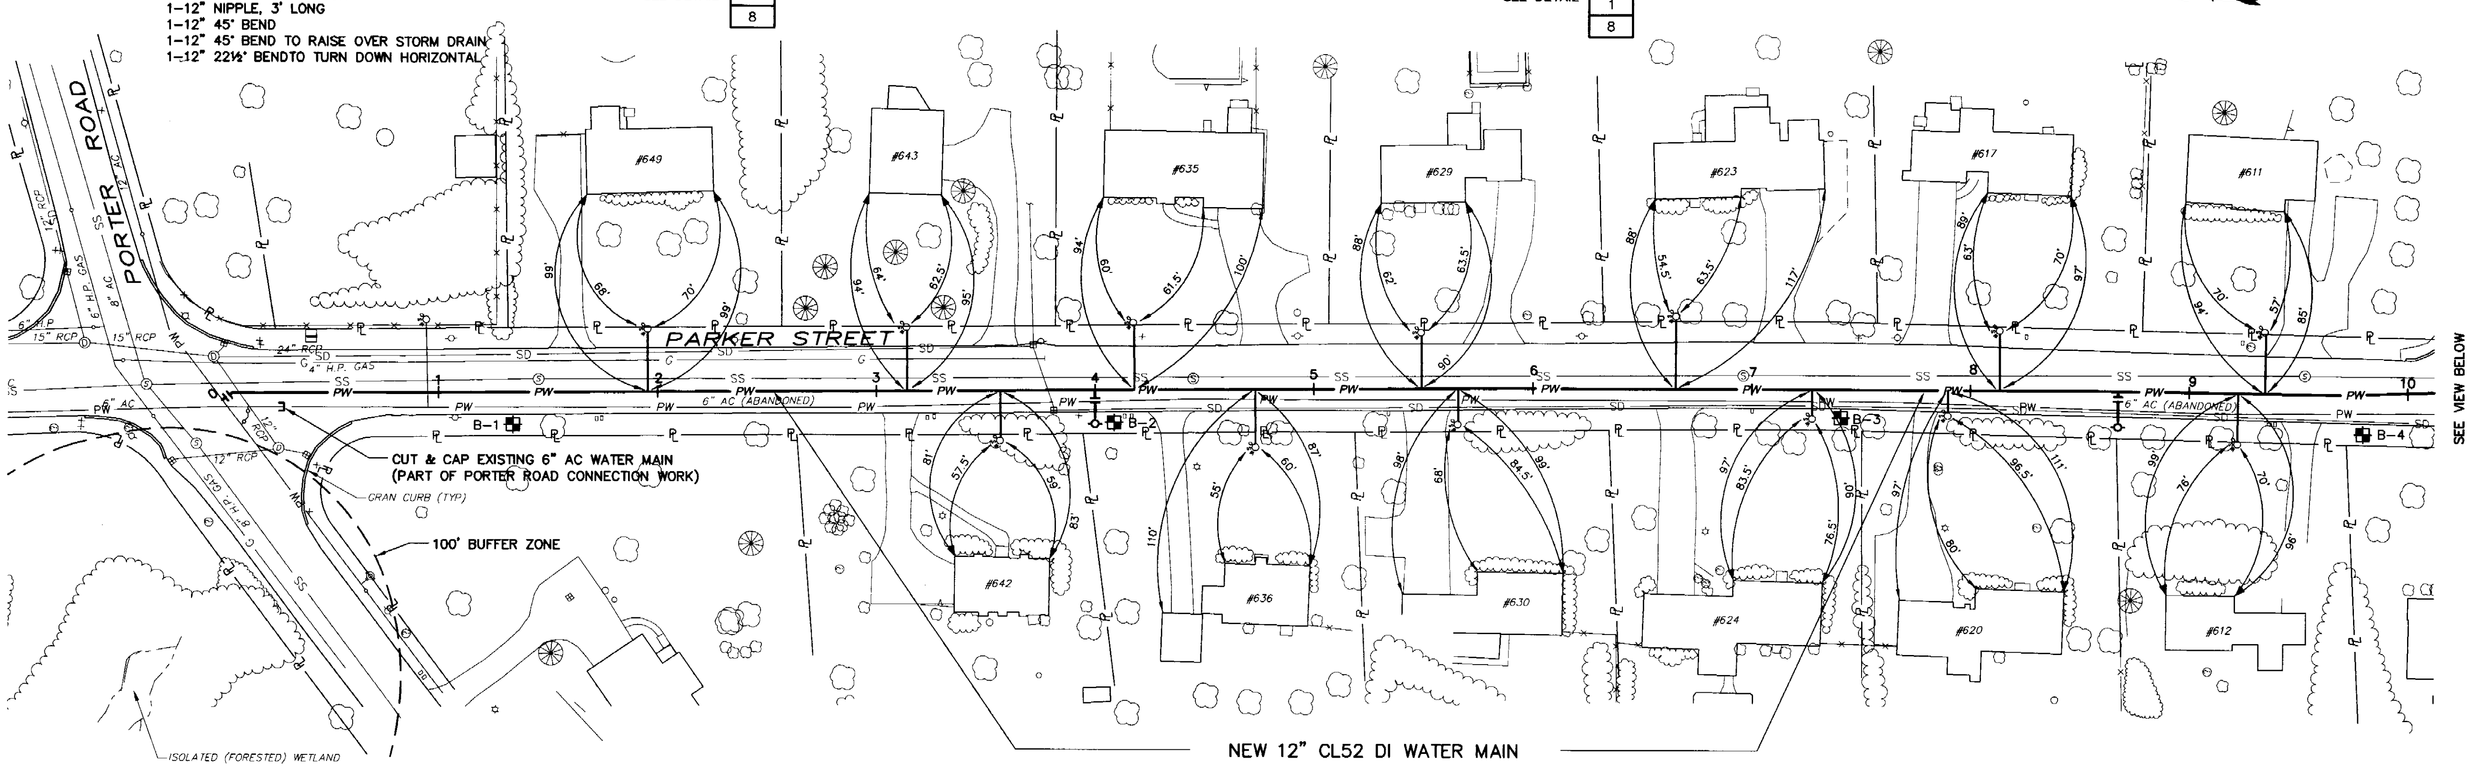

STA 10+35 MEADOWBROOK SCHOOL CONNECTION:

2-12" BUTTERFLY VALVE & BOX
1-8" GATE VALVE & BOX

SEE DETAIL 2/8

STA 10+97 NEW HYDRANT:

INSTALL NEW HYDRANT ASSEMBLY,

SEE DETAIL 1/8

STA 15+00 NEW HYDRANT:

INSTALL NEW HYDRANT ASSEMBLY,

SEE DETAIL 1/8

STA 19+50 NEW HYDRANT:

INSTALL NEW HYDRANT ASSEMBLY,

SEE DETAIL 1/8

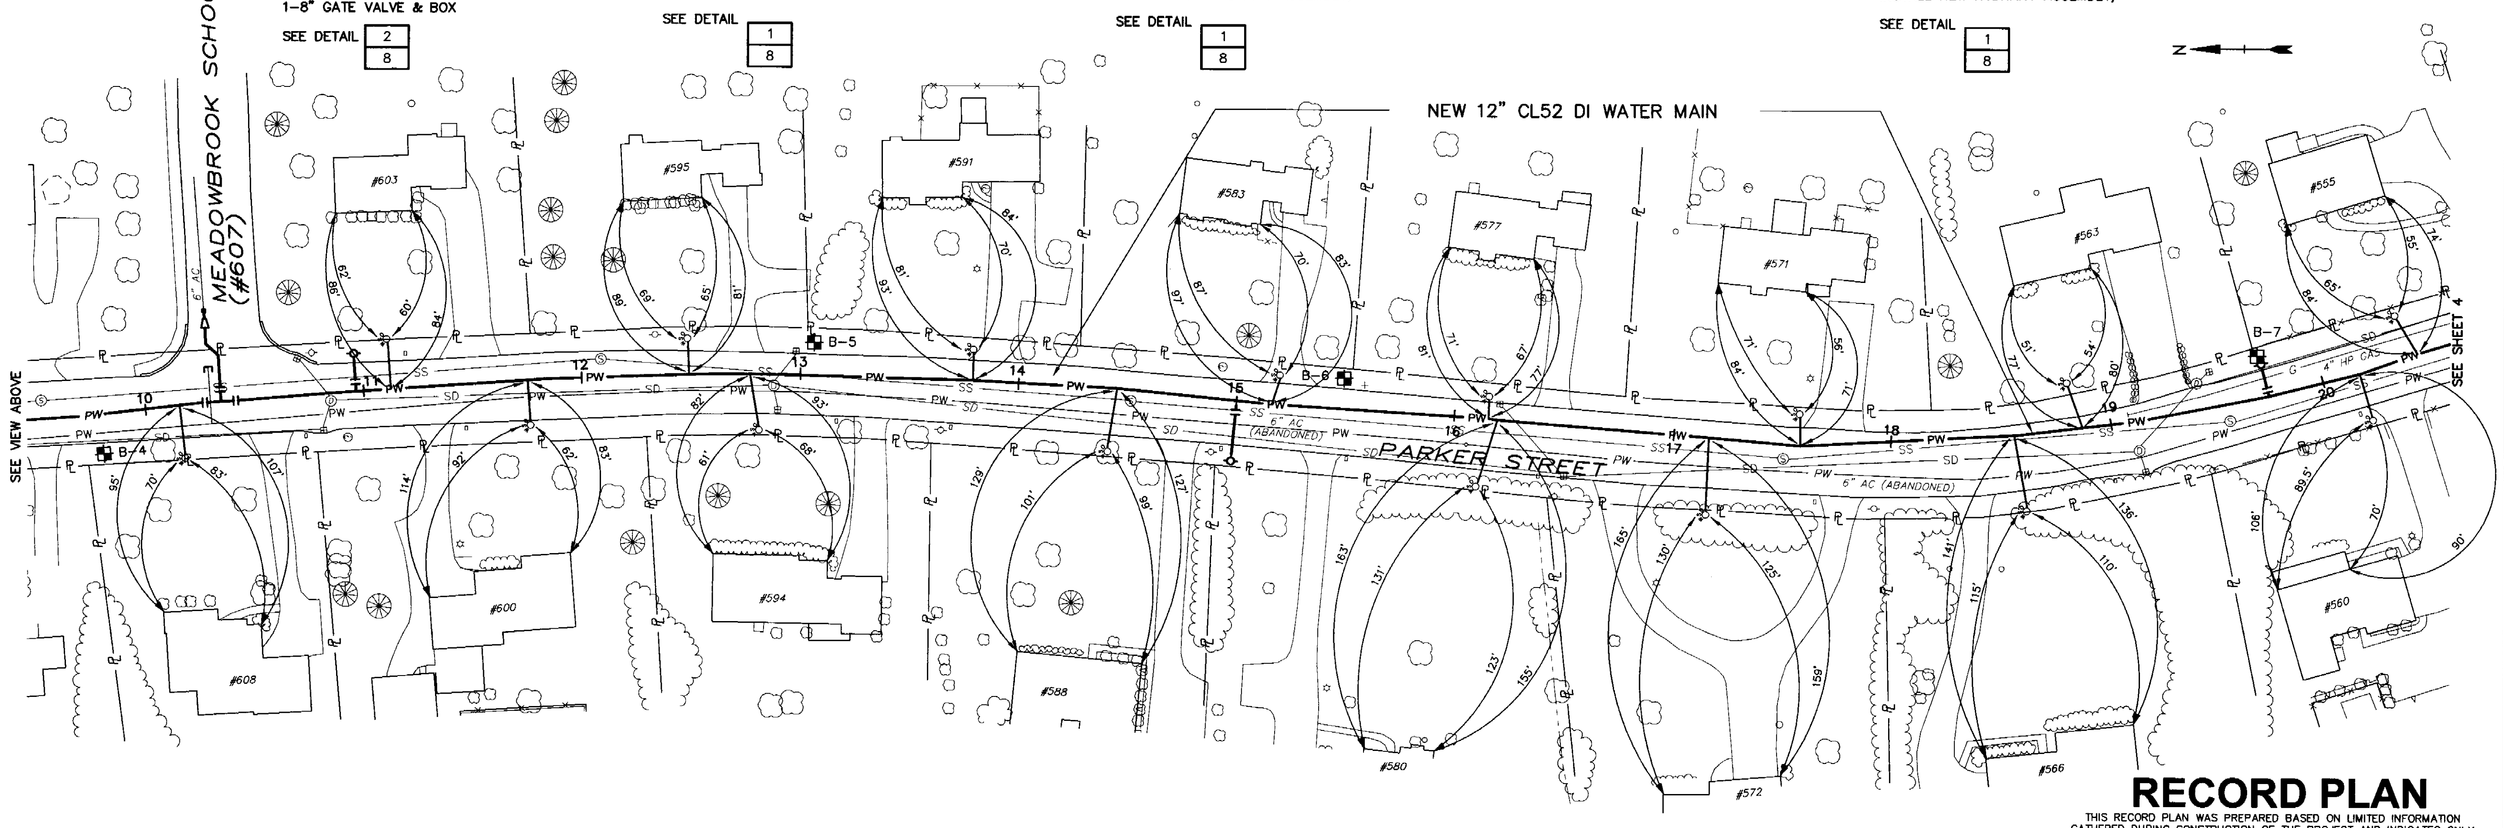

RECORD PLAN

THIS RECORD PLAN WAS PREPARED BASED ON LIMITED INFORMATION GATHERED DURING CONSTRUCTION OF THE PROJECT AND INDICATES ONLY SIGNIFICANT CHANGES MADE FROM THE DESIGN PLANS DURING CONSTRUCTION.

Tighe&Bond
Consulting Engineers
53 Southampton Road
Westfield, Massachusetts
(413) 562-1600
www.tighebond.com

Parker Street Water Main Replacement

Department of Public Works

East Longmeadow, Massachusetts

Mark	Date	Description
B	12/03	RECORD PLAN
A	05/03	FINAL ISSUE

PROJECT NO.	E0451-2-02
FILE:	E0451\PARKERWM\SHT3
DRAWN BY:	CFY
CHECKED:	JT
APPROVED BY:	RP

PARKER STREET
STA 0+00 TO STA 20+00

SCALE: 1" = 40'

SHEET 3 OF 10

12/15/03