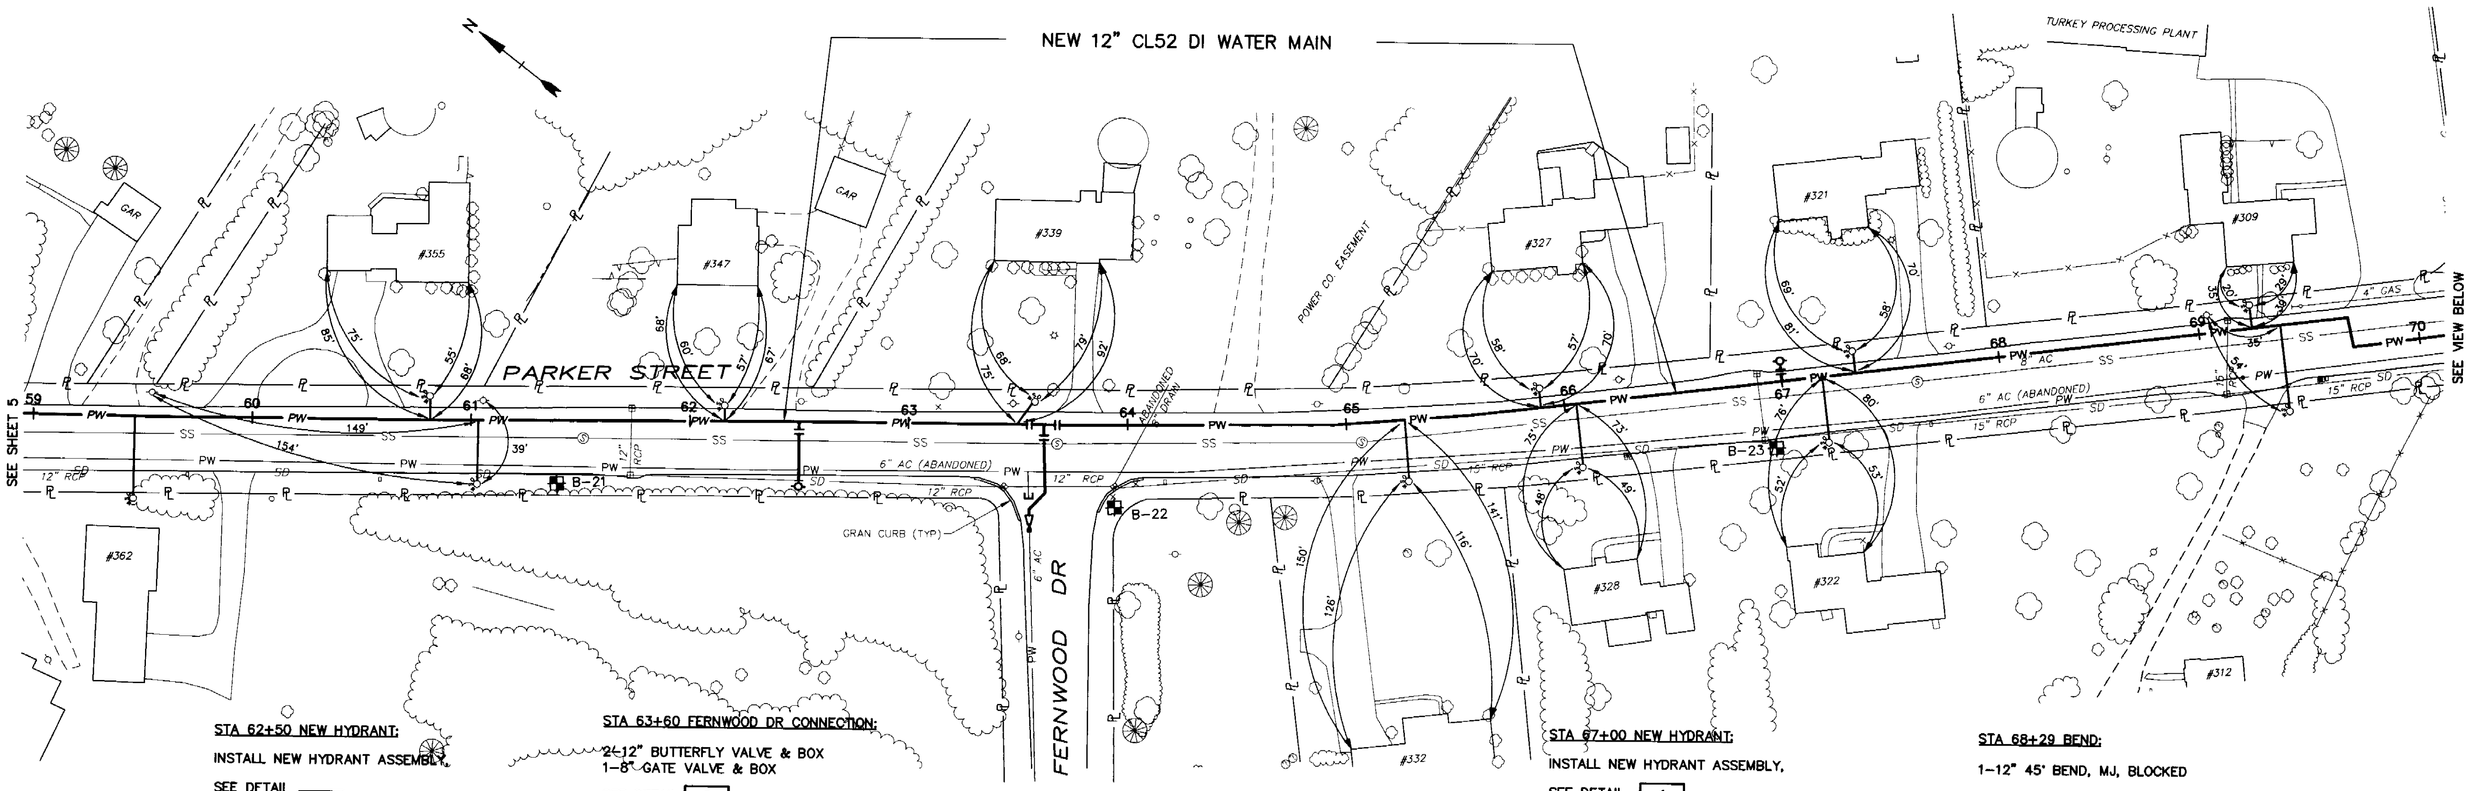

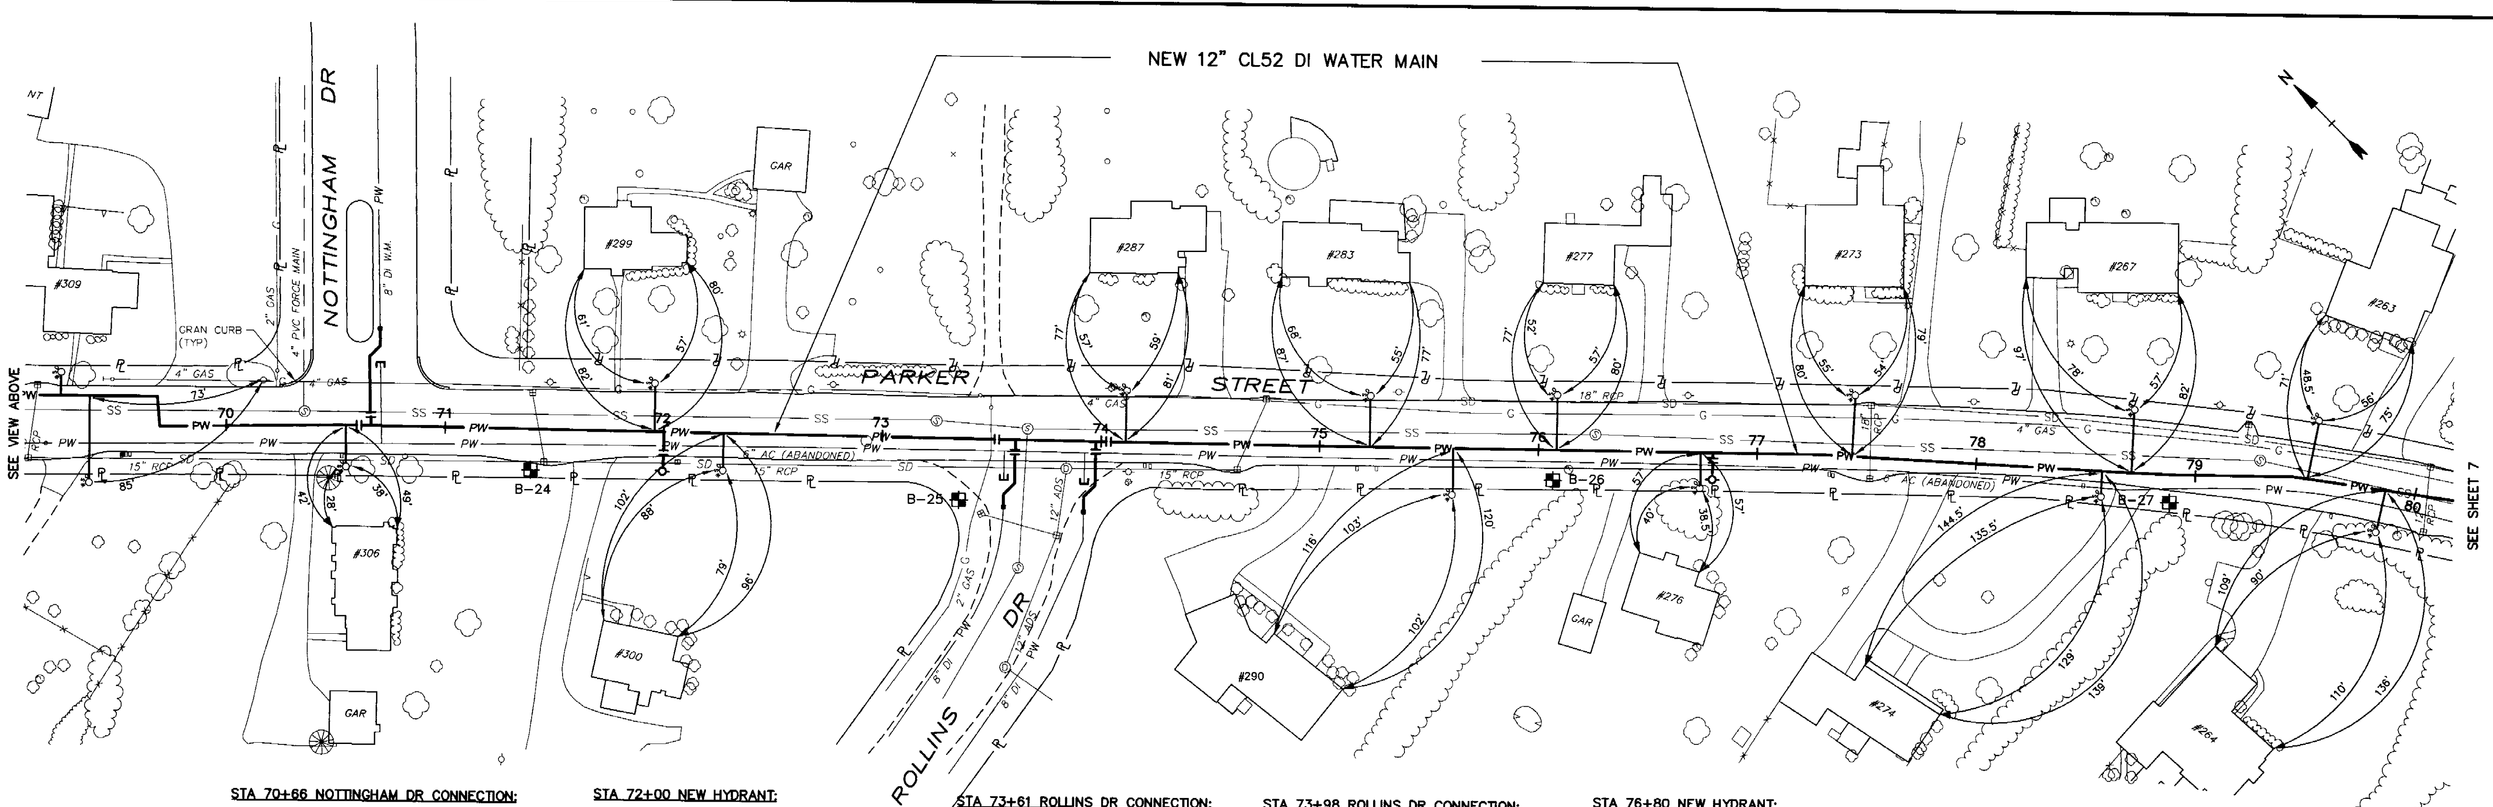

RECORD PLAN

THIS RECORD PLAN WAS PREPARED BASED ON LIMITED INFORMATION GATHERED DURING CONSTRUCTION OF THE PROJECT AND INDICATES ONLY SIGNIFICANT CHANGES MADE FROM THE DESIGN PLANS DURING CONSTRUCTION.

Tighe&Bond
Consulting Engineers
53 Southampton Road
Westfield, Massachusetts
(413) 562-1600
www.tighebond.com

Parker Street Water Main Replacement

Department of Public Works

East Longmeadow, Massachusetts

Mark	Date	Description
B	12/03	RECORD PLAN
A	05/03	FINAL ISSUE

PROJECT NO:	E0451-2-02
FILE:	E0451\PARKERWM\SHT6
DRAWN BY:	DJB
CHECKED:	JT
APPROVED BY:	RP

PARKER STREET
STA 60+00 TO STA 80+00

SCALE: 1" = 40'

SHEET 6 OF 10

12/15/03