


**PLAN**
SCALE: 1"=40'

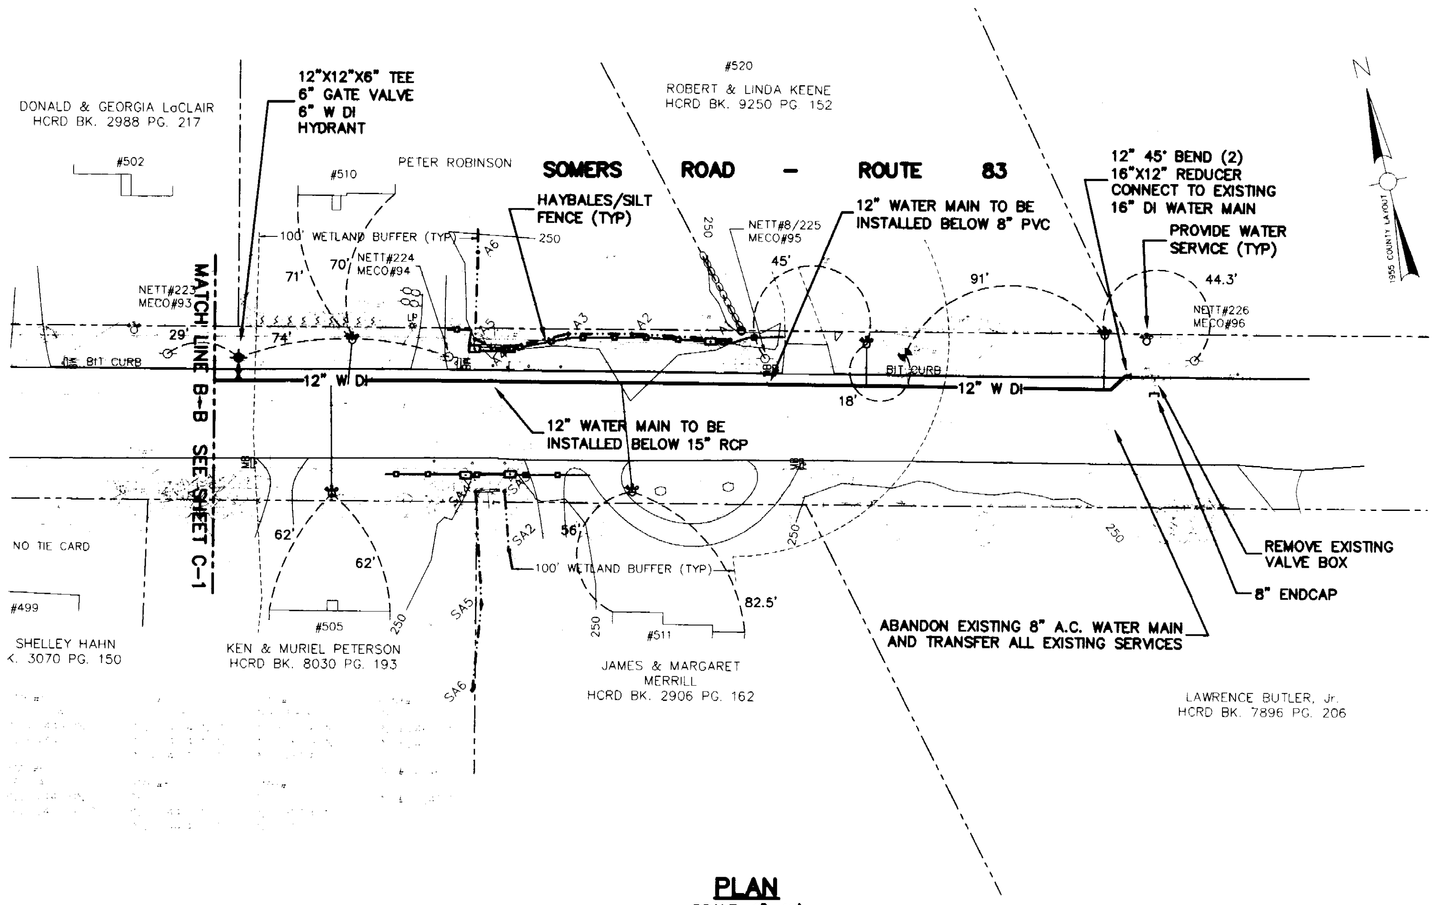


**TYPICAL SECTION THROUGH SOUTH BEND ROAD**
N.T.S.




**TEMPORARY PAVEMENT REPLACEMENT DETAIL**
N.T.S.

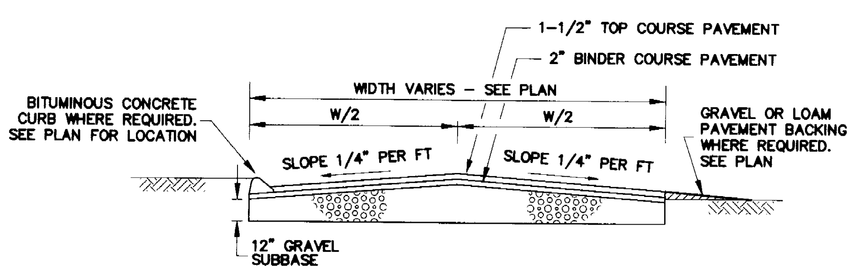


**CURB DETAIL**
CURB IS TYPE-2 PER MASS.
DPW CONSTRUCTION STANDARDS

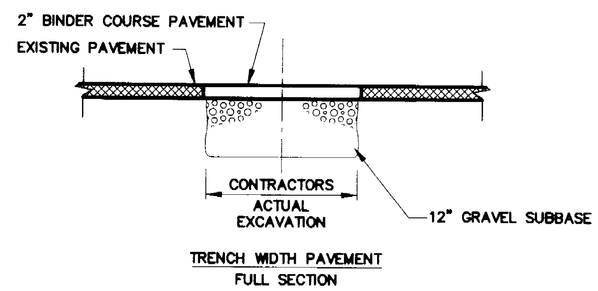


**KEYWAY AND DRIVEWAY APRON DETAIL**
N.T.S.

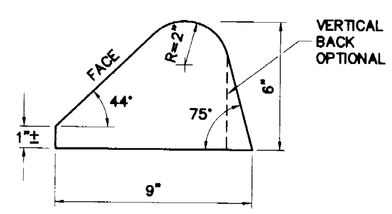


**TRENCH REPAIR FOR SOMERS ROAD**
N.T.S.

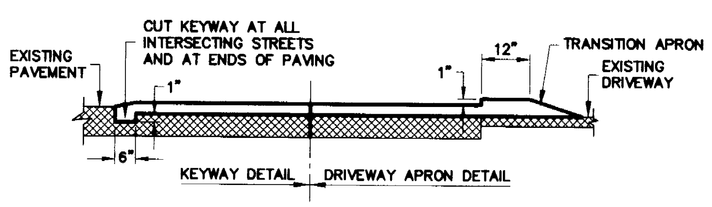


**BITUMINOUS CONCRETE CURB**
N.T.S.

**RECORD DRAWING**

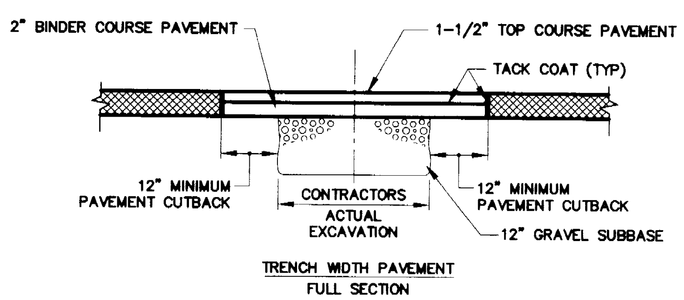Weston & Sampson
ENGINEERS, INC.
Five Centennial Drive, Peabody, MA 01960-7985

| No. | Date | Description |
|---|---|---|
| 1 | 11/01 | RECORD DRAWING |
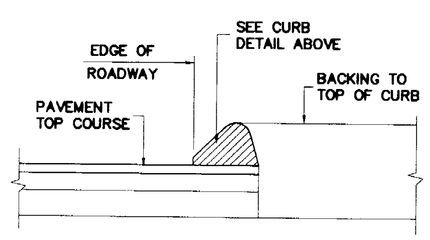
| Dr. By | Ck. By | App. By |
|---|---|---|
| WGS | DRL | PJC |

APPROVED
PATRICK J. CONNELLY
No. 31147
REGISTERED PROFESSIONAL ENGINEER
11/20/01
DATE

TOWN OF EAST LONGMEADOW, MASSACHUSETTS
BOARD OF PUBLIC WORKS
SOMERS ROAD HIGH SERVICE WATER MAIN REPLACEMENT
SOMERS ROAD - STATION 7+65 TO 11+47
DETAILS

| DR. BY | DSN. BY | CHK. BY | APP. BY |
|---|---|---|---|
| WGS | WGS | DRL | PJC |

| CADD NO. | CONTRACT: | JOB NO. | SCALE: |
|---|---|---|---|
| RC-2 | | 200096 | 1"=40' |

FILE NO.

C-2

SHEET 4 OF 5