W-24

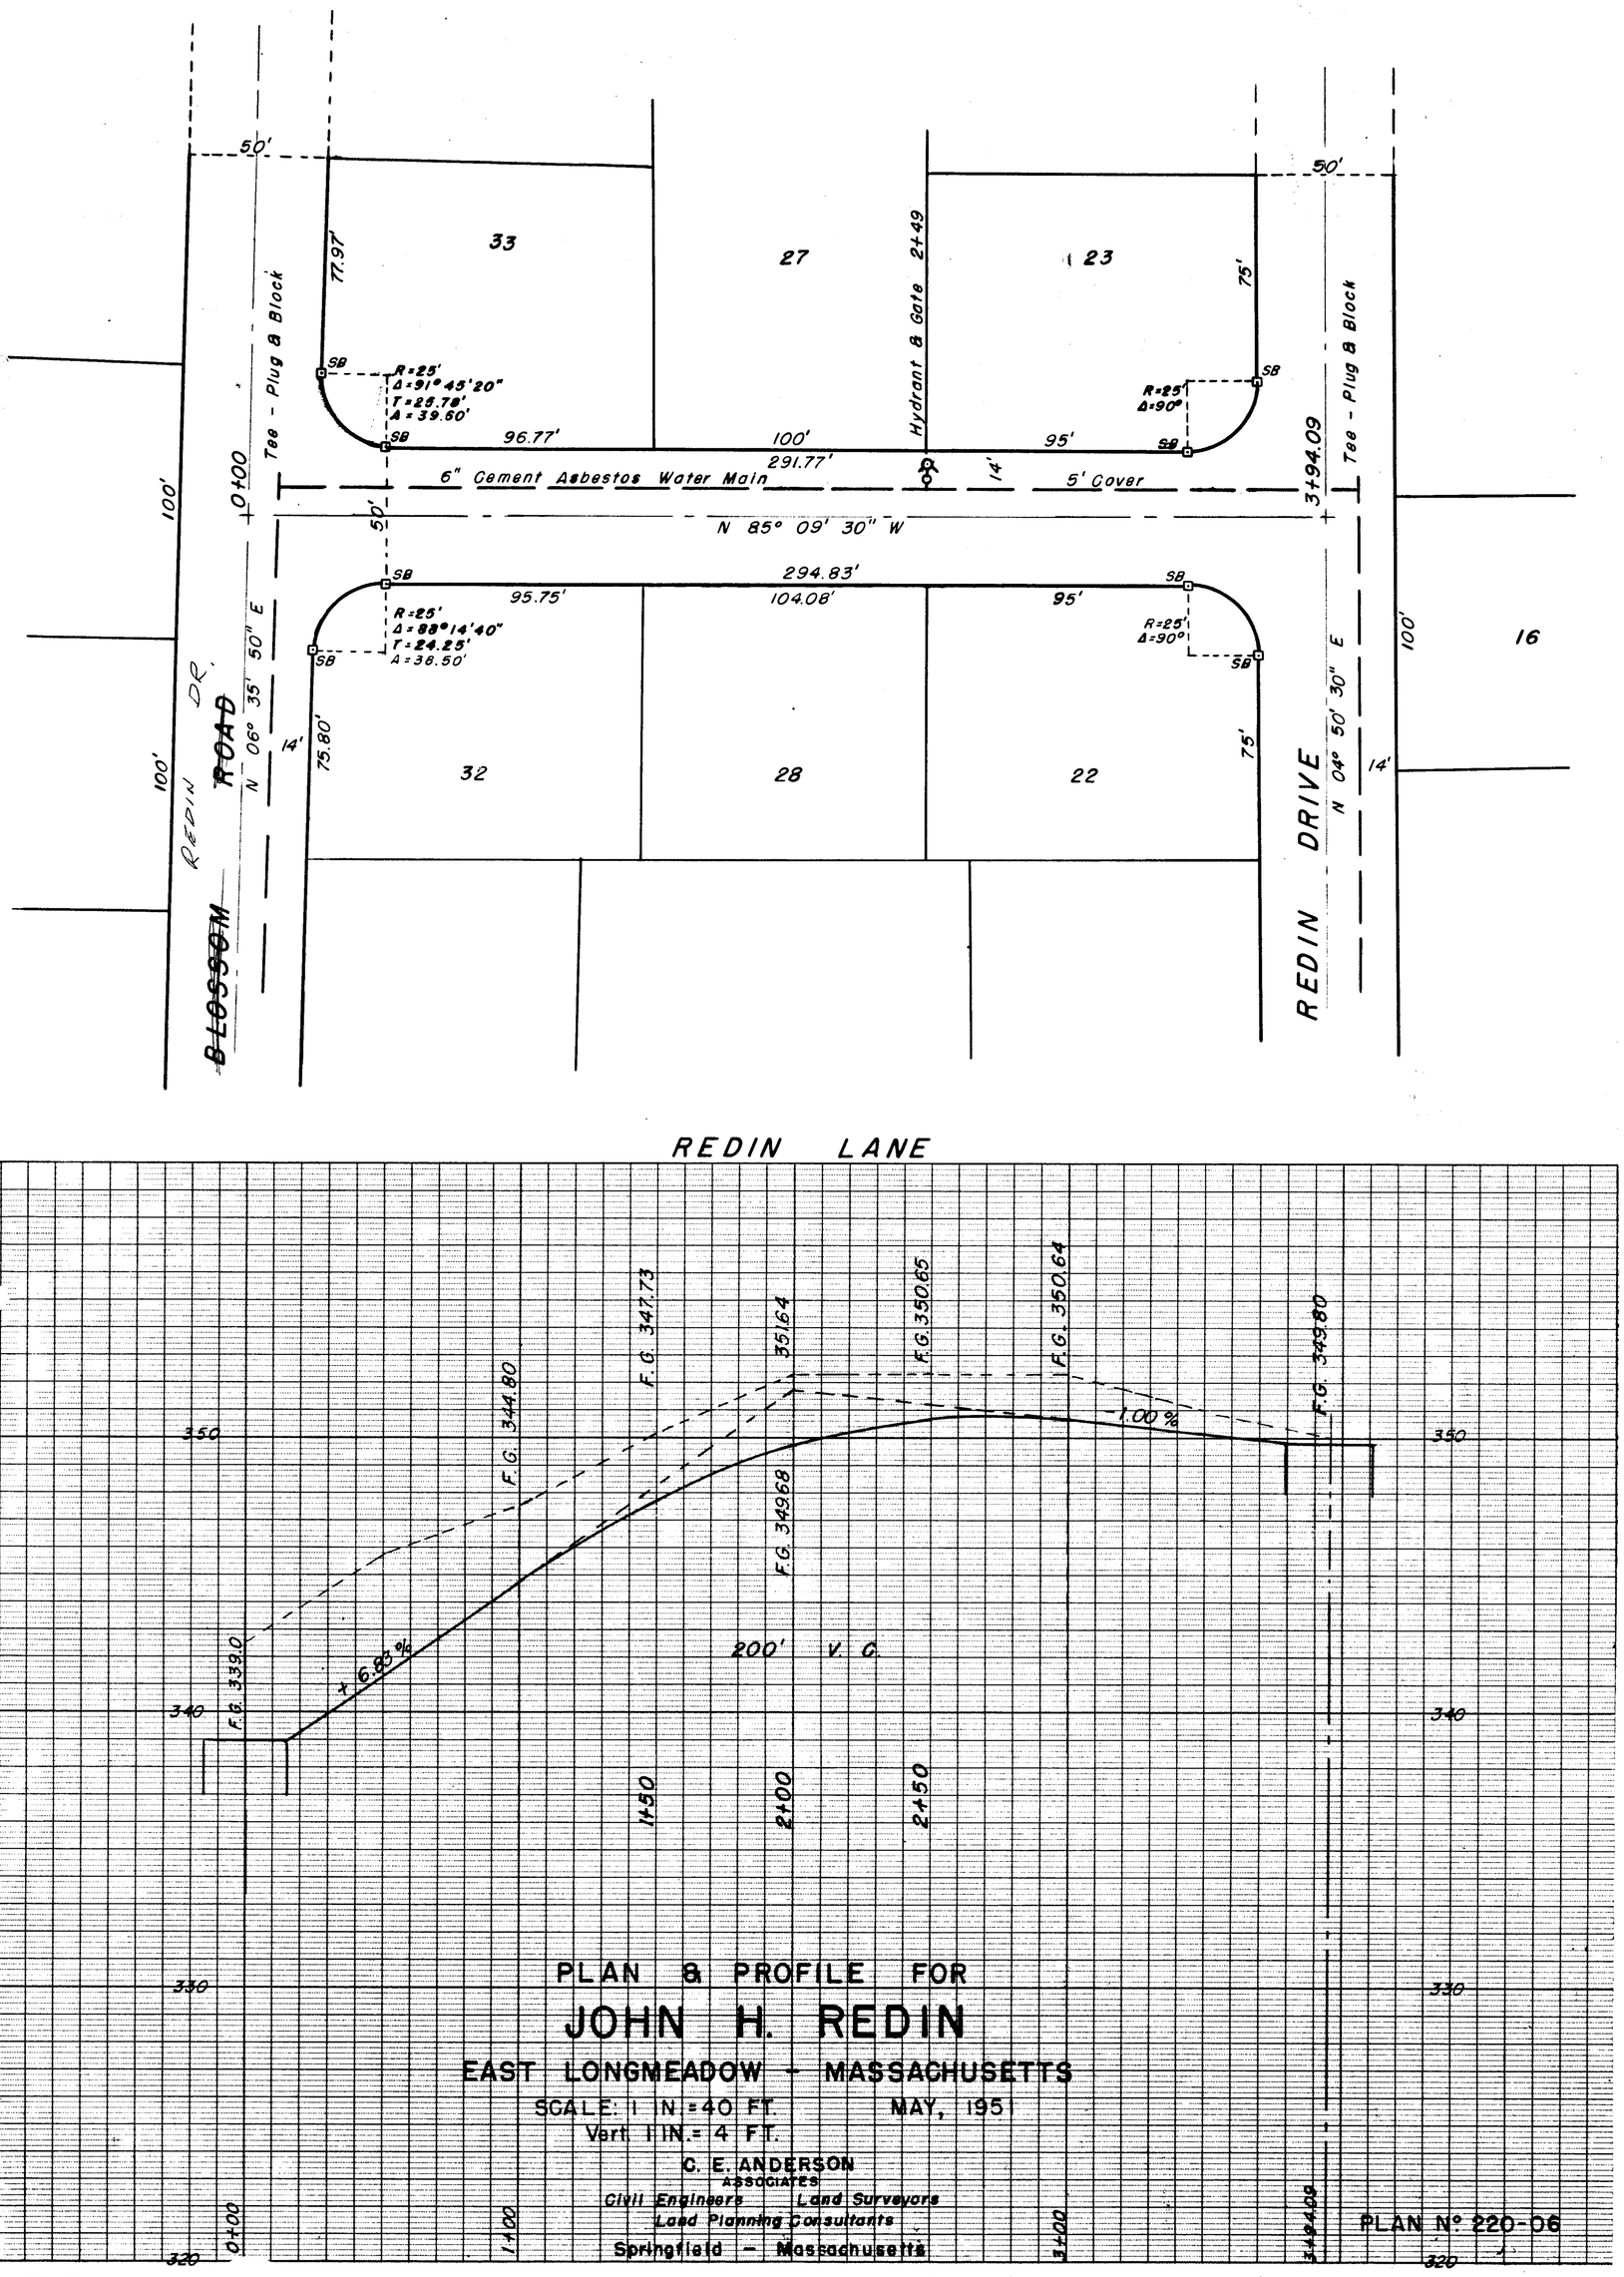

PLAN & PROFILE FOR

JOHN H. REDIN

EAST LONGMEADOW - MASSACHUSETTS

SCALE: 1 IN. = 40 FT. MAY, 1951

Vert. 1 IN. = 4 FT.

C. E. ANDERSON
ASSOCIATES
Civil Engineers Land Surveyors
Land Planning Consultants
Springfield - Massachusetts

PLAN No. 220-06

"PERFECT" PROFILE PLATE A
EUGENE DIETZGEN CO.
PRINTED IN U
ON CLOTH MADE