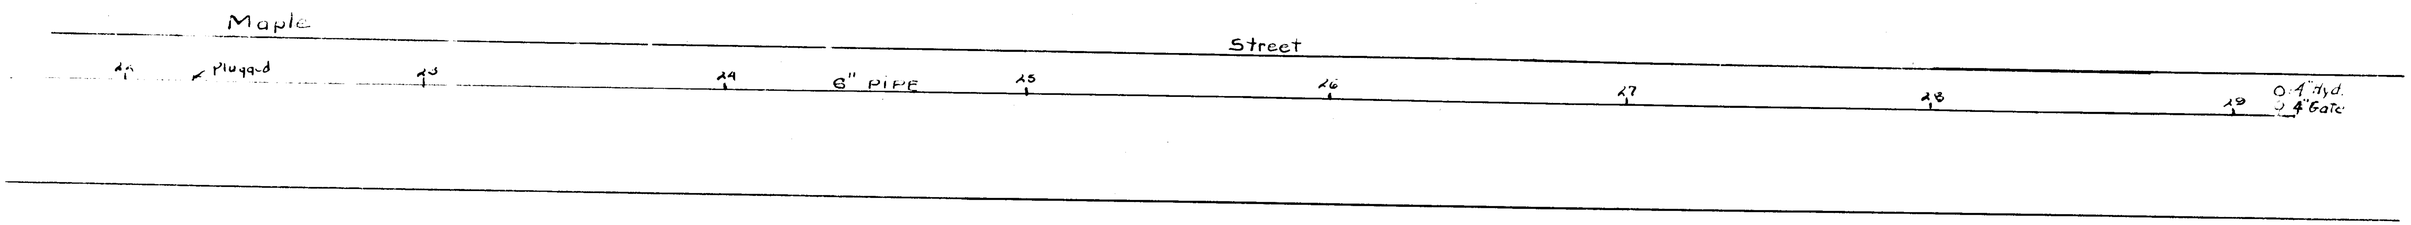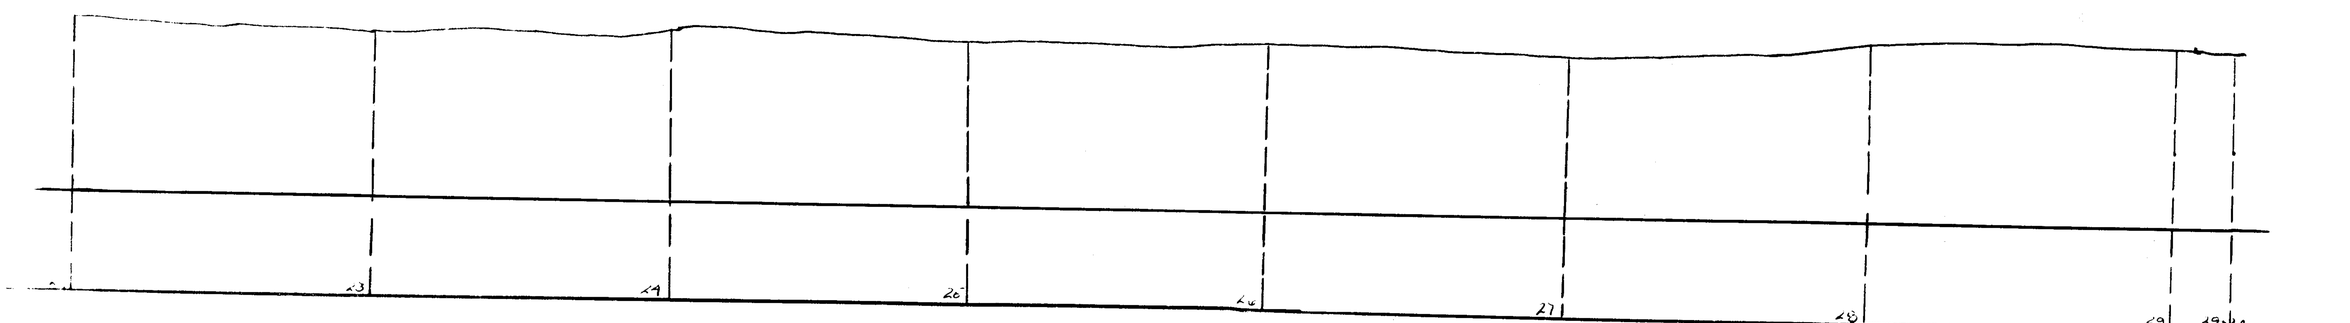
Maple
Street
Plugged
6" PIPE
0.4" Hyd.
4" Gate