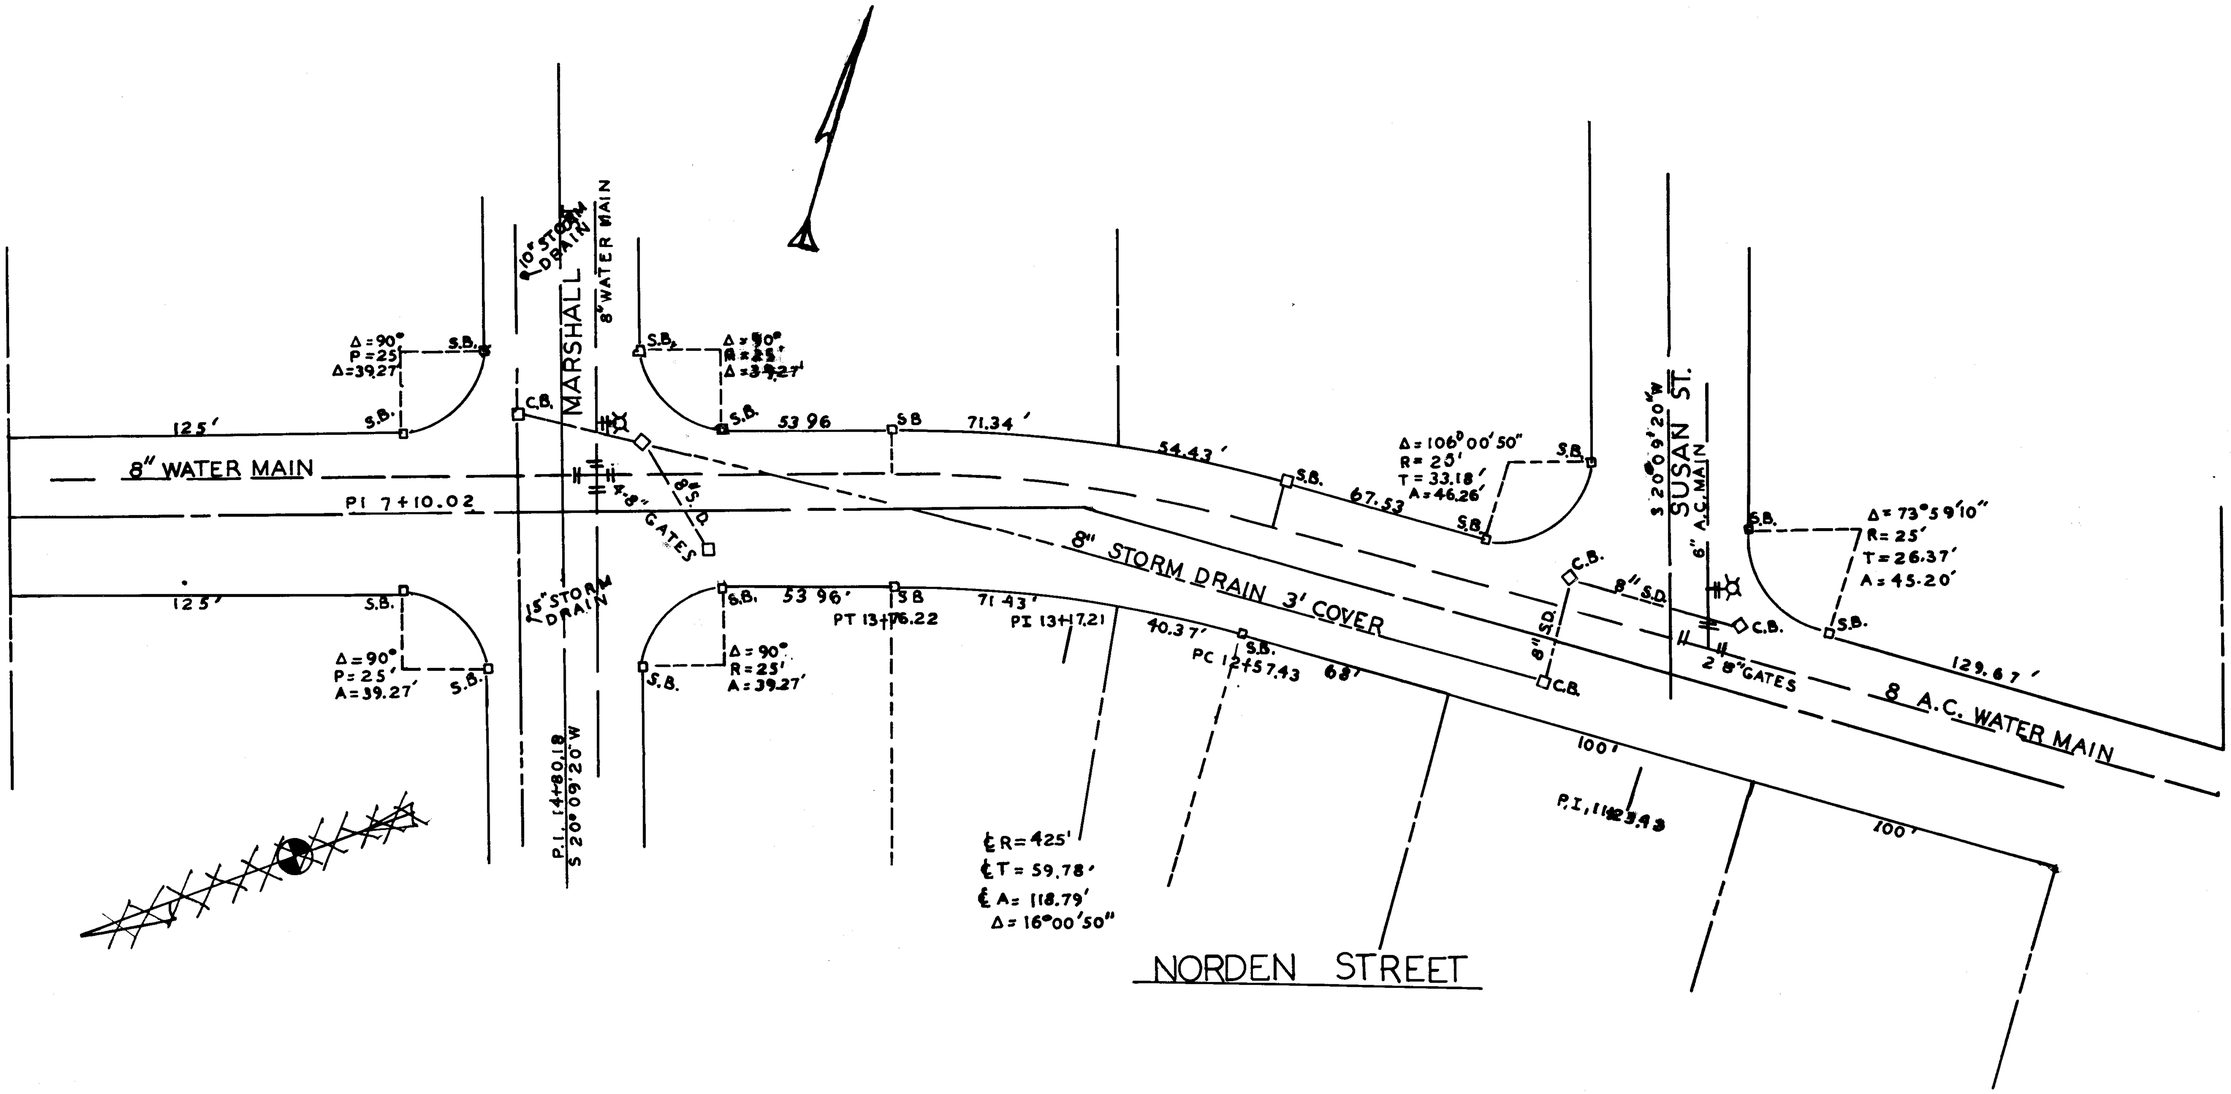

WATER PLAN
OF
NORDEN STREET
D.P.W. TOWN OF E.LONG.
SCALE 1" = 40'

A.A. MELIEN ENG.

W-200 B