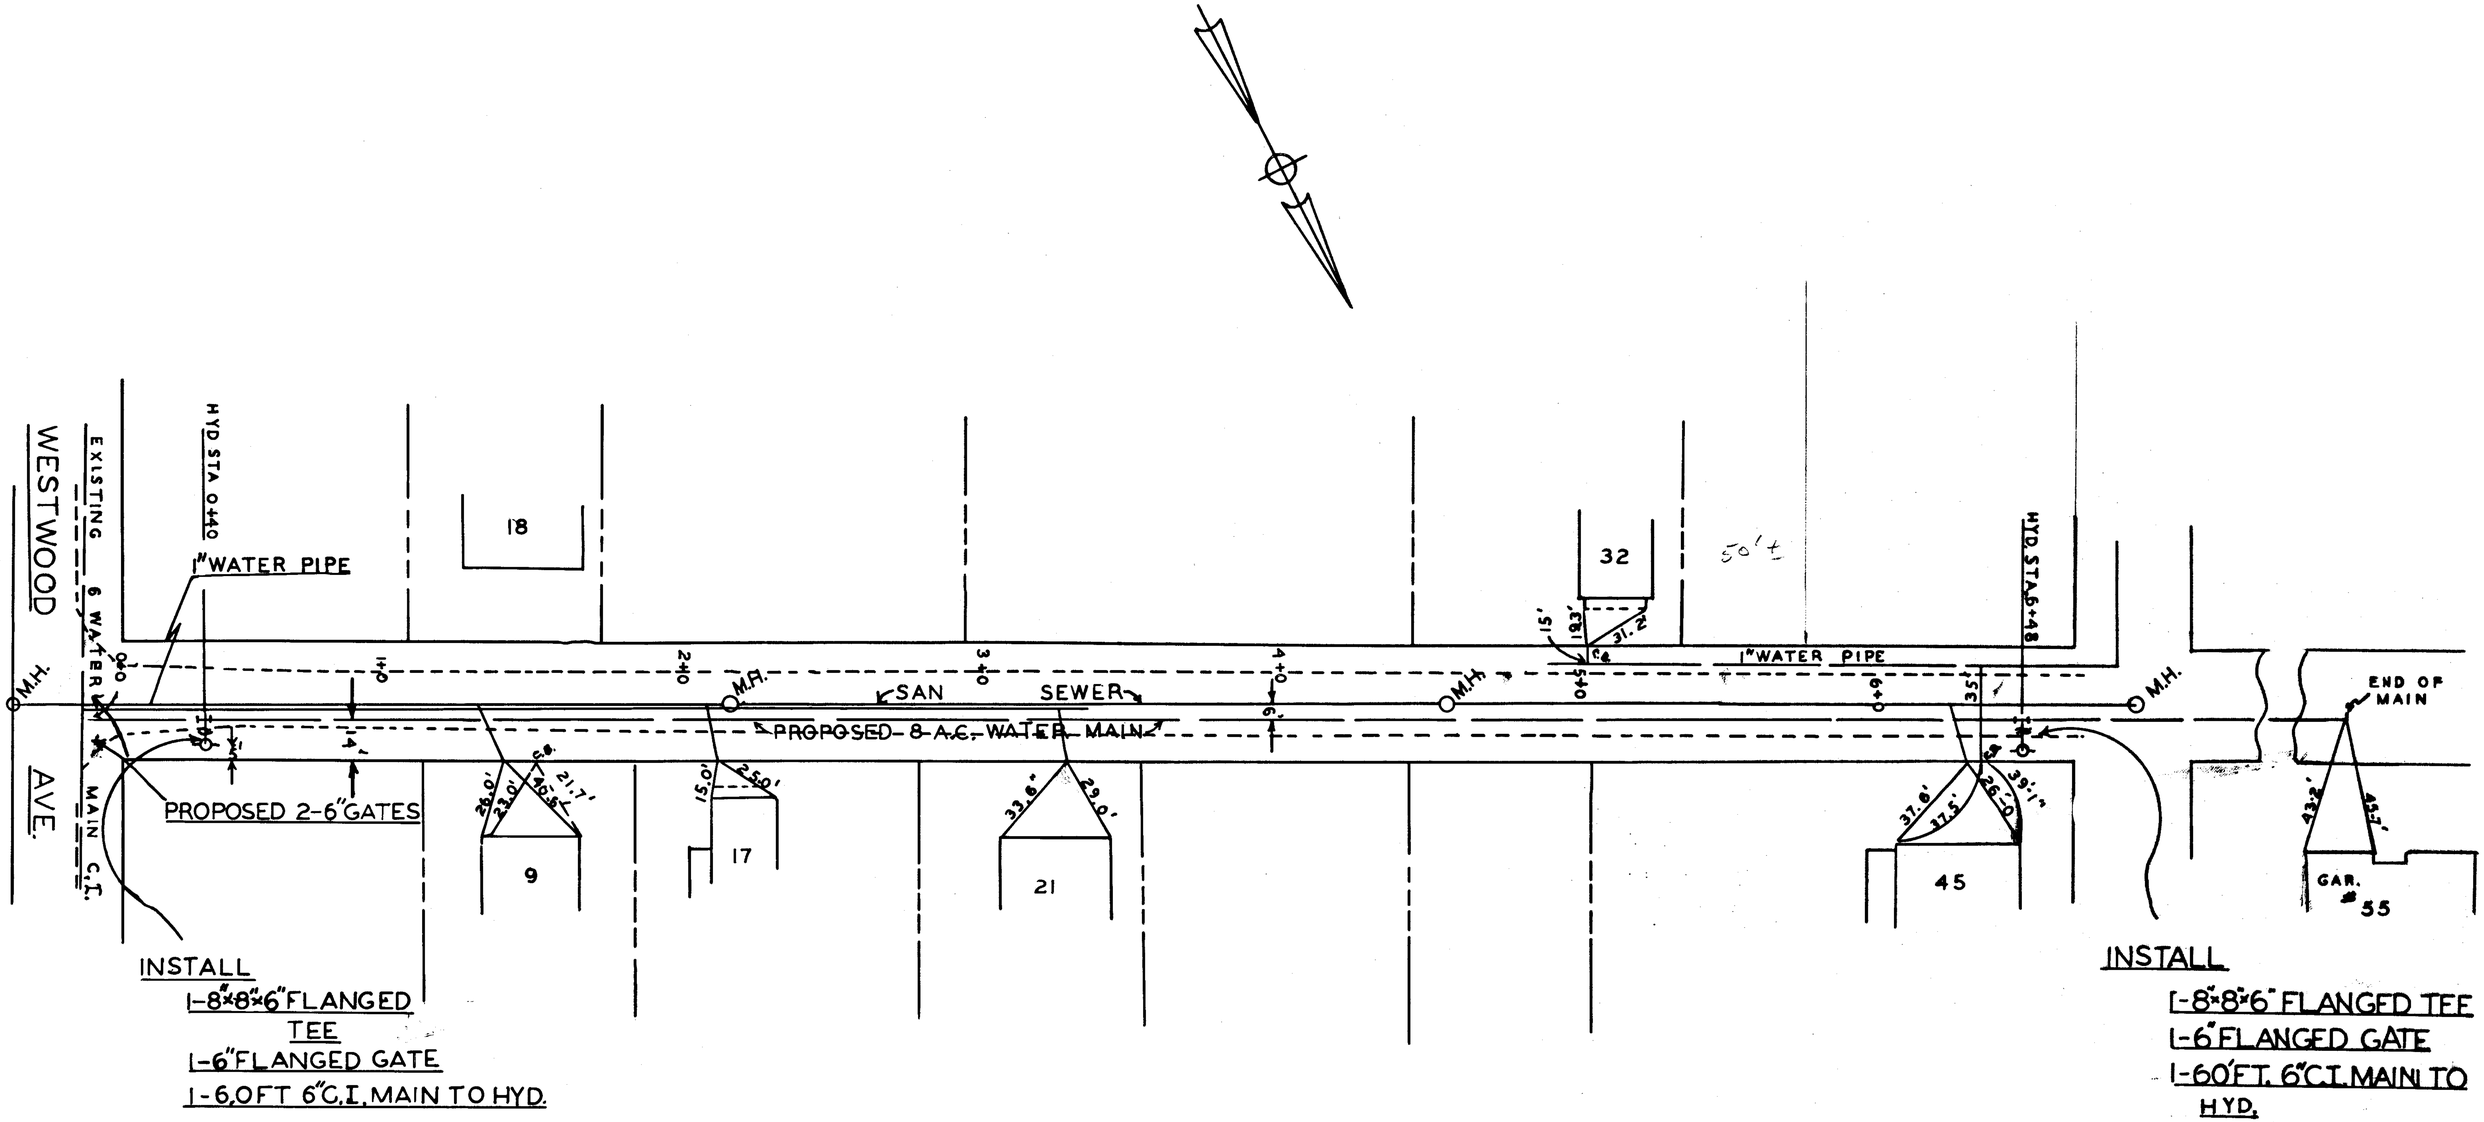

MARCH 1960

PLAN SHOWING PROPOSED

8" A.C. WATER MAIN

HIGHLANDVIEW AVE.

TOWN OF EAST LONGMEADOW

SCALE : 1" = 40' ENG. A.A. MELIEN

W 208