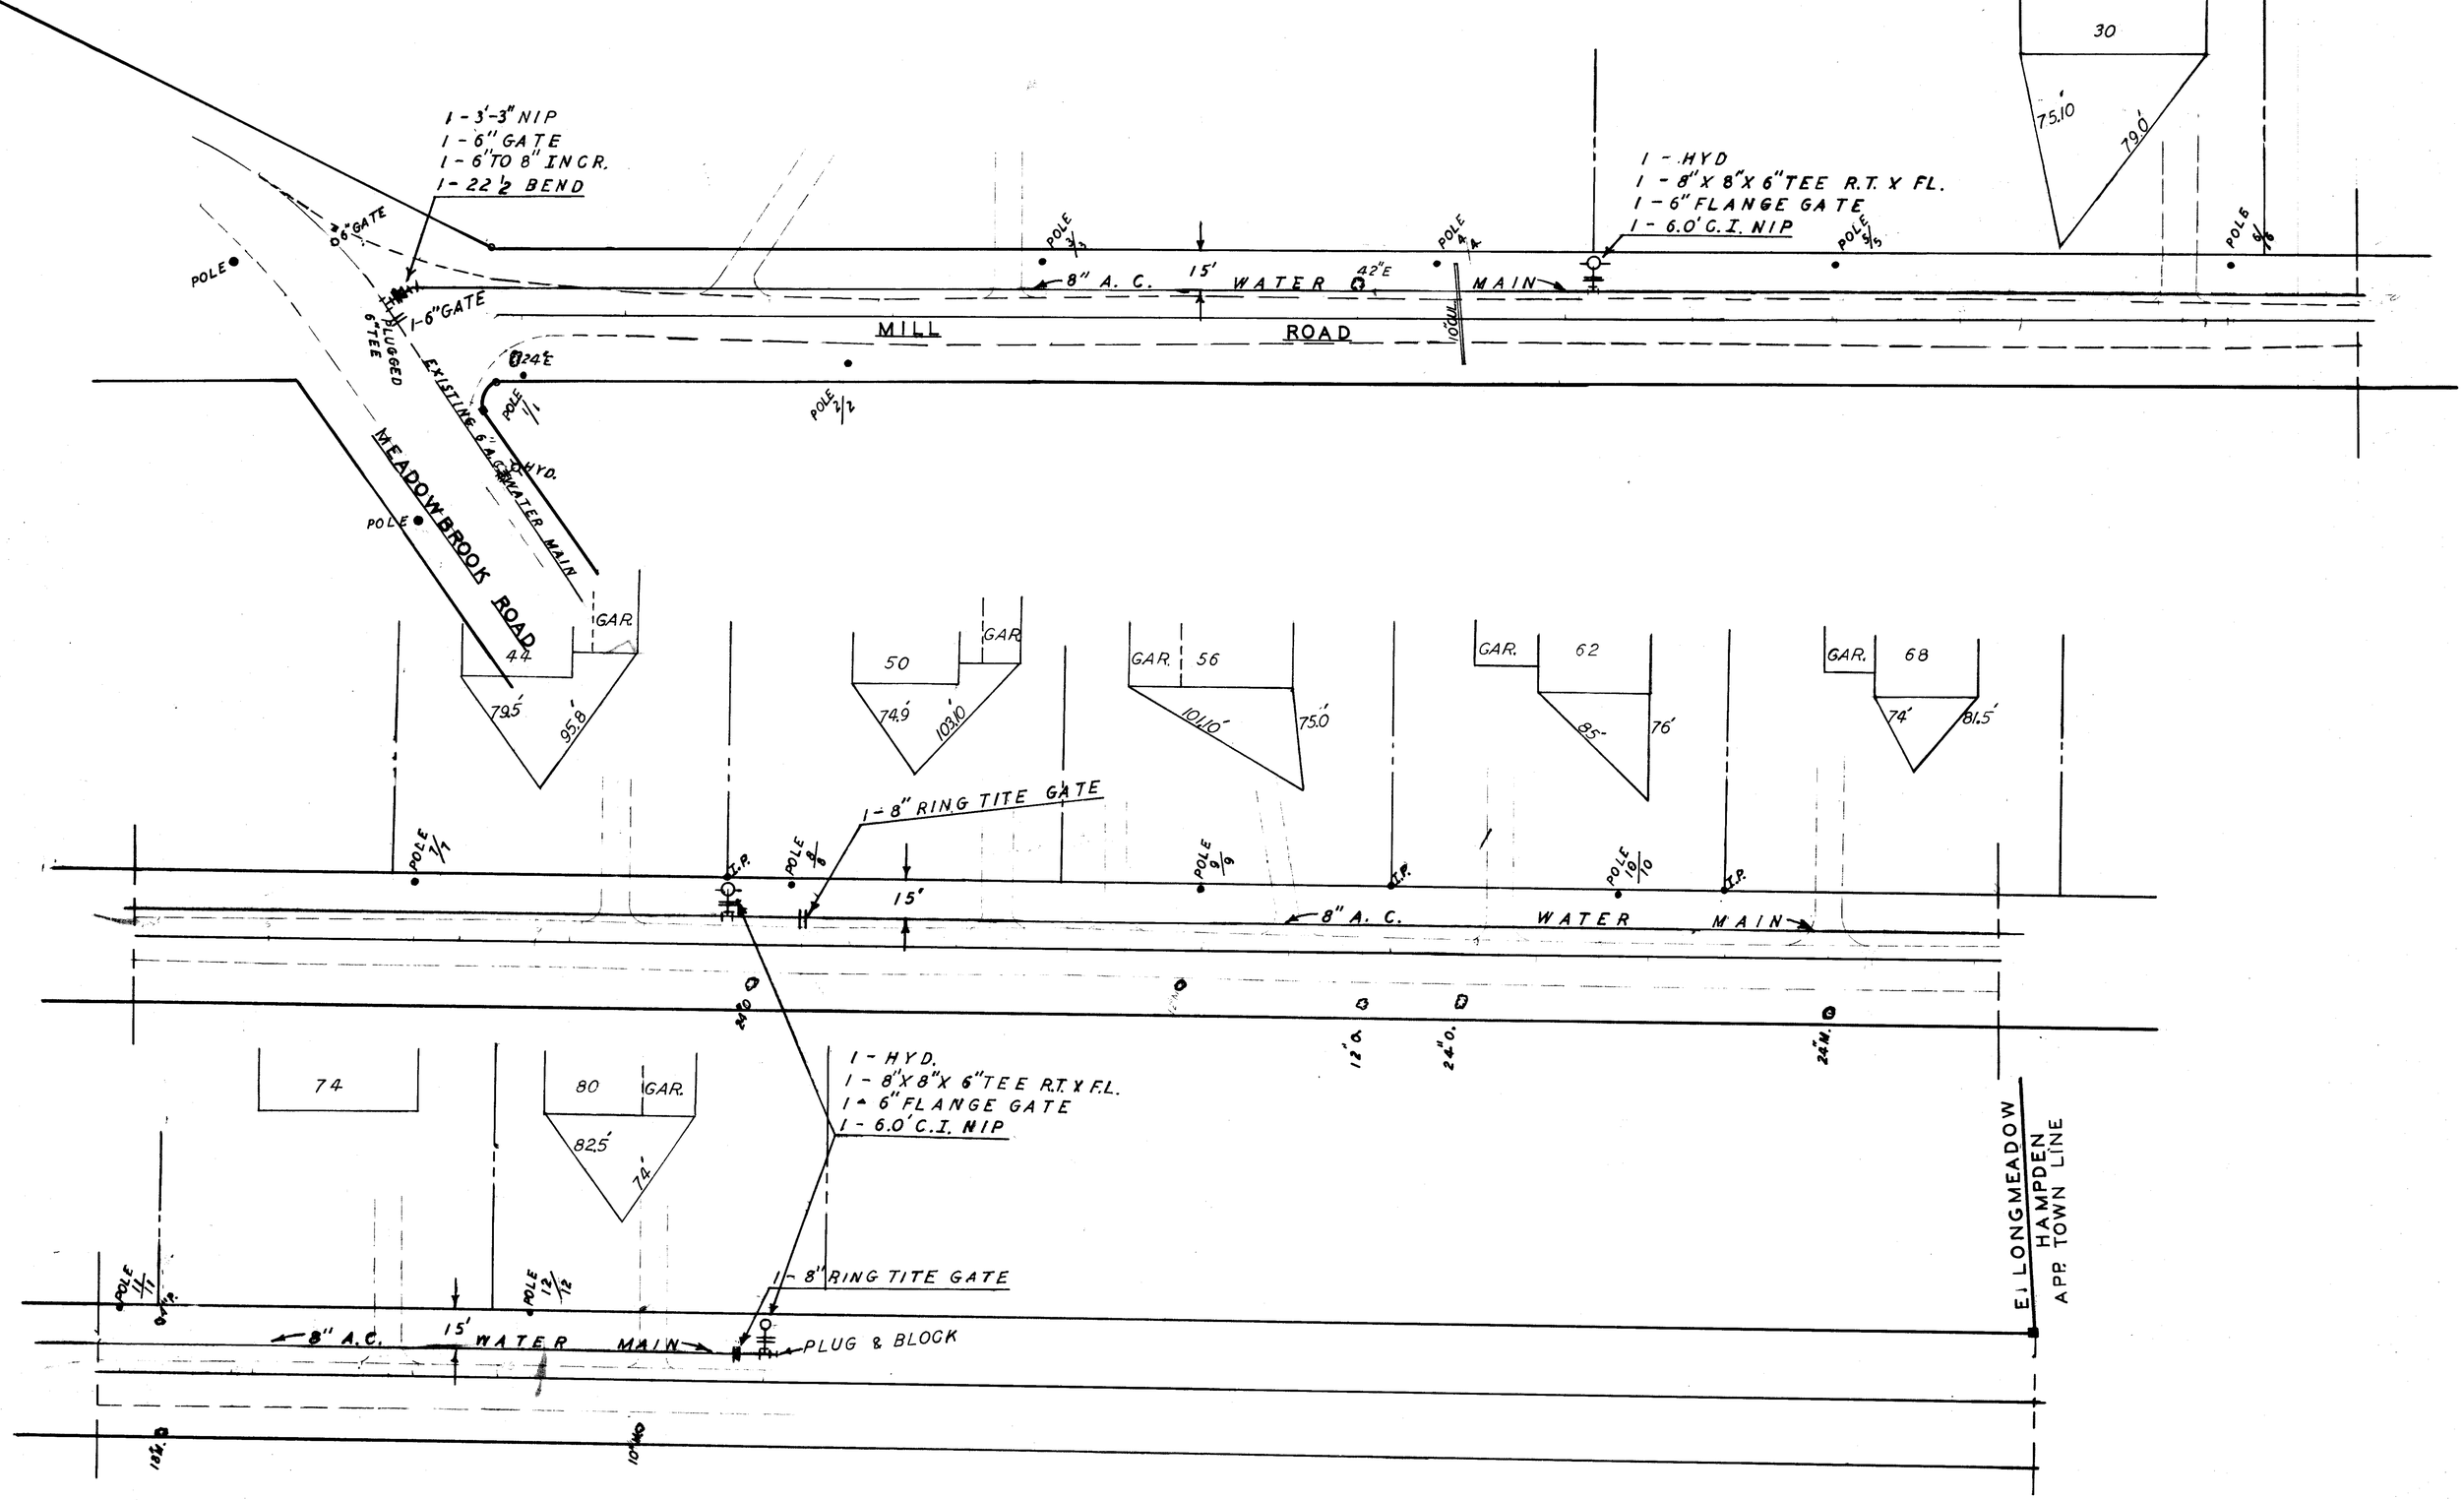

PLAN SHOWING
8" WATER MAIN ON
MILL ROAD
TOWN OF EAST LONGMEADOW

DATE - 1964 - - NOVEMBER

SCALE = 1" VERT = 40 A.A.MELIEN ENG