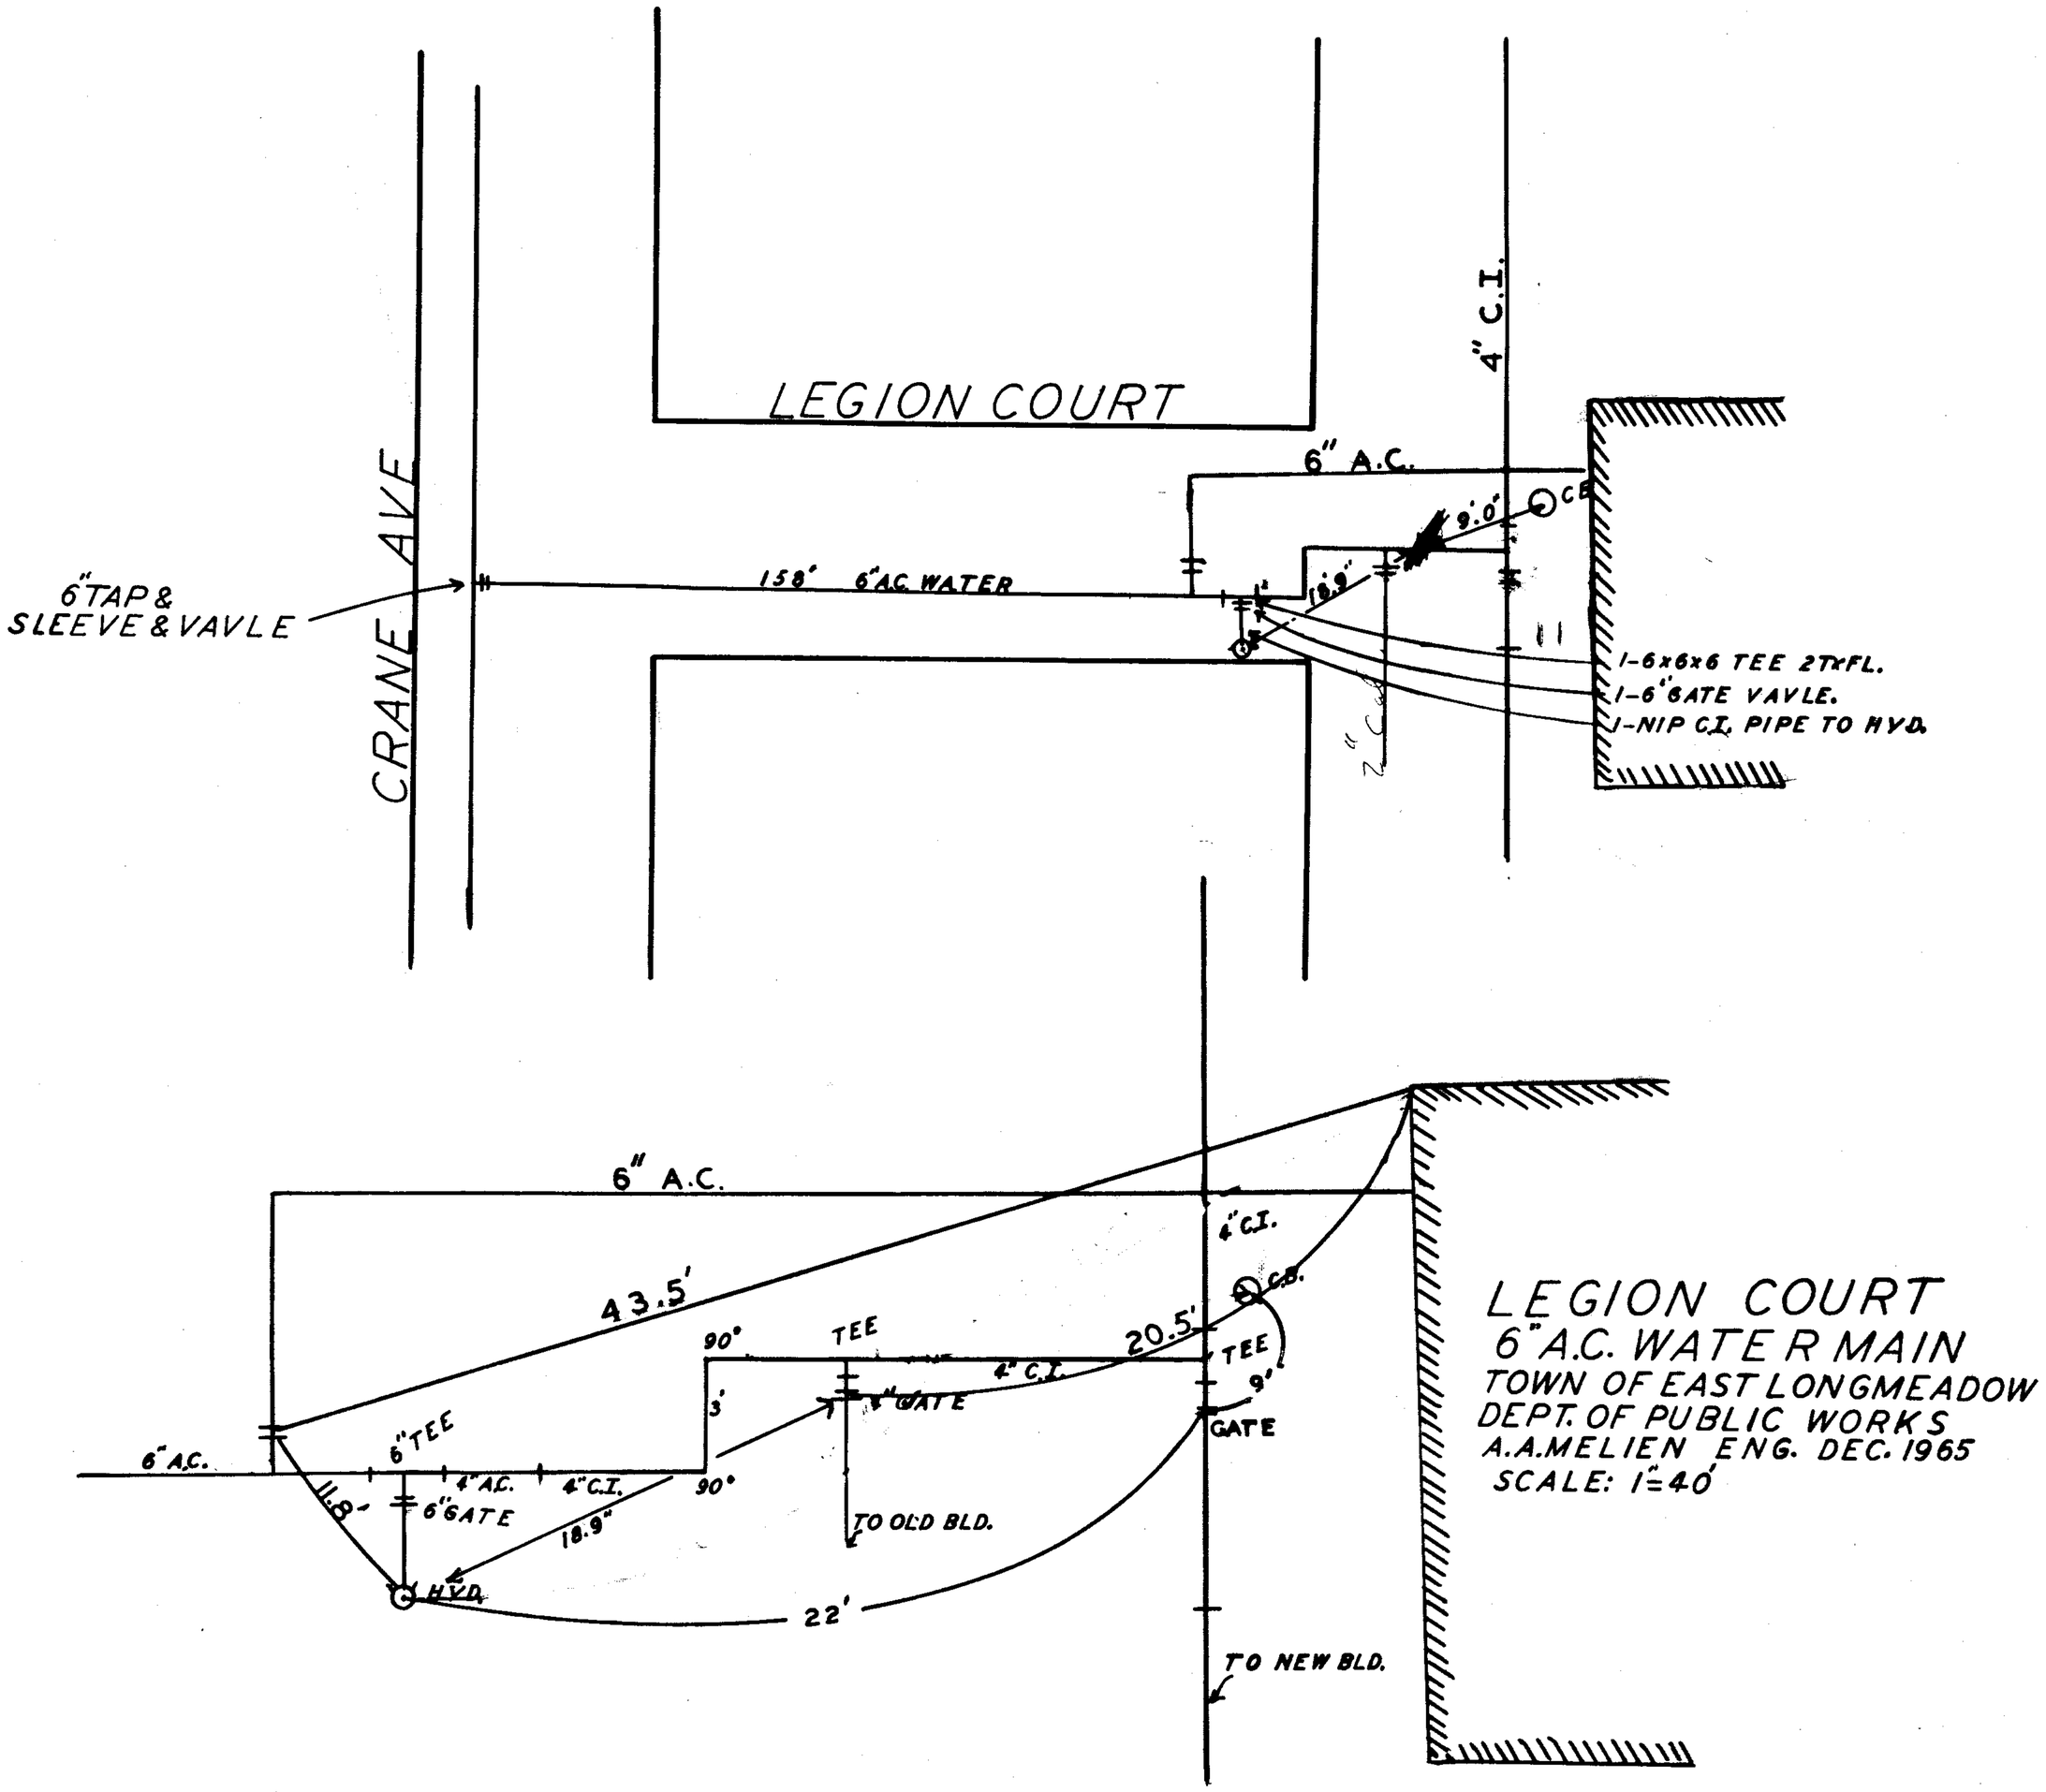
LEGION COURT
CRANE AVE
6" TAP & SLEEVE & VAVLE
158' 6" A.C. WATER
6" A.C.
4" C.I.
9'-0"
CB
19.9'
1-6x6x6 TEE 2TxFL.
1-6" GATE VAVLE.
1-NIP C.I. PIPE TO HYD.
6" A.C.
43.5'
90°
TEE
20.5'
4" C.I.
4" GATE
3'
TEE
9'
GATE
6" A.C.
6" TEE
4" A.C.
4" C.I.
90°
11.8'
6" GATE
18.9'
TO OLD BLD.
HYD.
22'
TO NEW BLD.
LEGION COURT
6" A.C. WATER MAIN
TOWN OF EAST LONGMEADOW
DEPT. OF PUBLIC WORKS
A.A. MELIEN ENG. DEC. 1965
SCALE: 1" = 40'

W-261