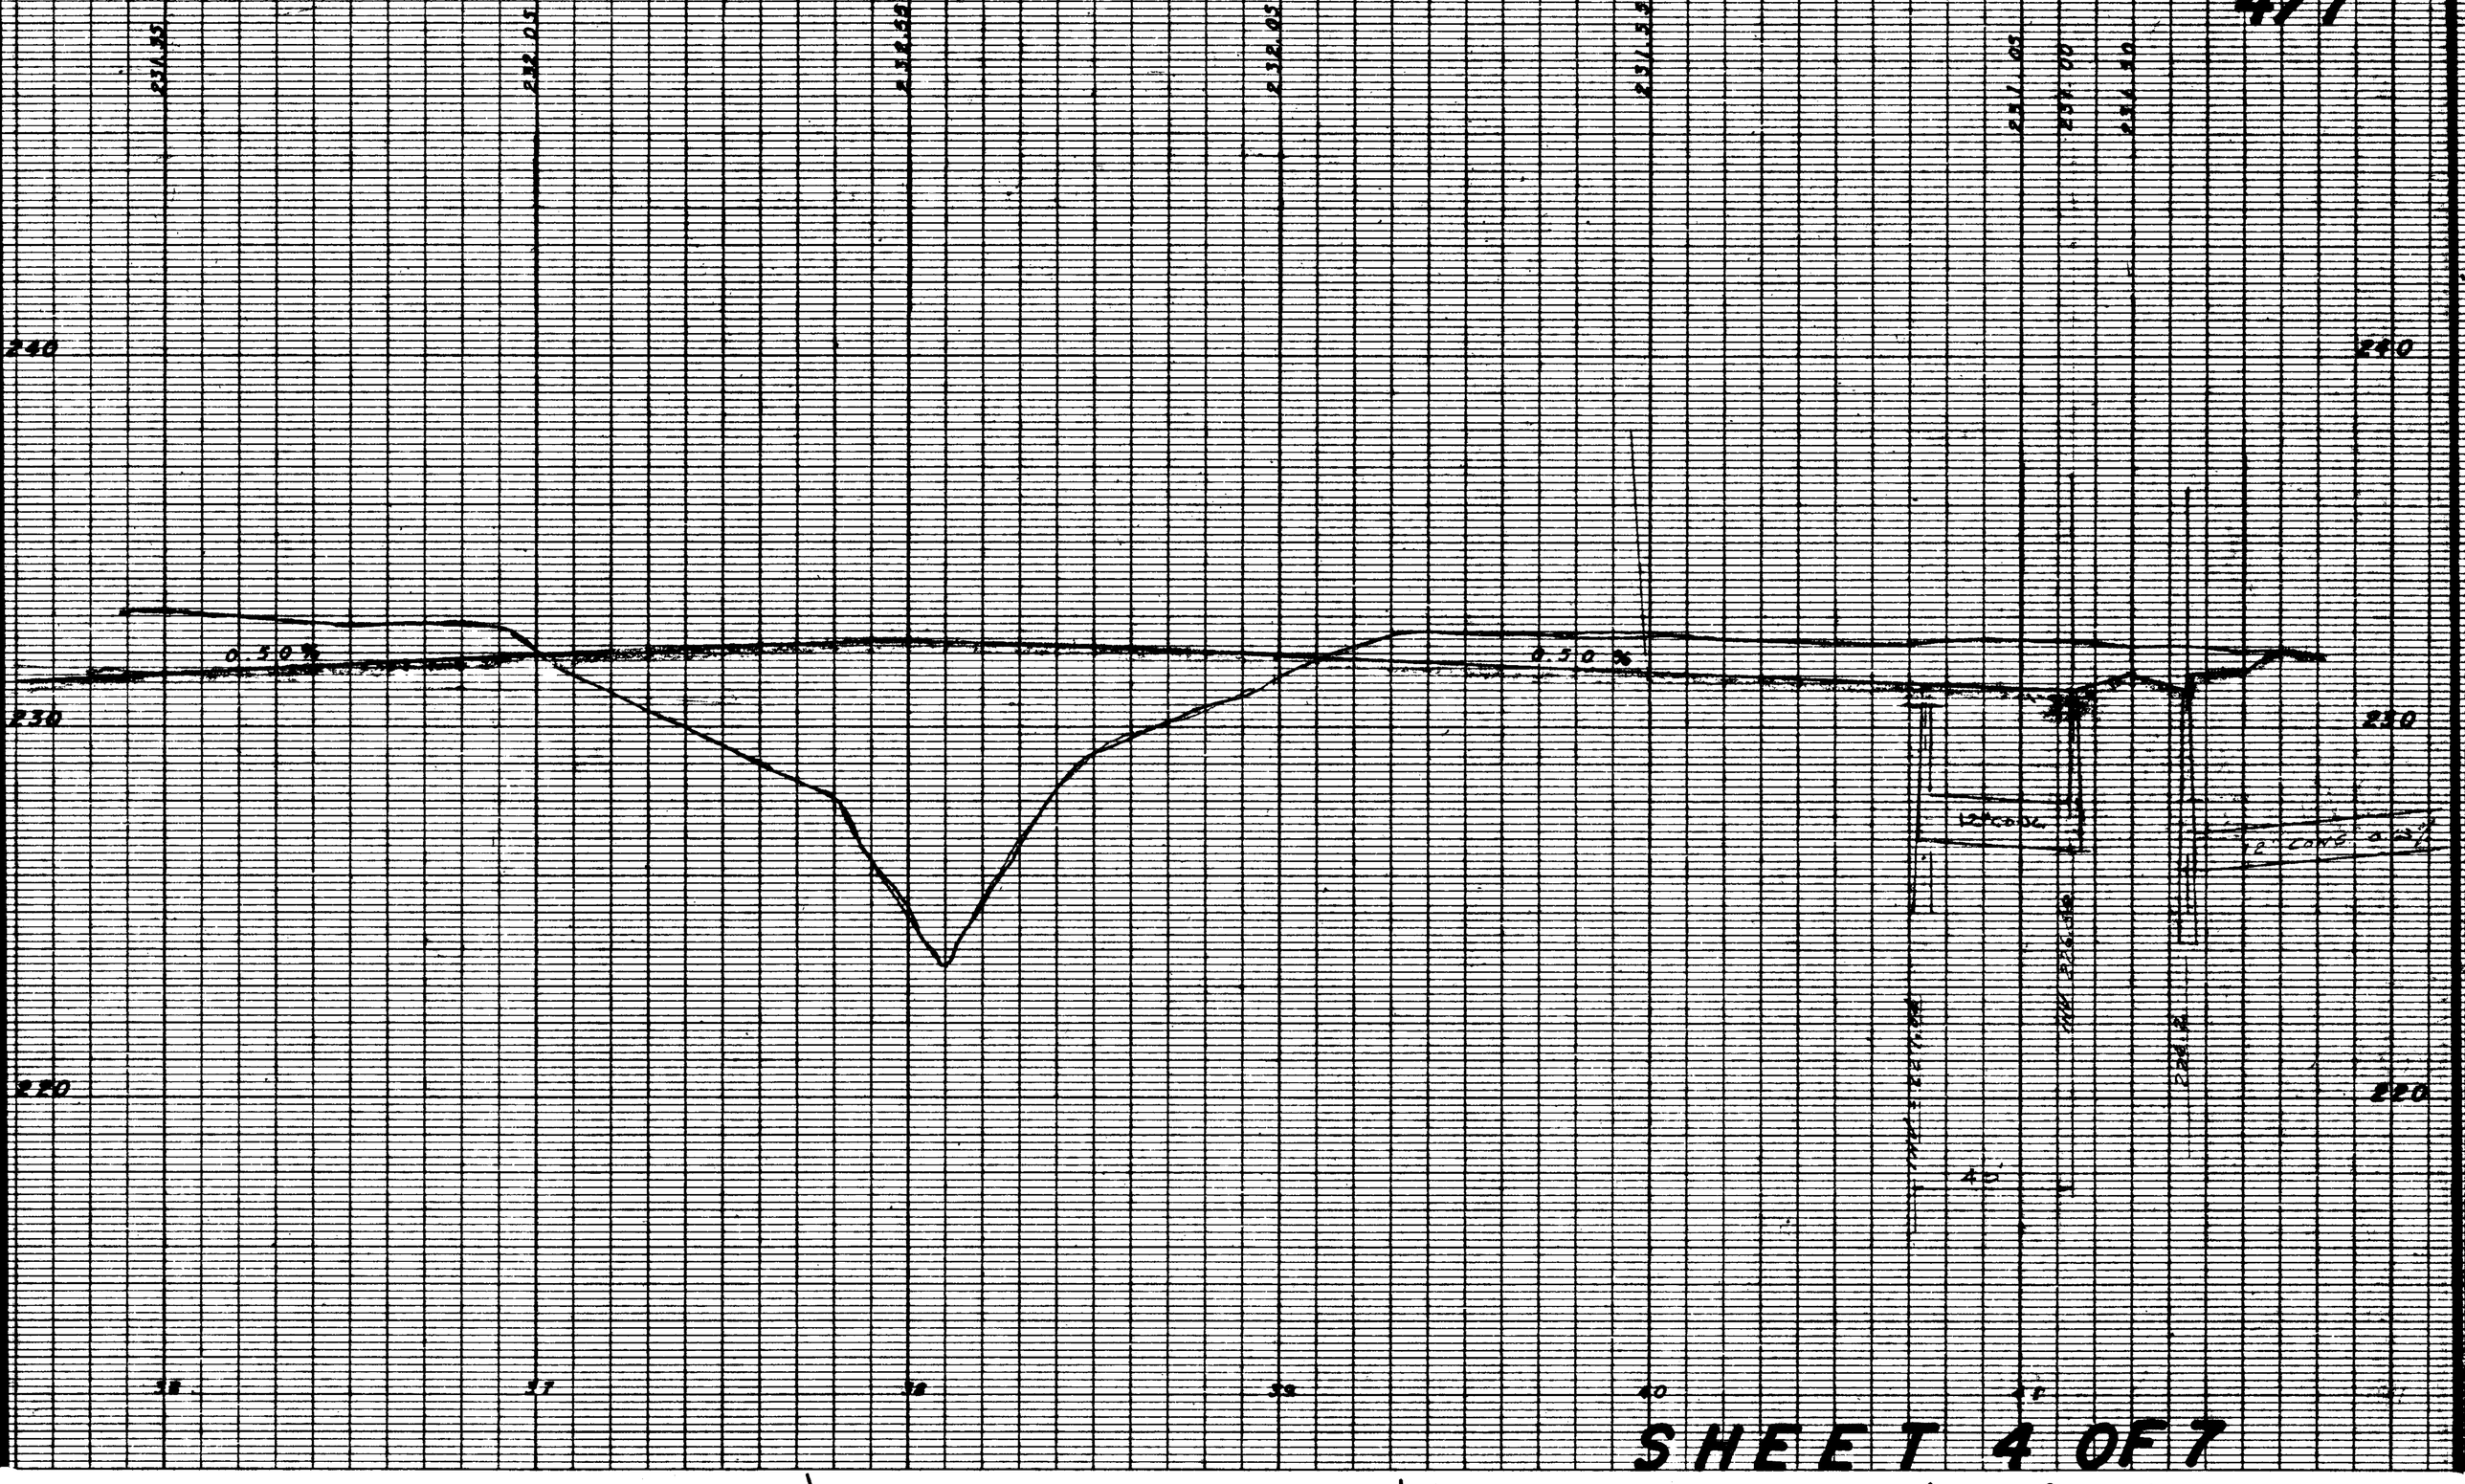

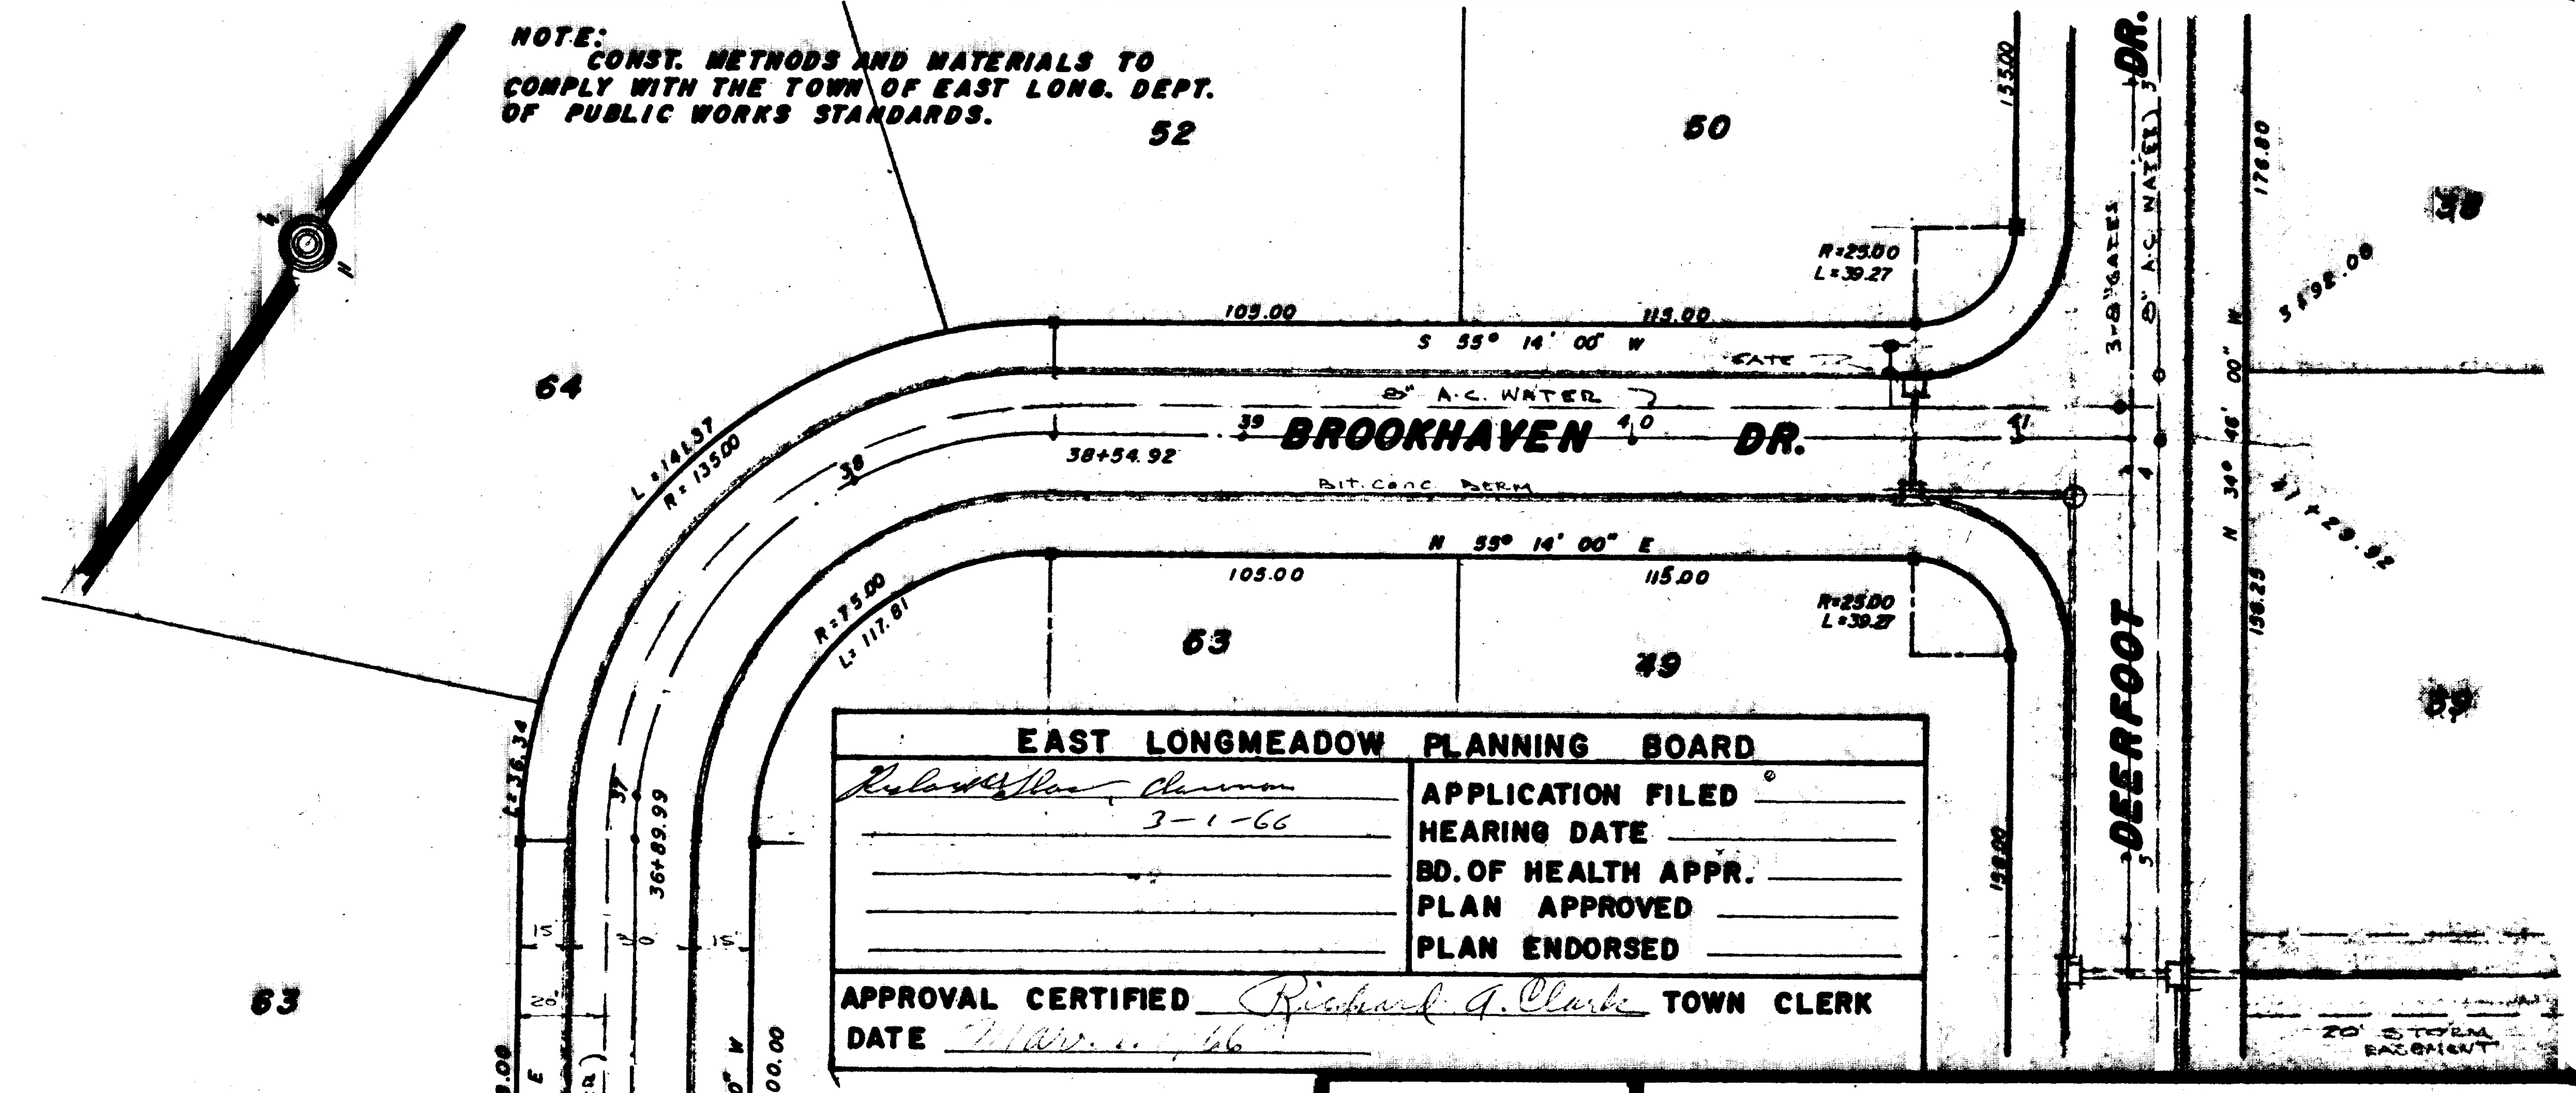

PLAN AND PROFILE OF LOTS IN EAST LONGMEADOW, MASS.

—OWNED BY—

DURKEE, WHITE, TOWNE AND CHAPDELAINE
CIVIL ENGINEERS
AND LAND SURVEYORS
358 FRONT STREET— CHICOPEE, MASSACHUSETTS

DRAWN BY	AUGUST 26, 1965	DWG. NO.
CHECKED BY	SCALE 1" = 40'	91-5208
APPROVED BY		