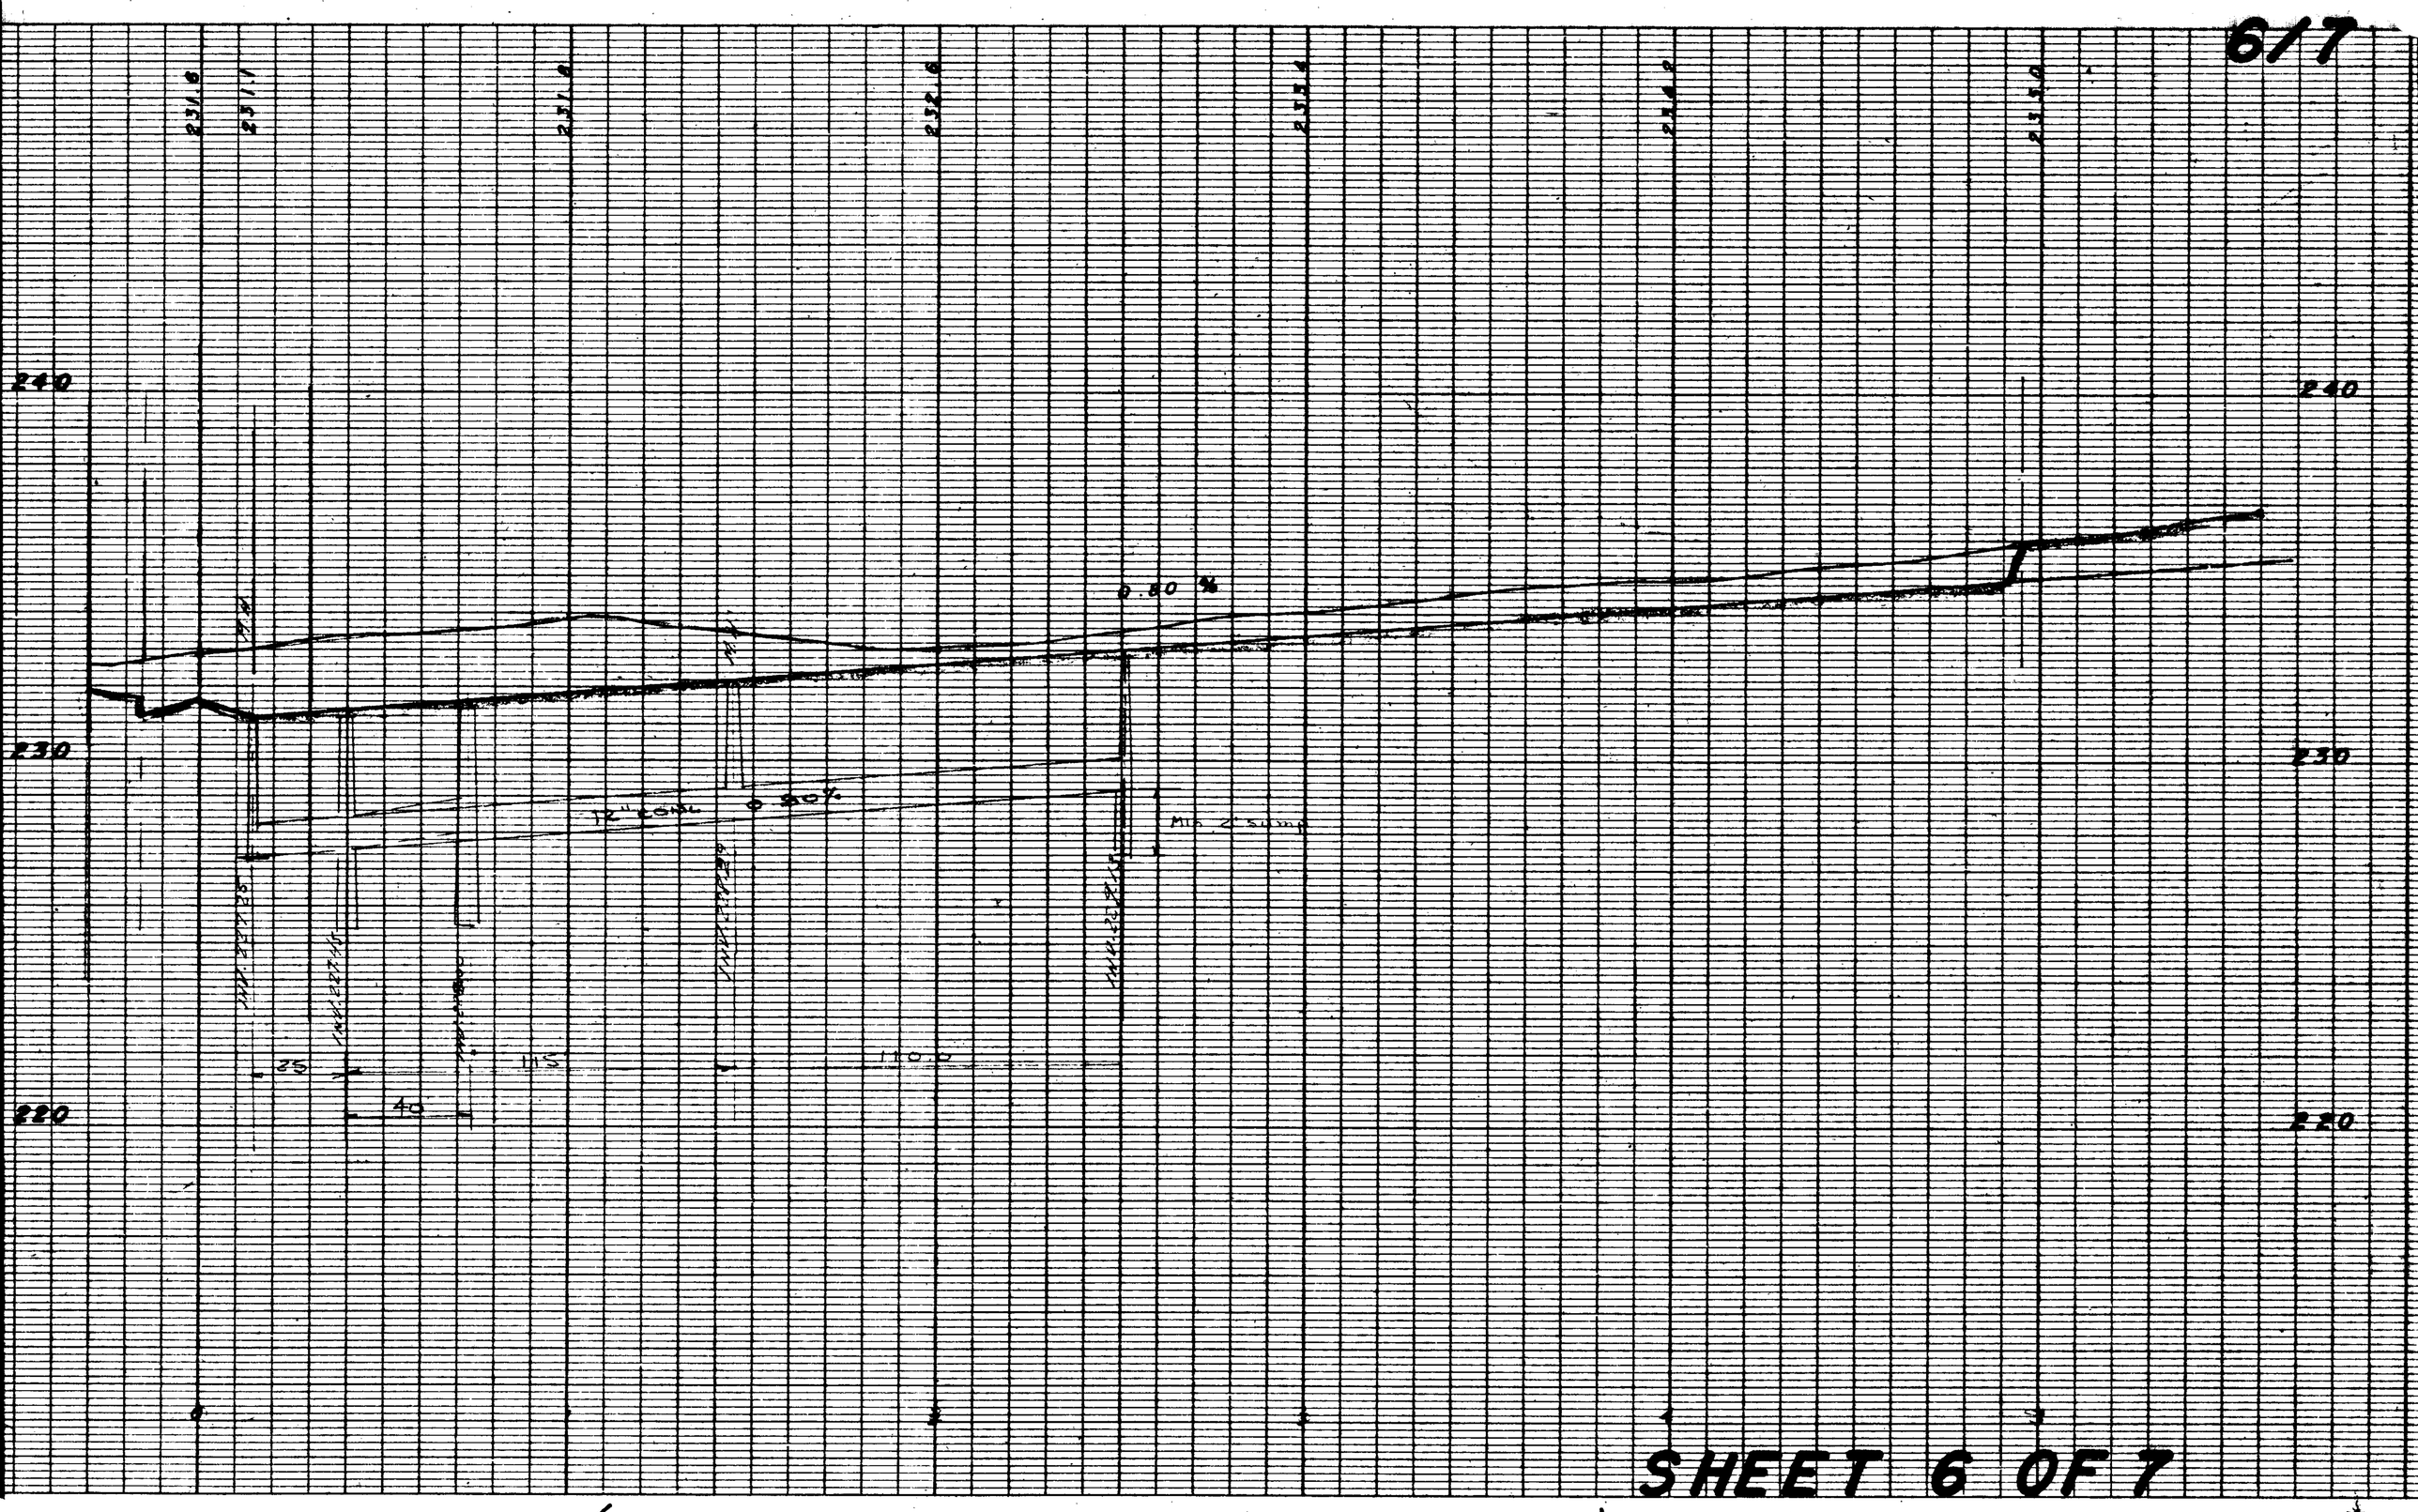

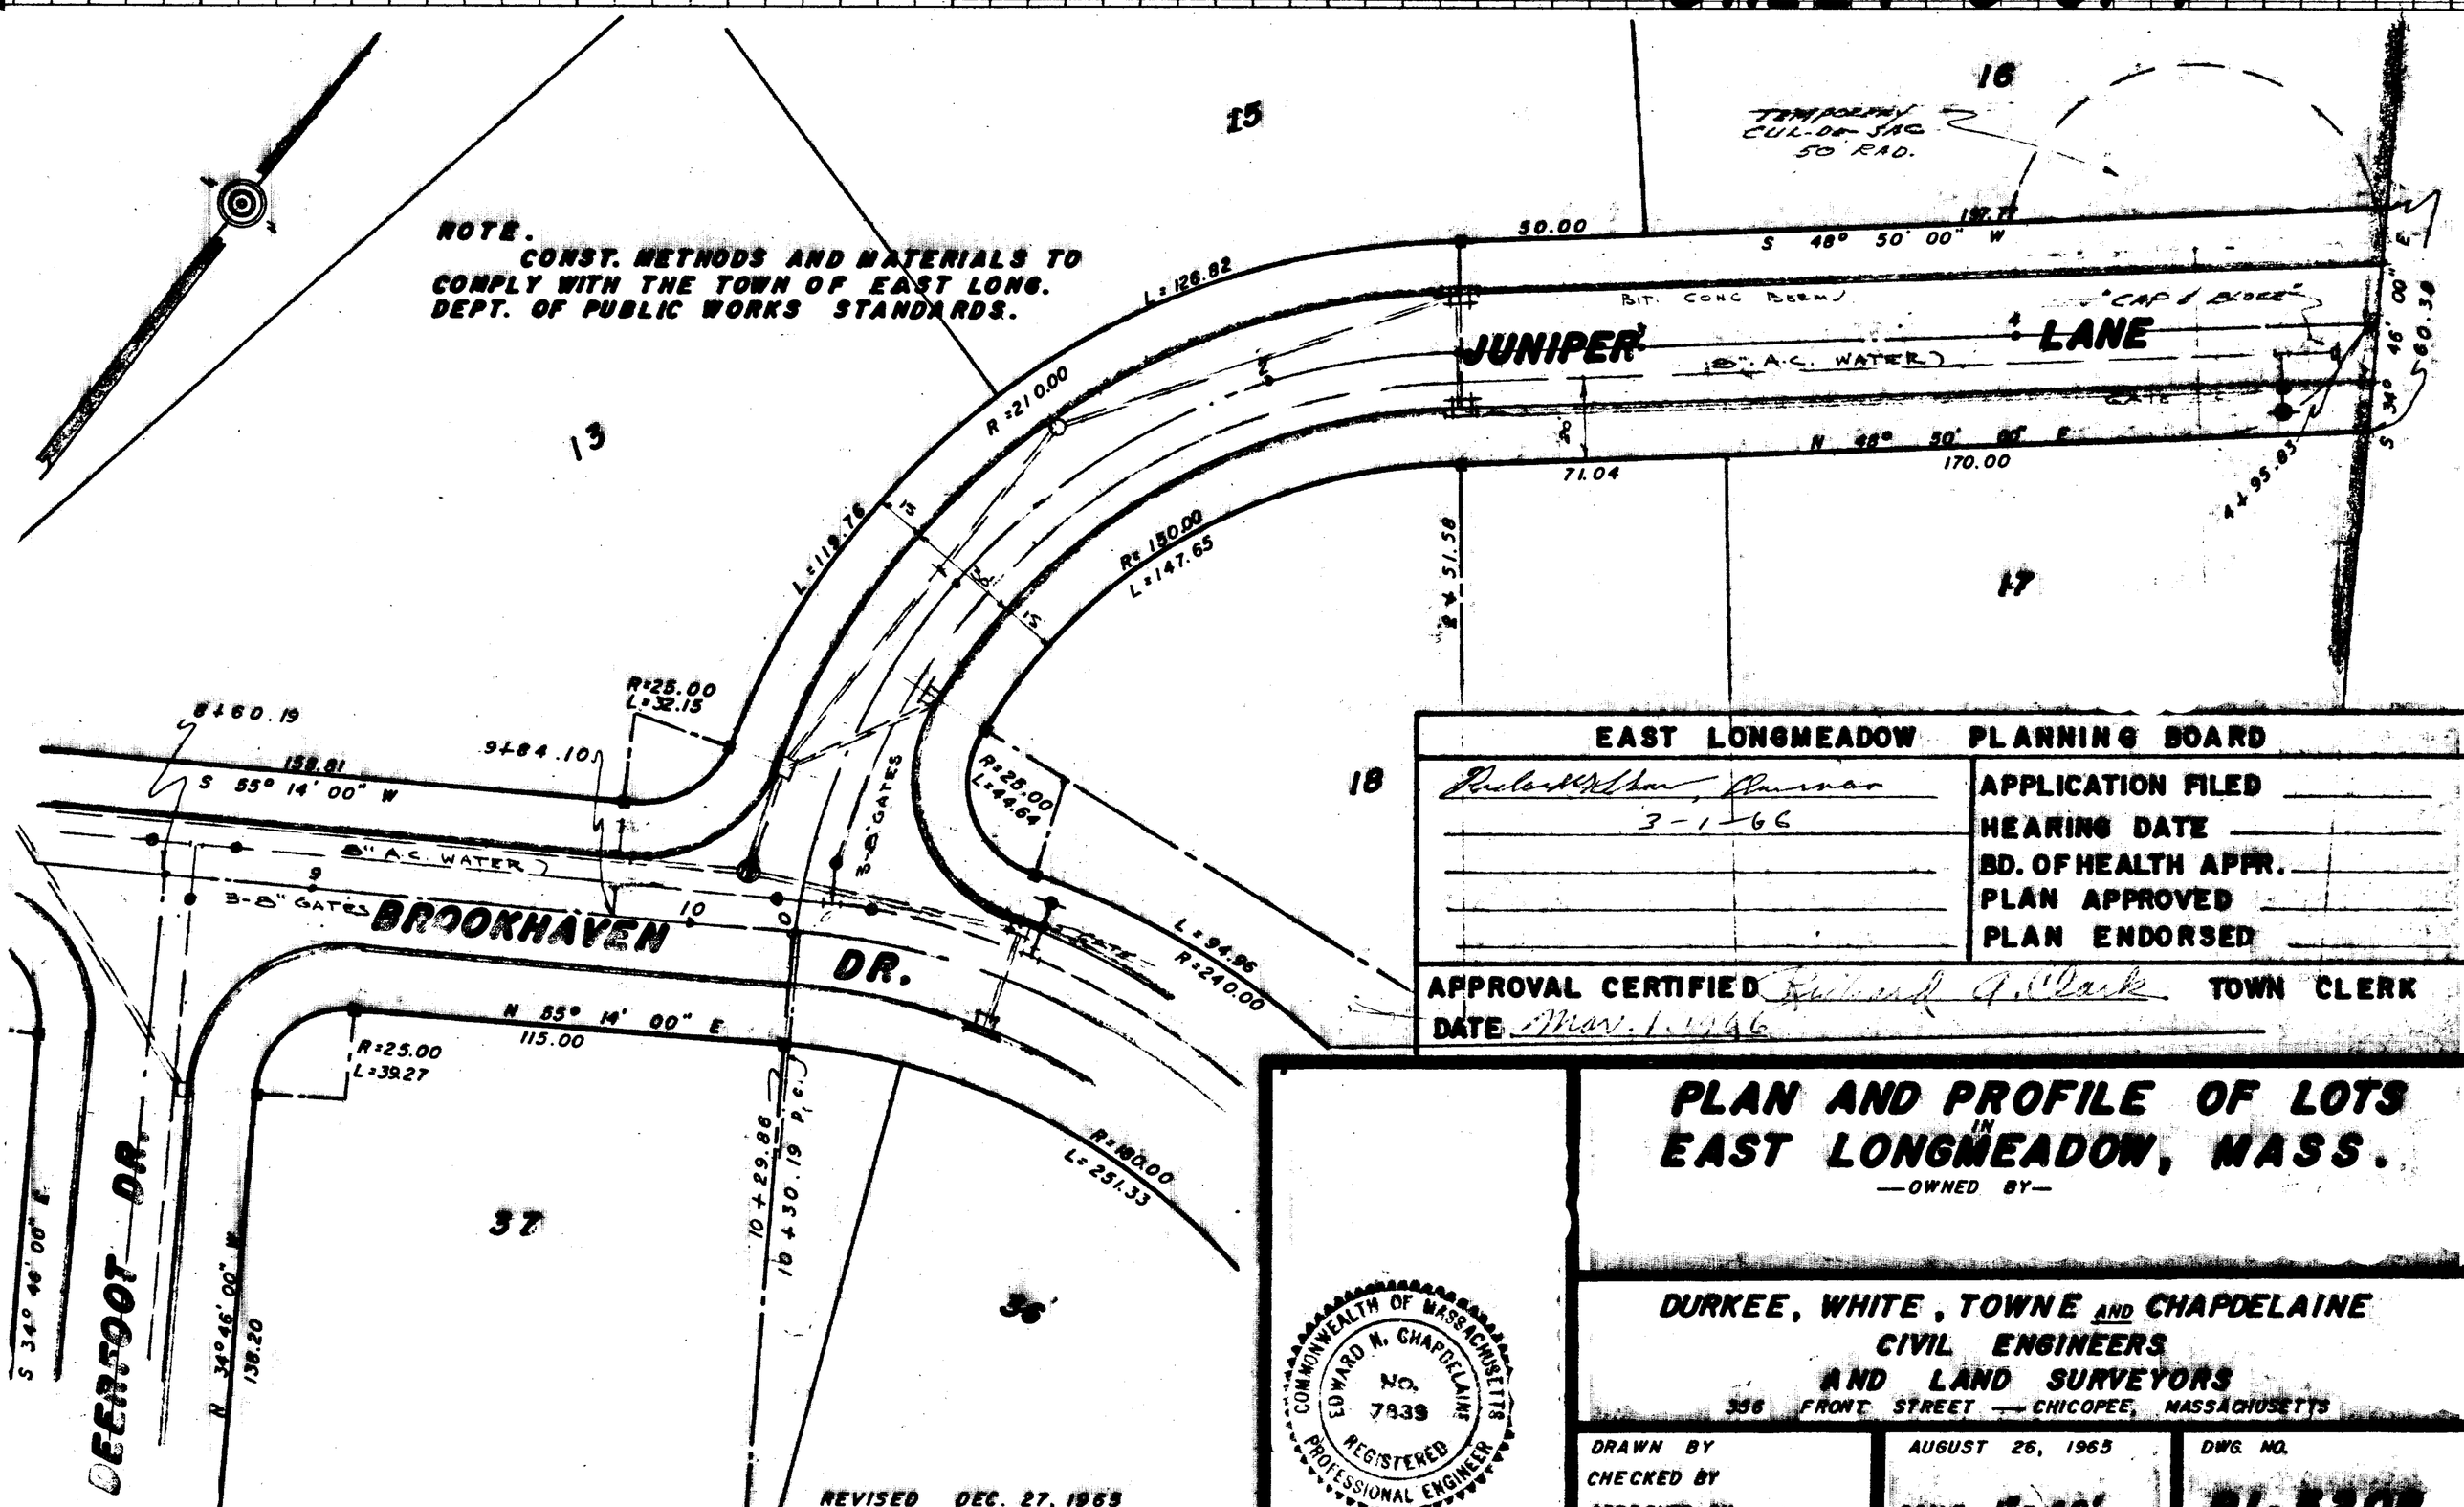

EAST LONGMEADOW PLANNING BOARD

Richard K. Allen, Chairman
3-1-66

APPLICATION FILED
HEARING DATE
BD. OF HEALTH APPR.
PLAN APPROVED
PLAN ENDORSED

APPROVAL CERTIFIED Richard G. Clark TOWN CLERK
DATE Mar. 1, 1966

COMMONWEALTH OF MASSACHUSETTS
EDWARD N. CHAPDELAINE
No. 7839
REGISTERED PROFESSIONAL ENGINEER

PLAN AND PROFILE OF LOTS IN EAST LONGMEADOW, MASS.

—OWNED BY—

DURKEE, WHITE, TOWNE AND CHAPDELAINE
CIVIL ENGINEERS
AND LAND SURVEYORS
356 FRONT STREET — CHICOPEE, MASSACHUSETTS

DRAWN BY	AUGUST 26, 1965	DWG. NO.
CHECKED BY		
APPROVED BY	SCALE 1" = 40'	91-5208