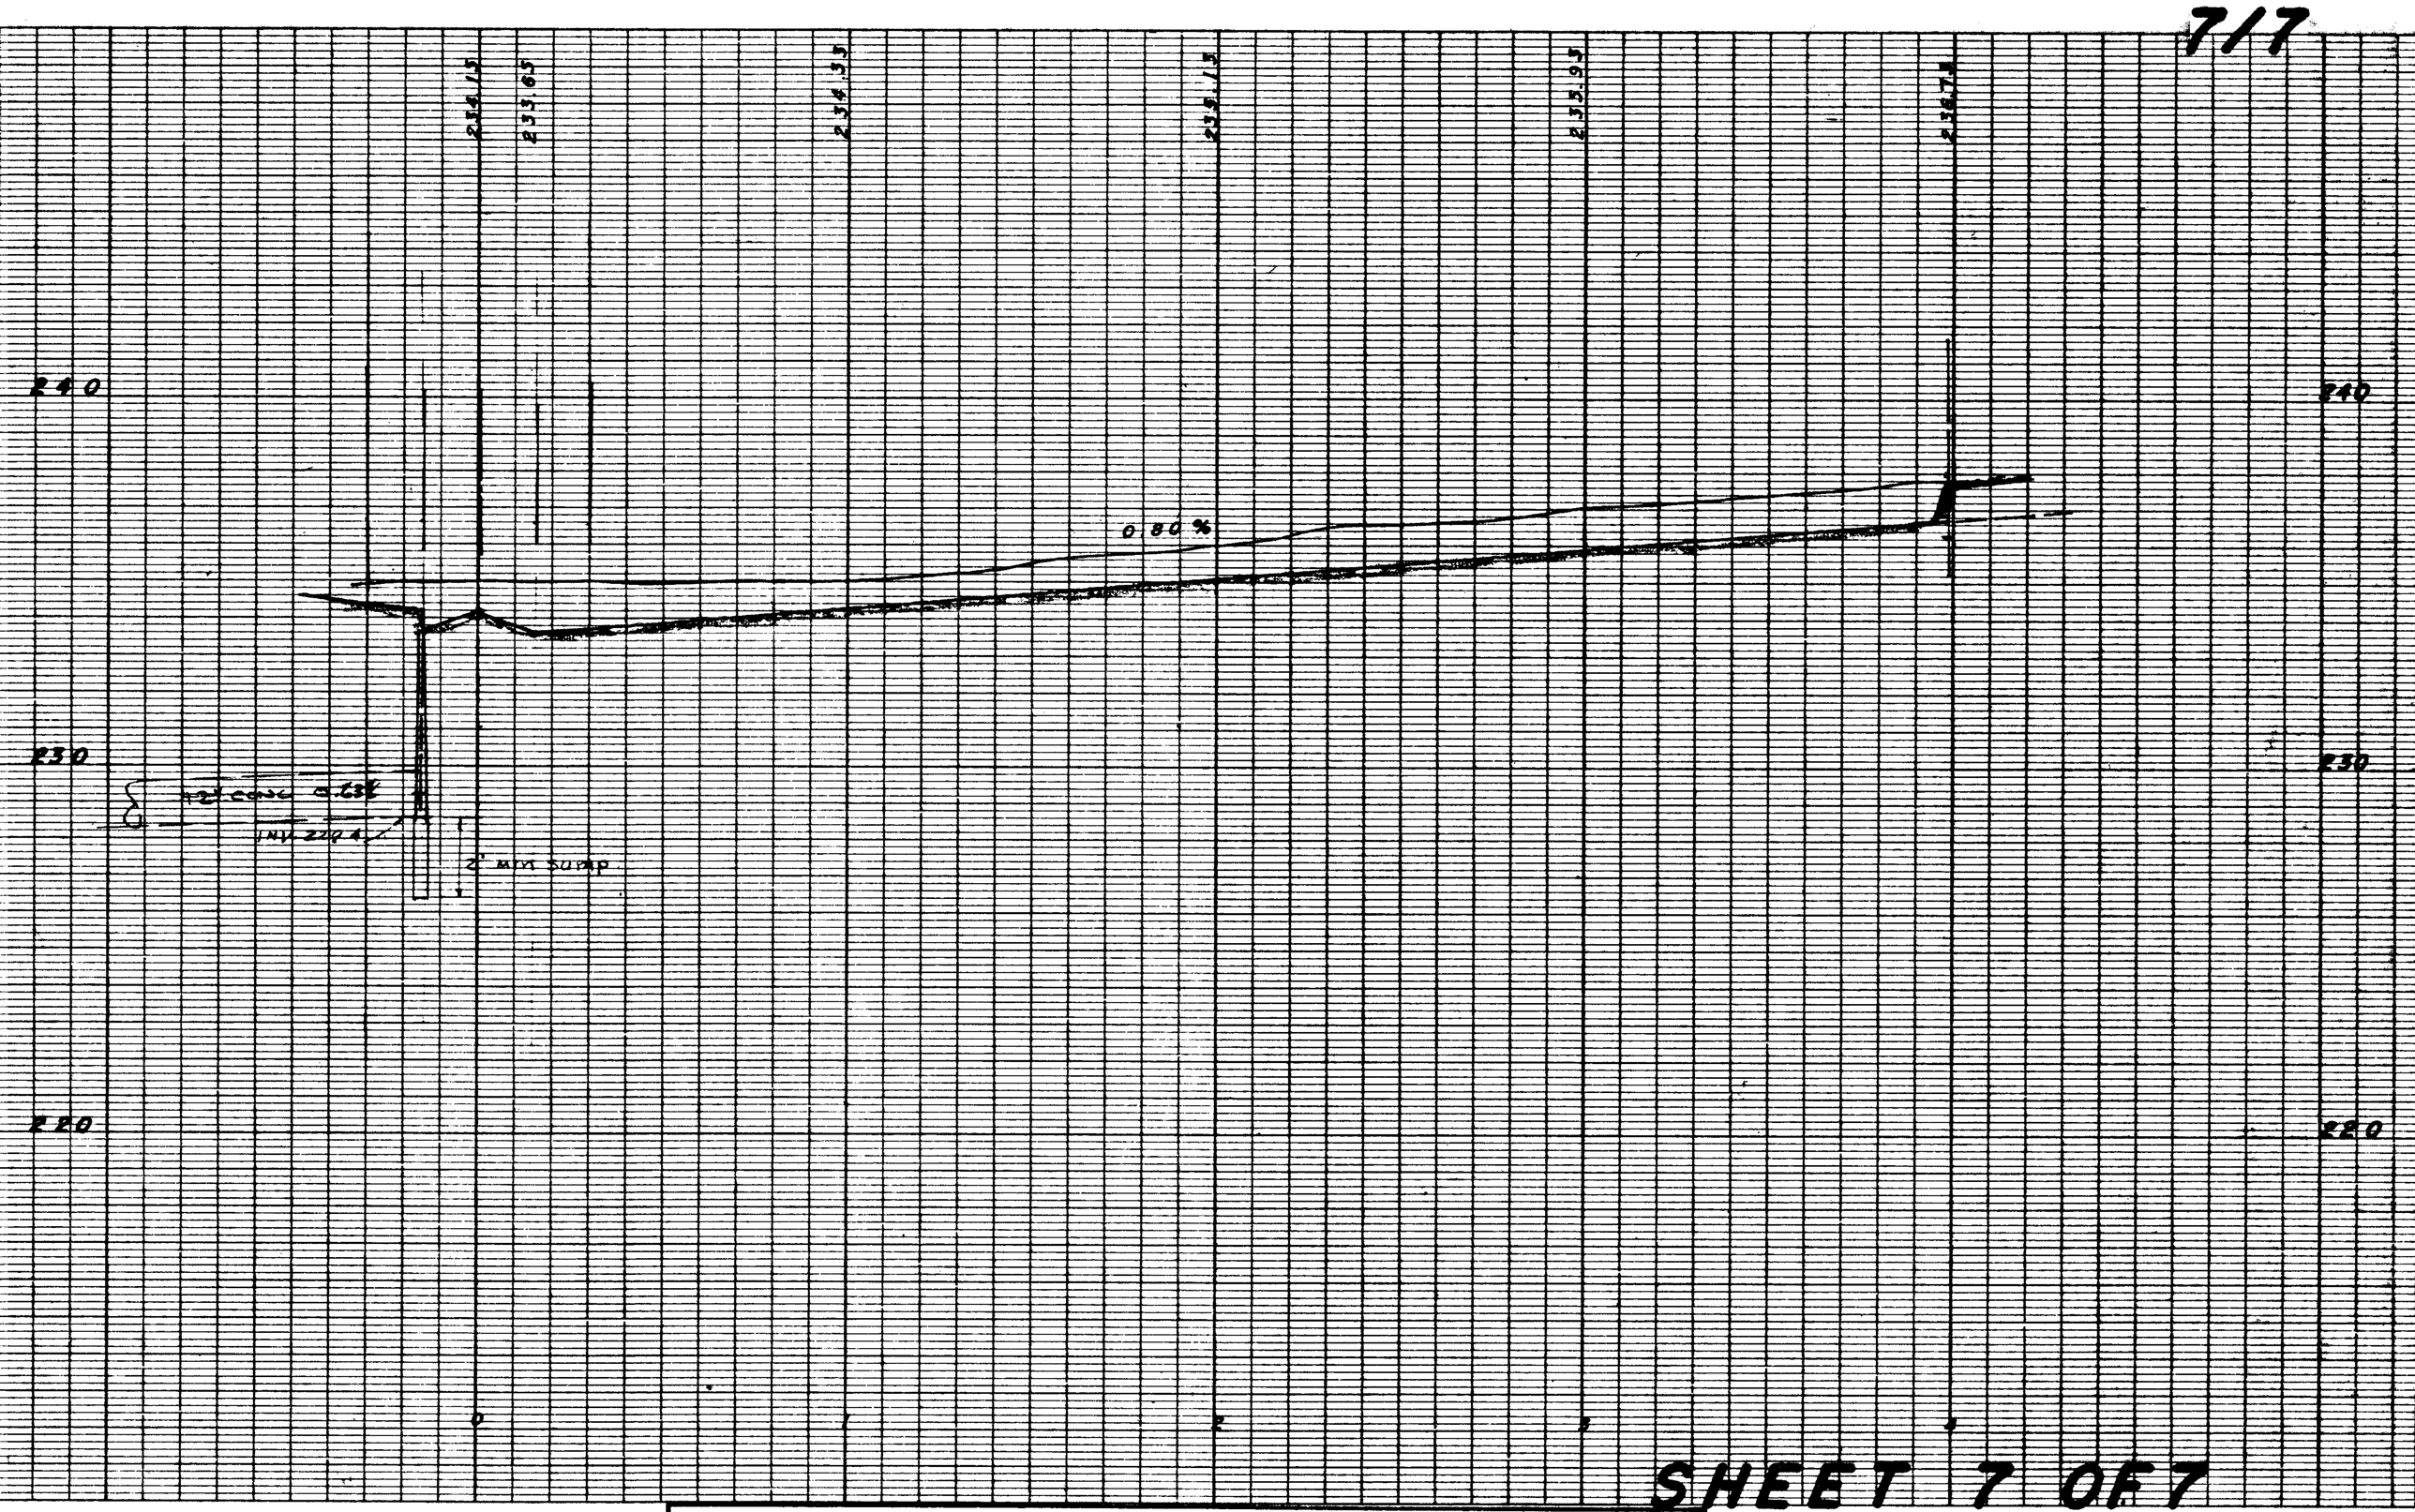

SHEET 7 OF 7

EAST LONGMEADOW PLANNING BOARD

Richard A. Clark, Chairman
3-1-66

APPLICATION FILED
HEARING DATE
BD. OF HEALTH APPR.
PLAN APPROVED
PLAN ENDORSED

APPROVAL CERTIFIED Richard A. Clark TOWN CLERK
DATE March 1 1966

NOTE:
CONST. METHODS AND MATERIALS TO COMPLY WITH THE TOWN OF EAST LONG. DEPT OF PUBLIC WORKS STANDARDS.

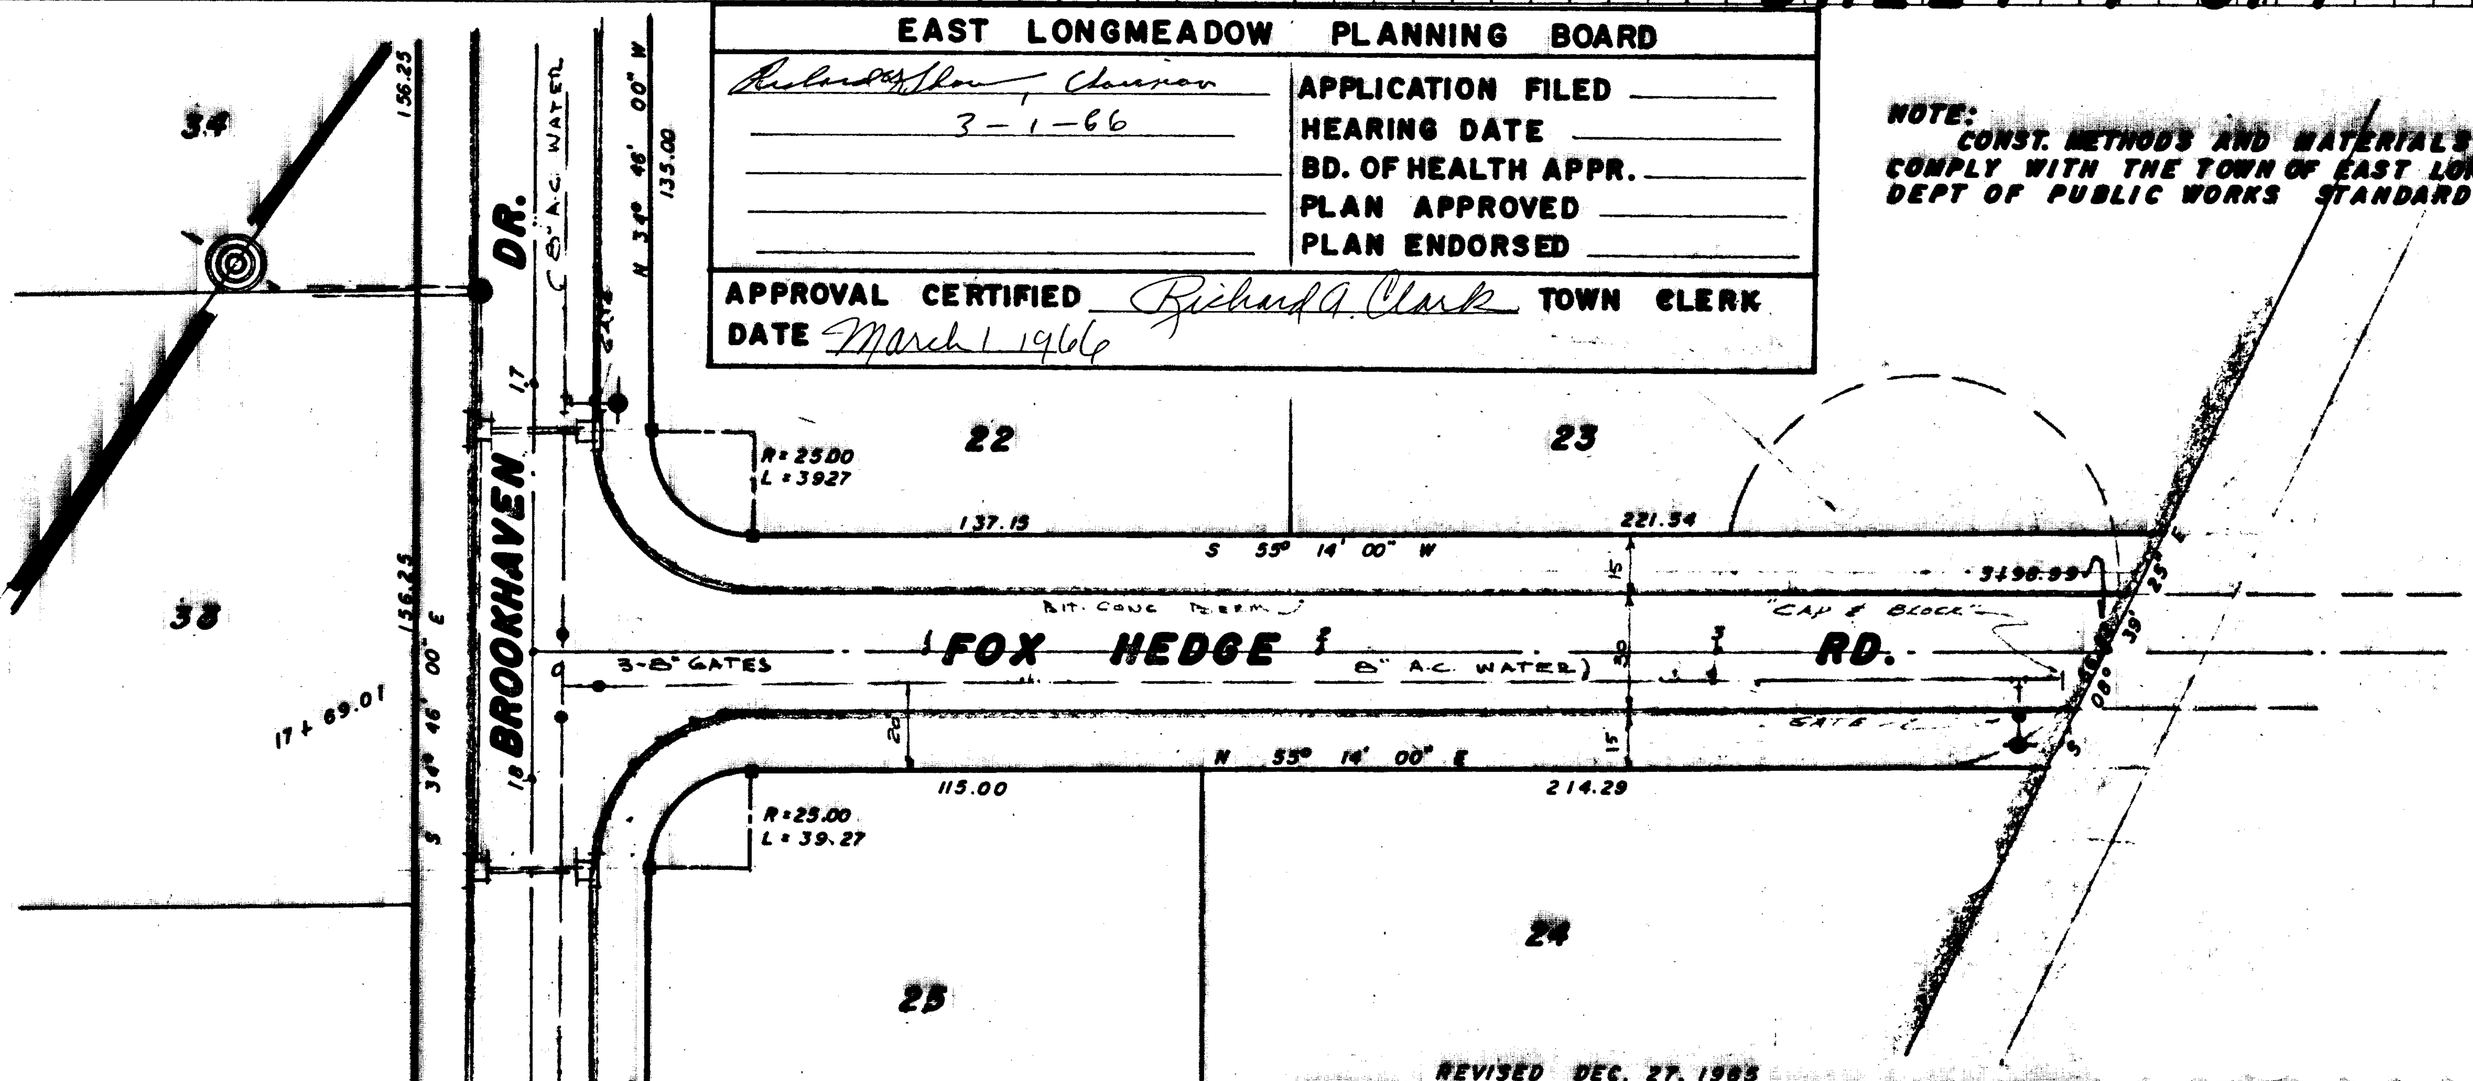

REVISED DEC. 27, 1965

PLAN AND PROFILE OF LOTS EAST LONGMEADOW, MASS.

—OWNED BY—

DURKEE, WHITE, TOWNE AND CHAPDELAINE
CIVIL ENGINEERS
AND LAND SURVEYORS
358 FRONT STREET — CHICOPEE, MASSACHUSETTS

COMMONWEALTH OF MASSACHUSETTS
EDWARD N. CHAPDELAINE
No.
AUGUSTA
PROFESSIONAL ENGINEER

DRAWN BY CHECKED BY APPROVED BY	AUGUST 26, 1965 SCALE 1"=40"	DWG. NO. 91-5208