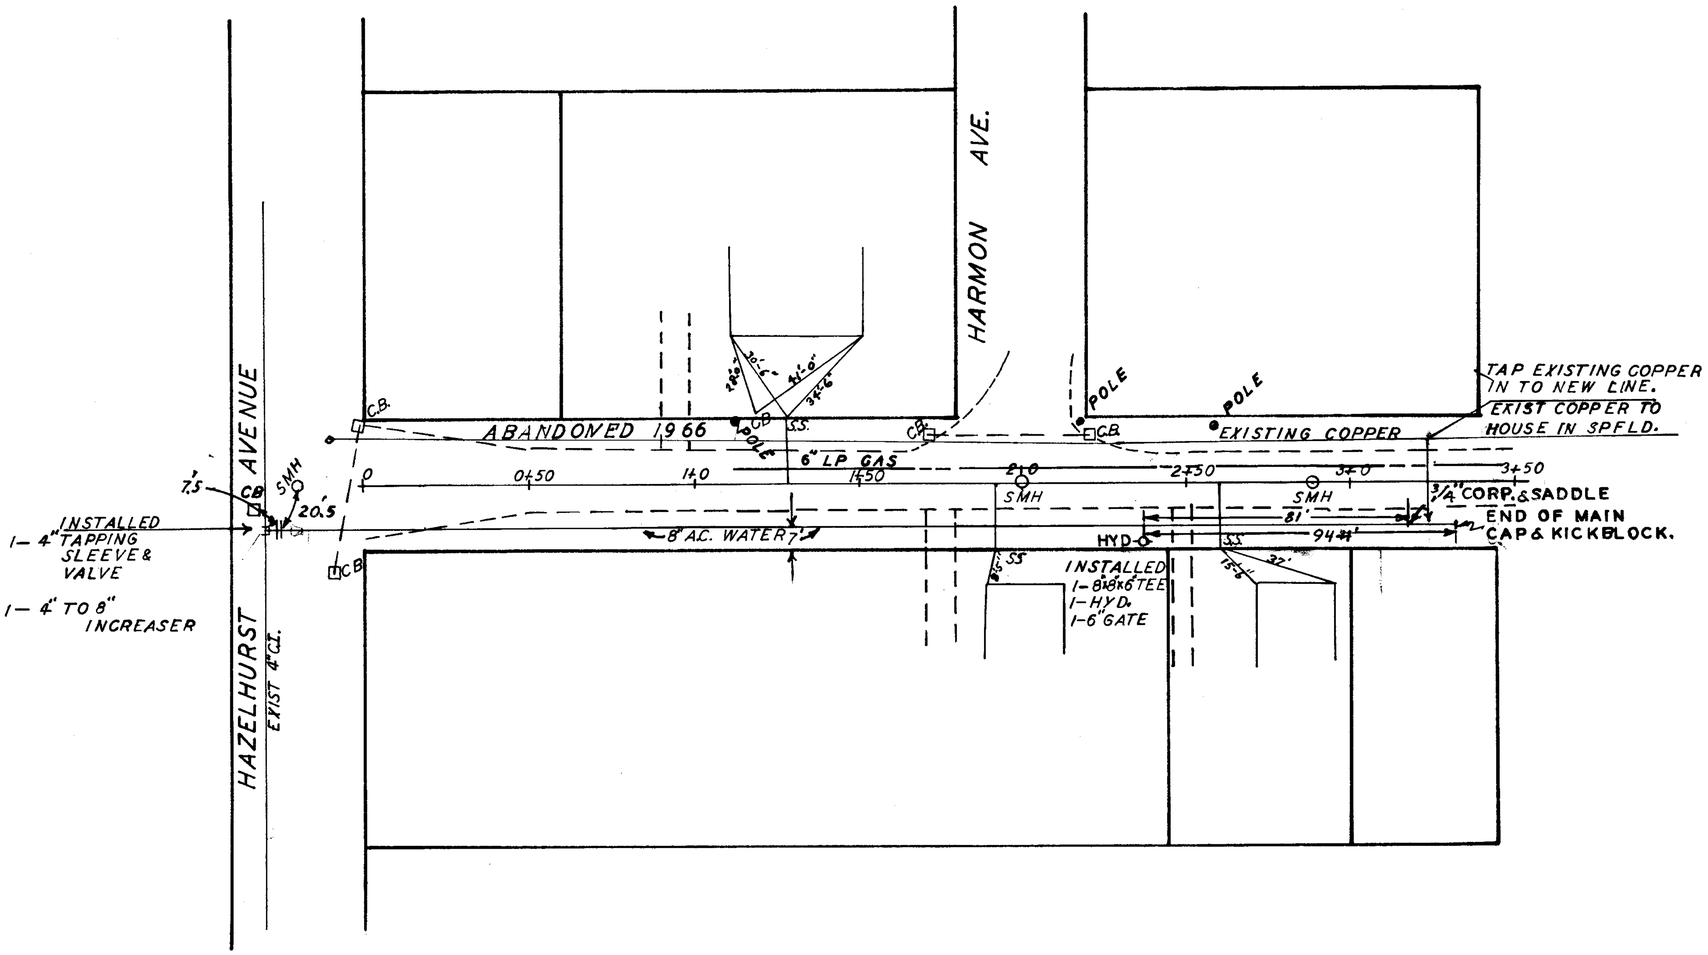


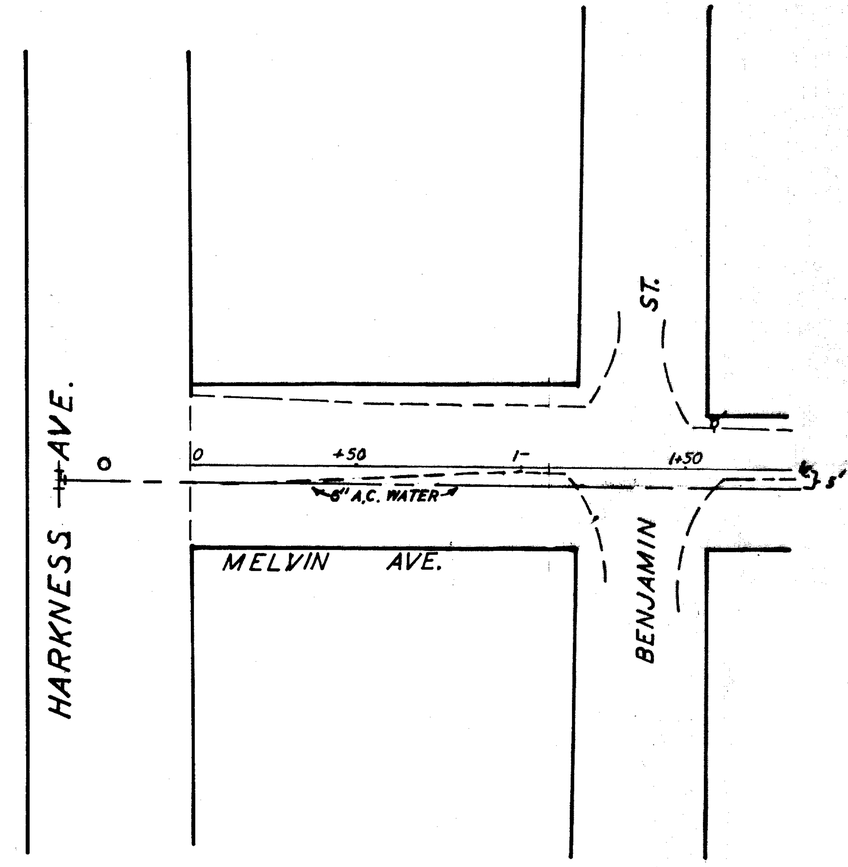


PLAN SHOWING
8" A.C. WATERMAIN
ORPHEUM AVE.

SCALE 1" = 40' AUGUST, 1966

W-272