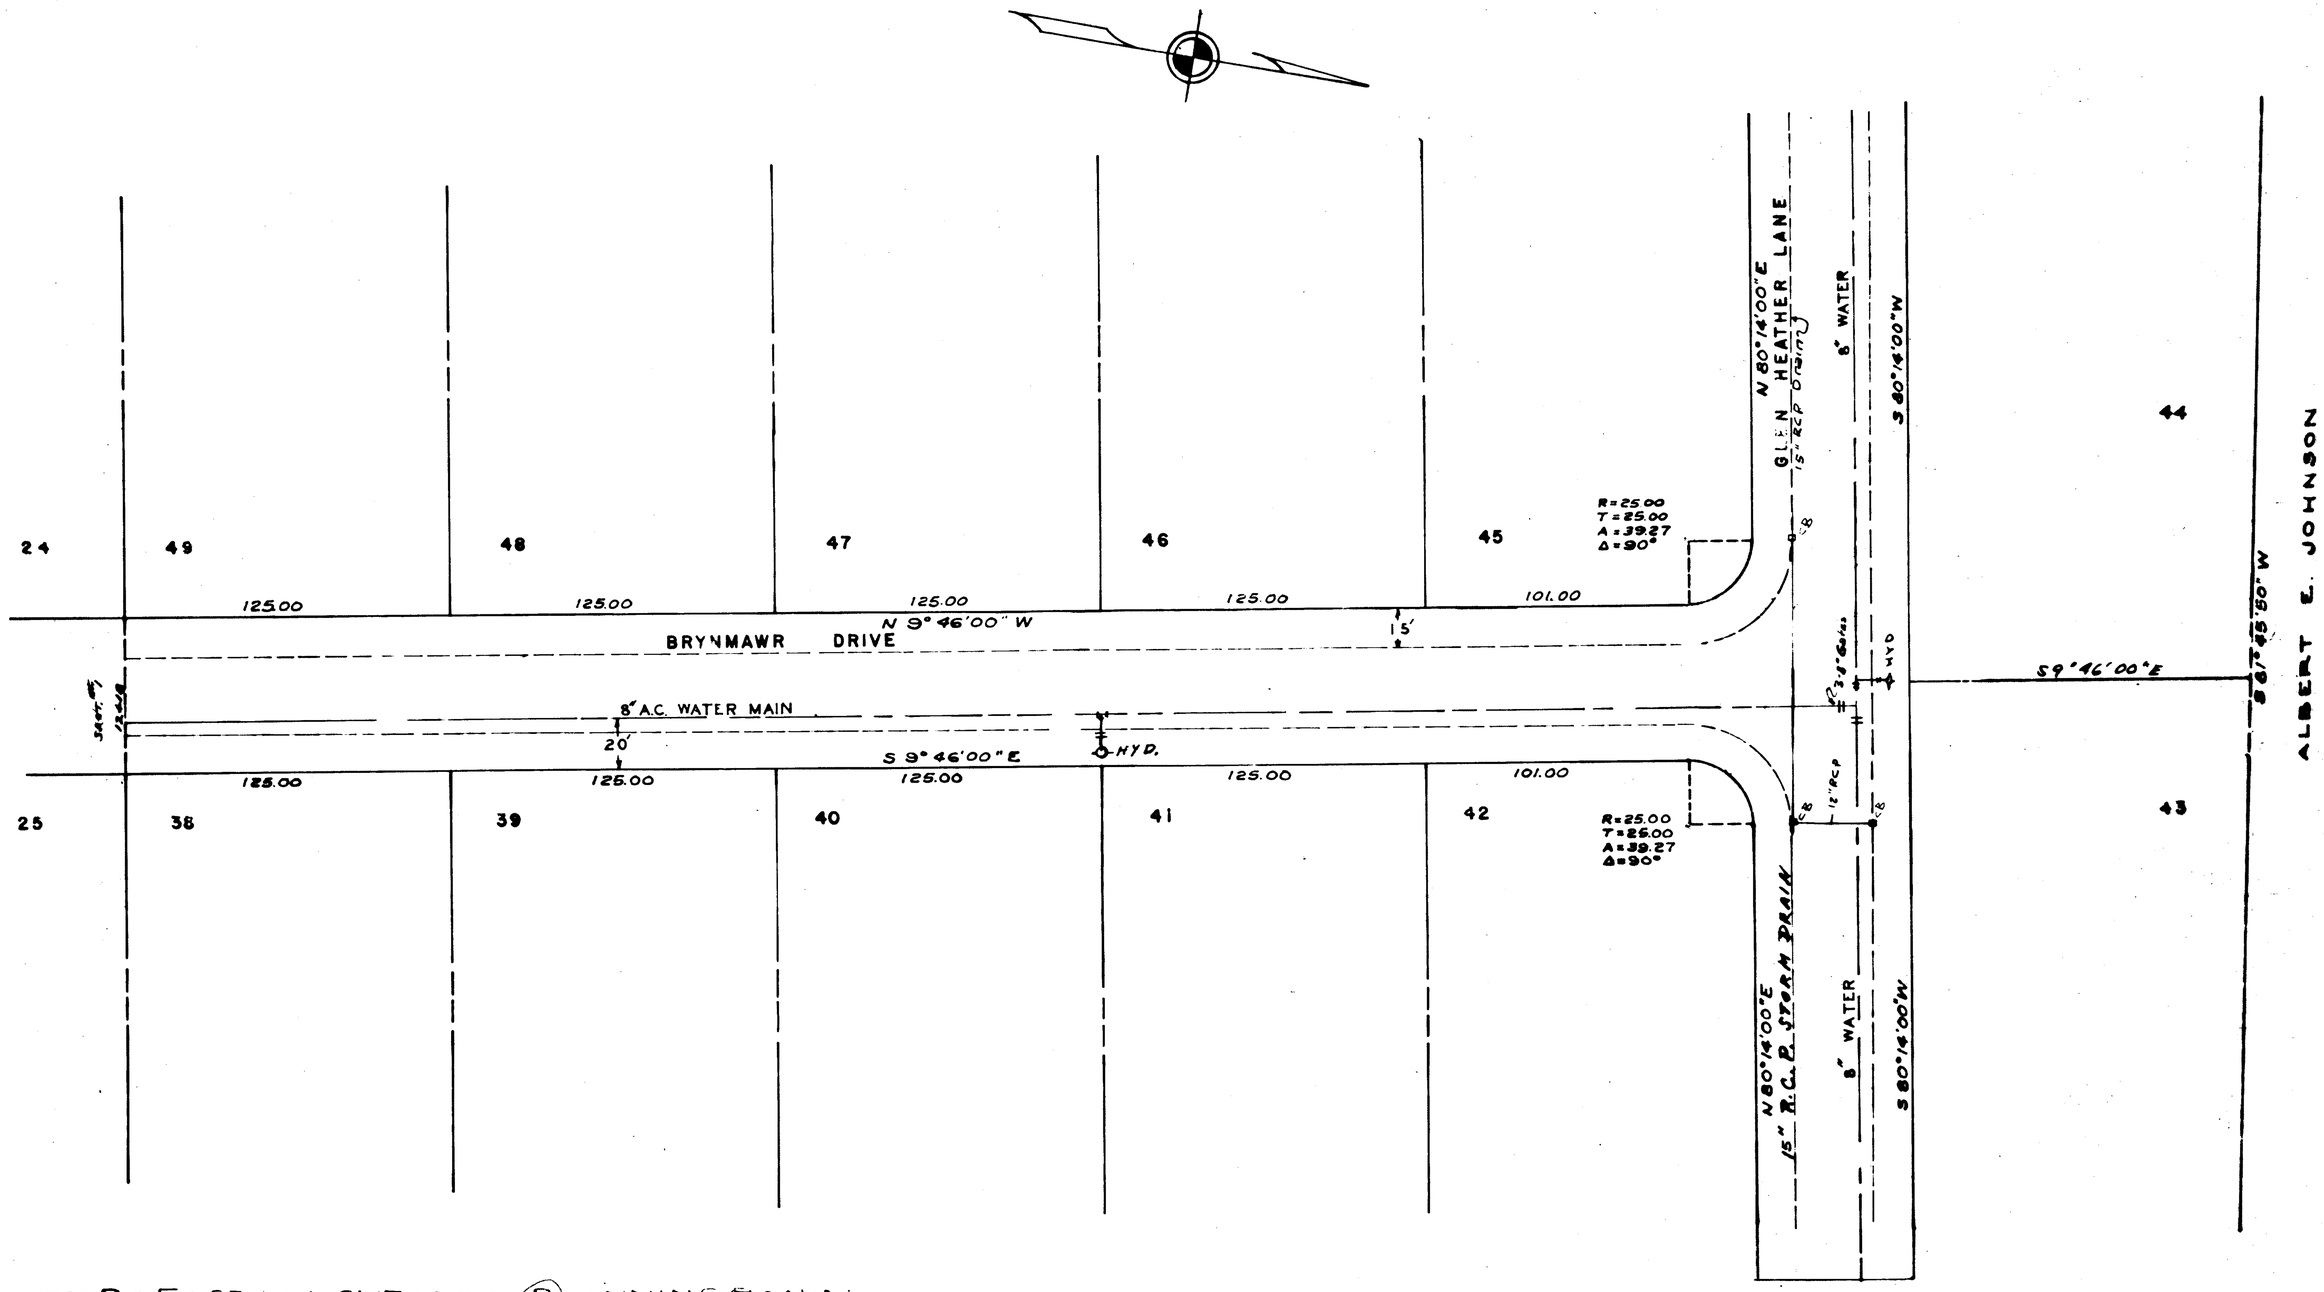


APPROVED BY EAST LONGMEADOW PLANNING BOARD

DATE: 5/16/67

CHAIRMAN

SHEET 4 OF 8

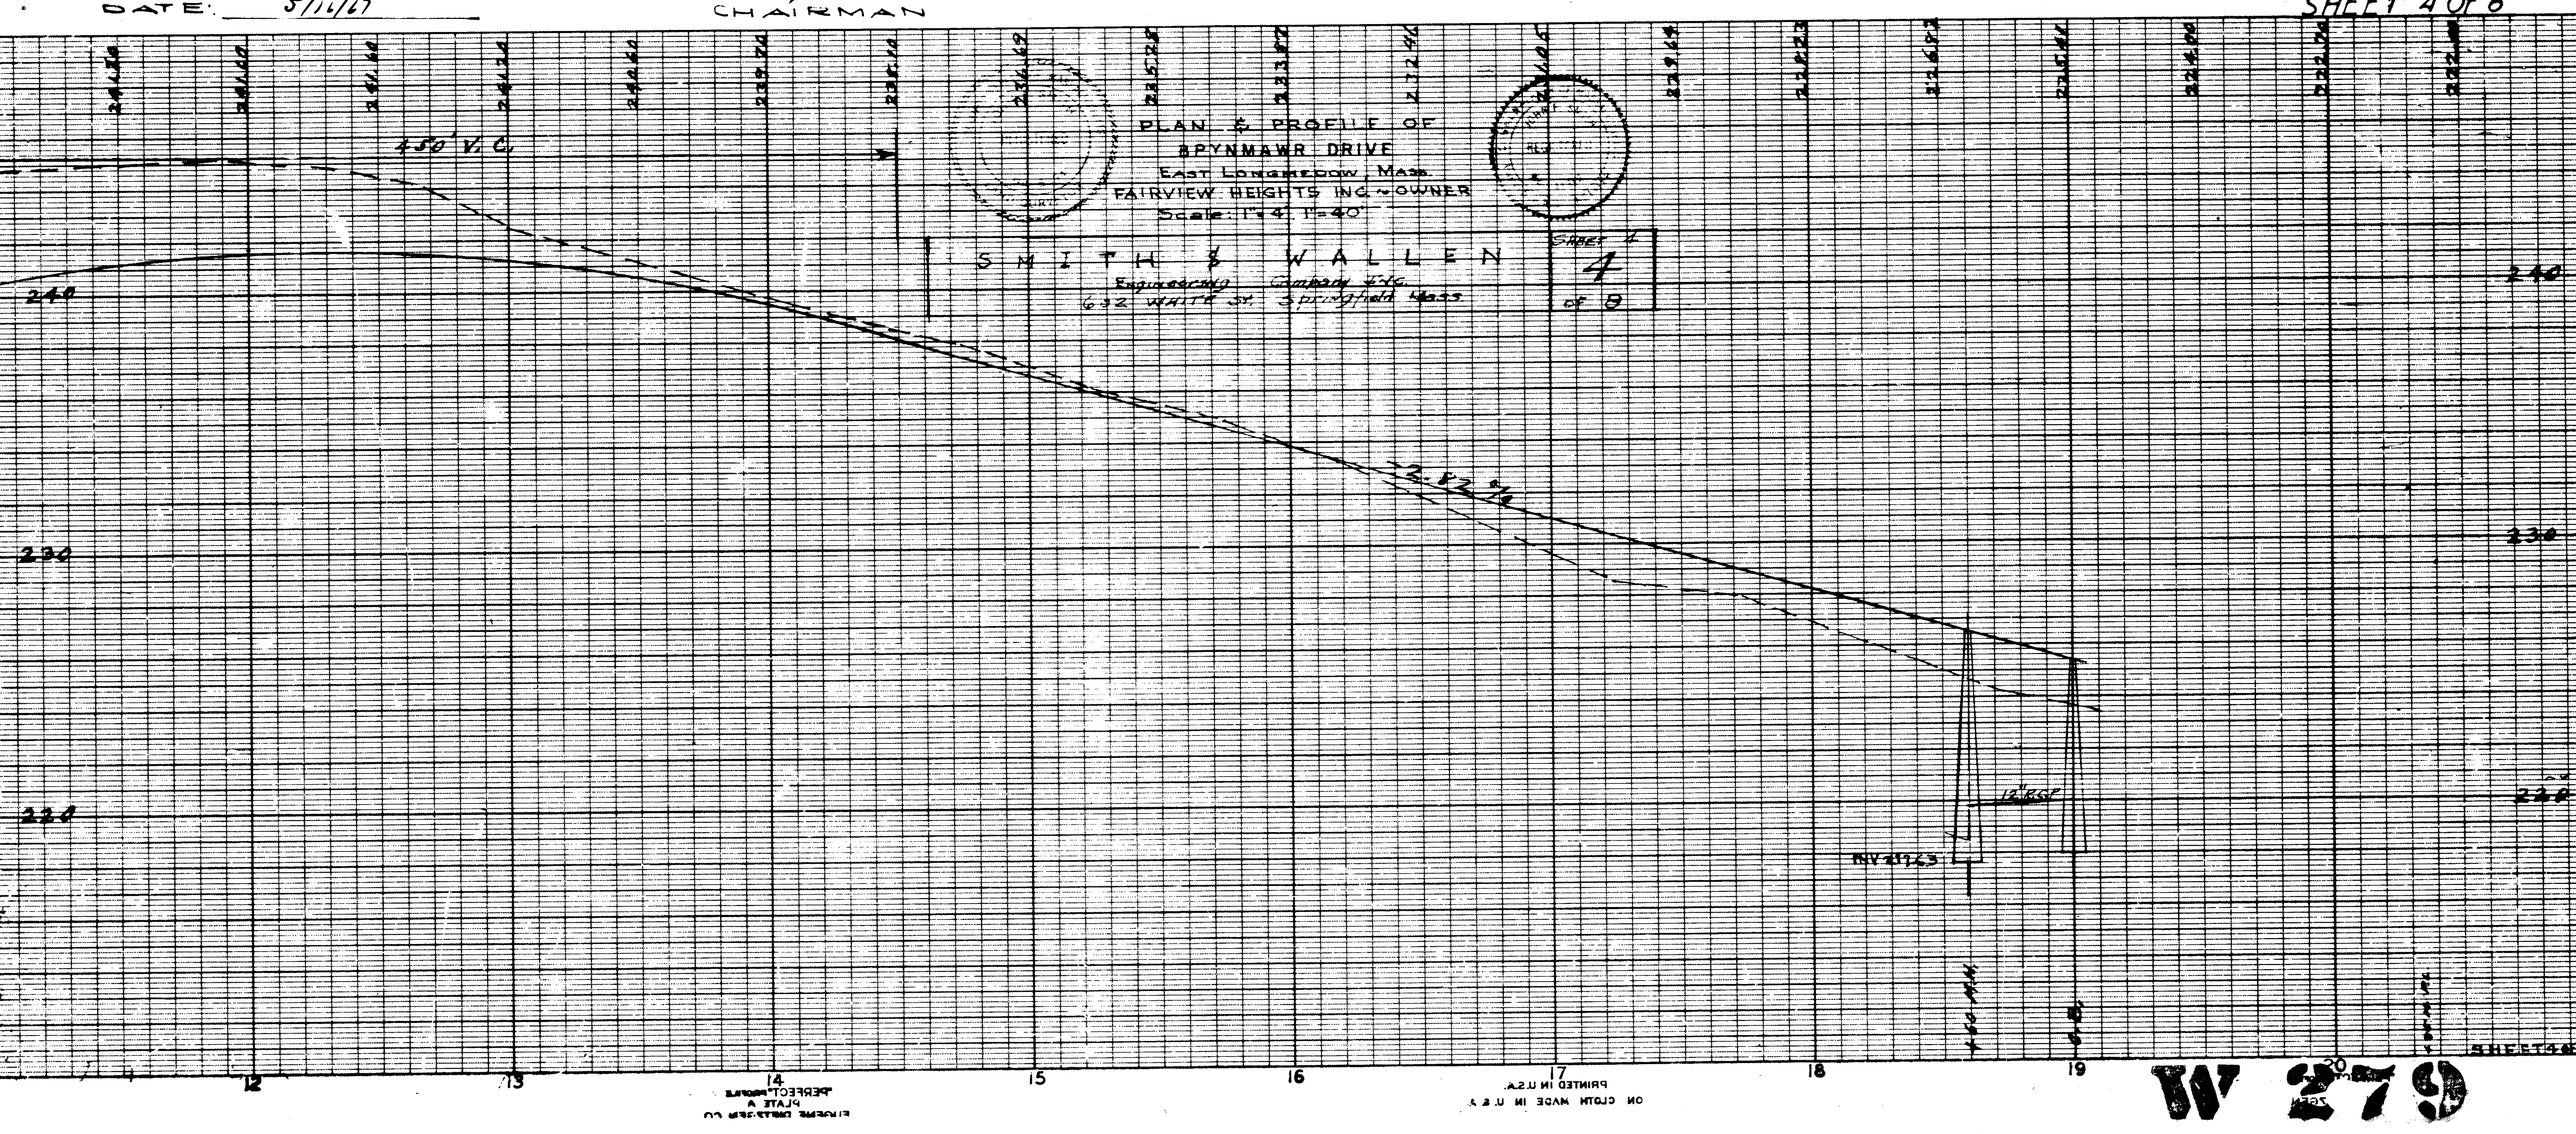


W 279