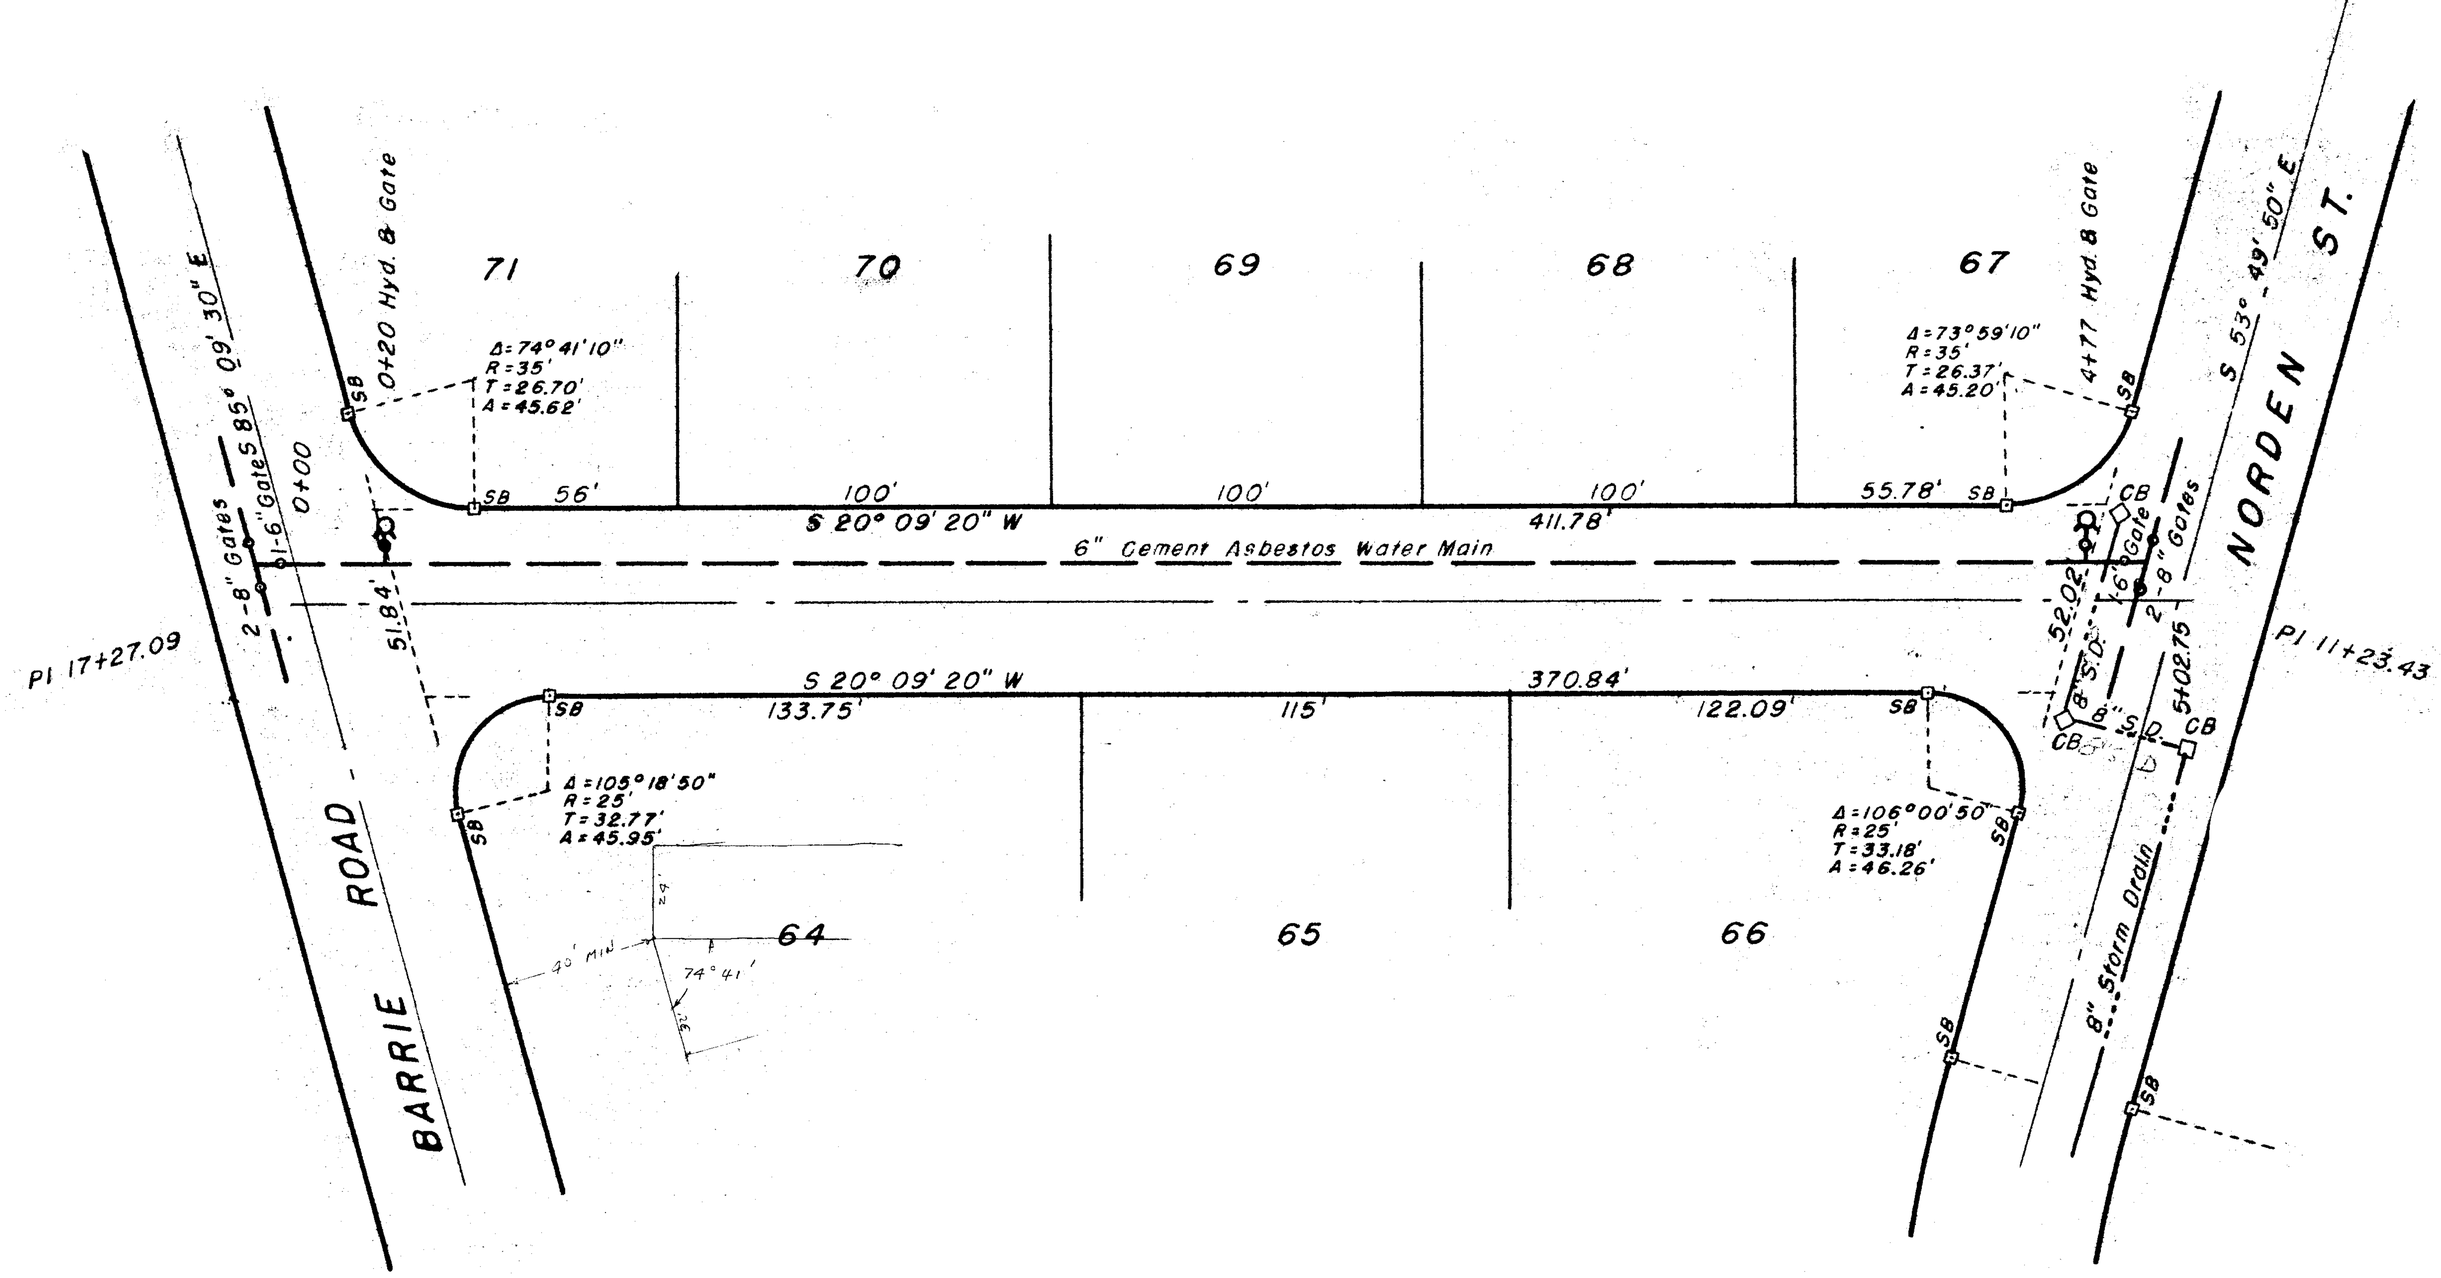

PLAN & PROFILE FOR

SUSAN STREET

MAPLE MANOR ESTATES

DEVELOPED BY

NORMAR CORPORATION

EAST LONGMEADOW - MASSACHUSETTS

SCALE Hor. 1 IN. = 40 FT. DEC., 1954
Vert. 1 IN. = 4 FT.

C. E. ANDERSON
ASSOCIATES
Civil Engineers Land Surveyors
Land Planning Consultants
Springfield - Massachusetts

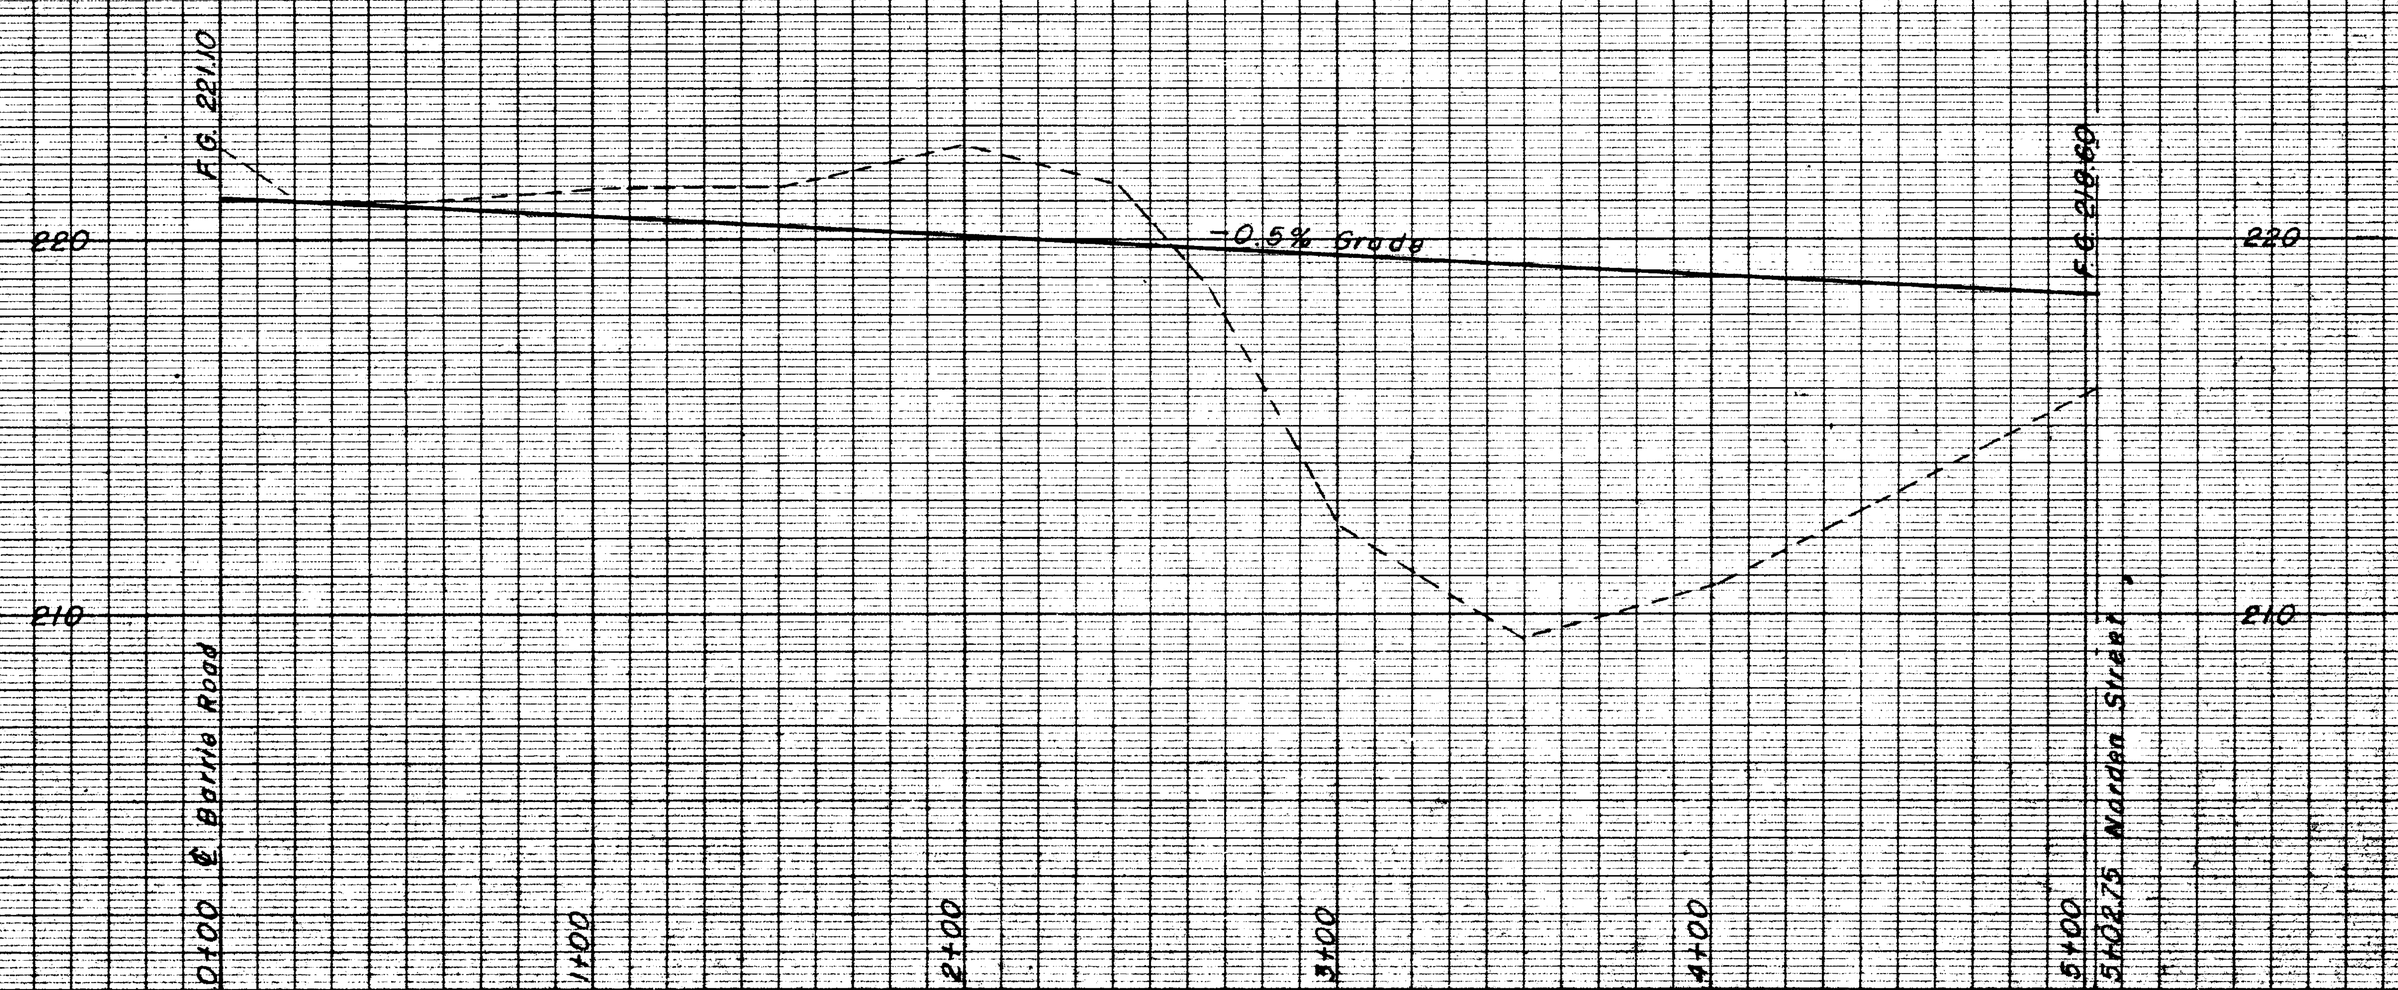

PLAN Nº 587-13

PRINTED IN U.S.A.
ON CLOTH MADE IN U.S.A.
"PERFECT" PROFILE PLATE
EUGENE DIETZGEN CO.

SUSAN STREET PLAN & PROFILE

W 2188